


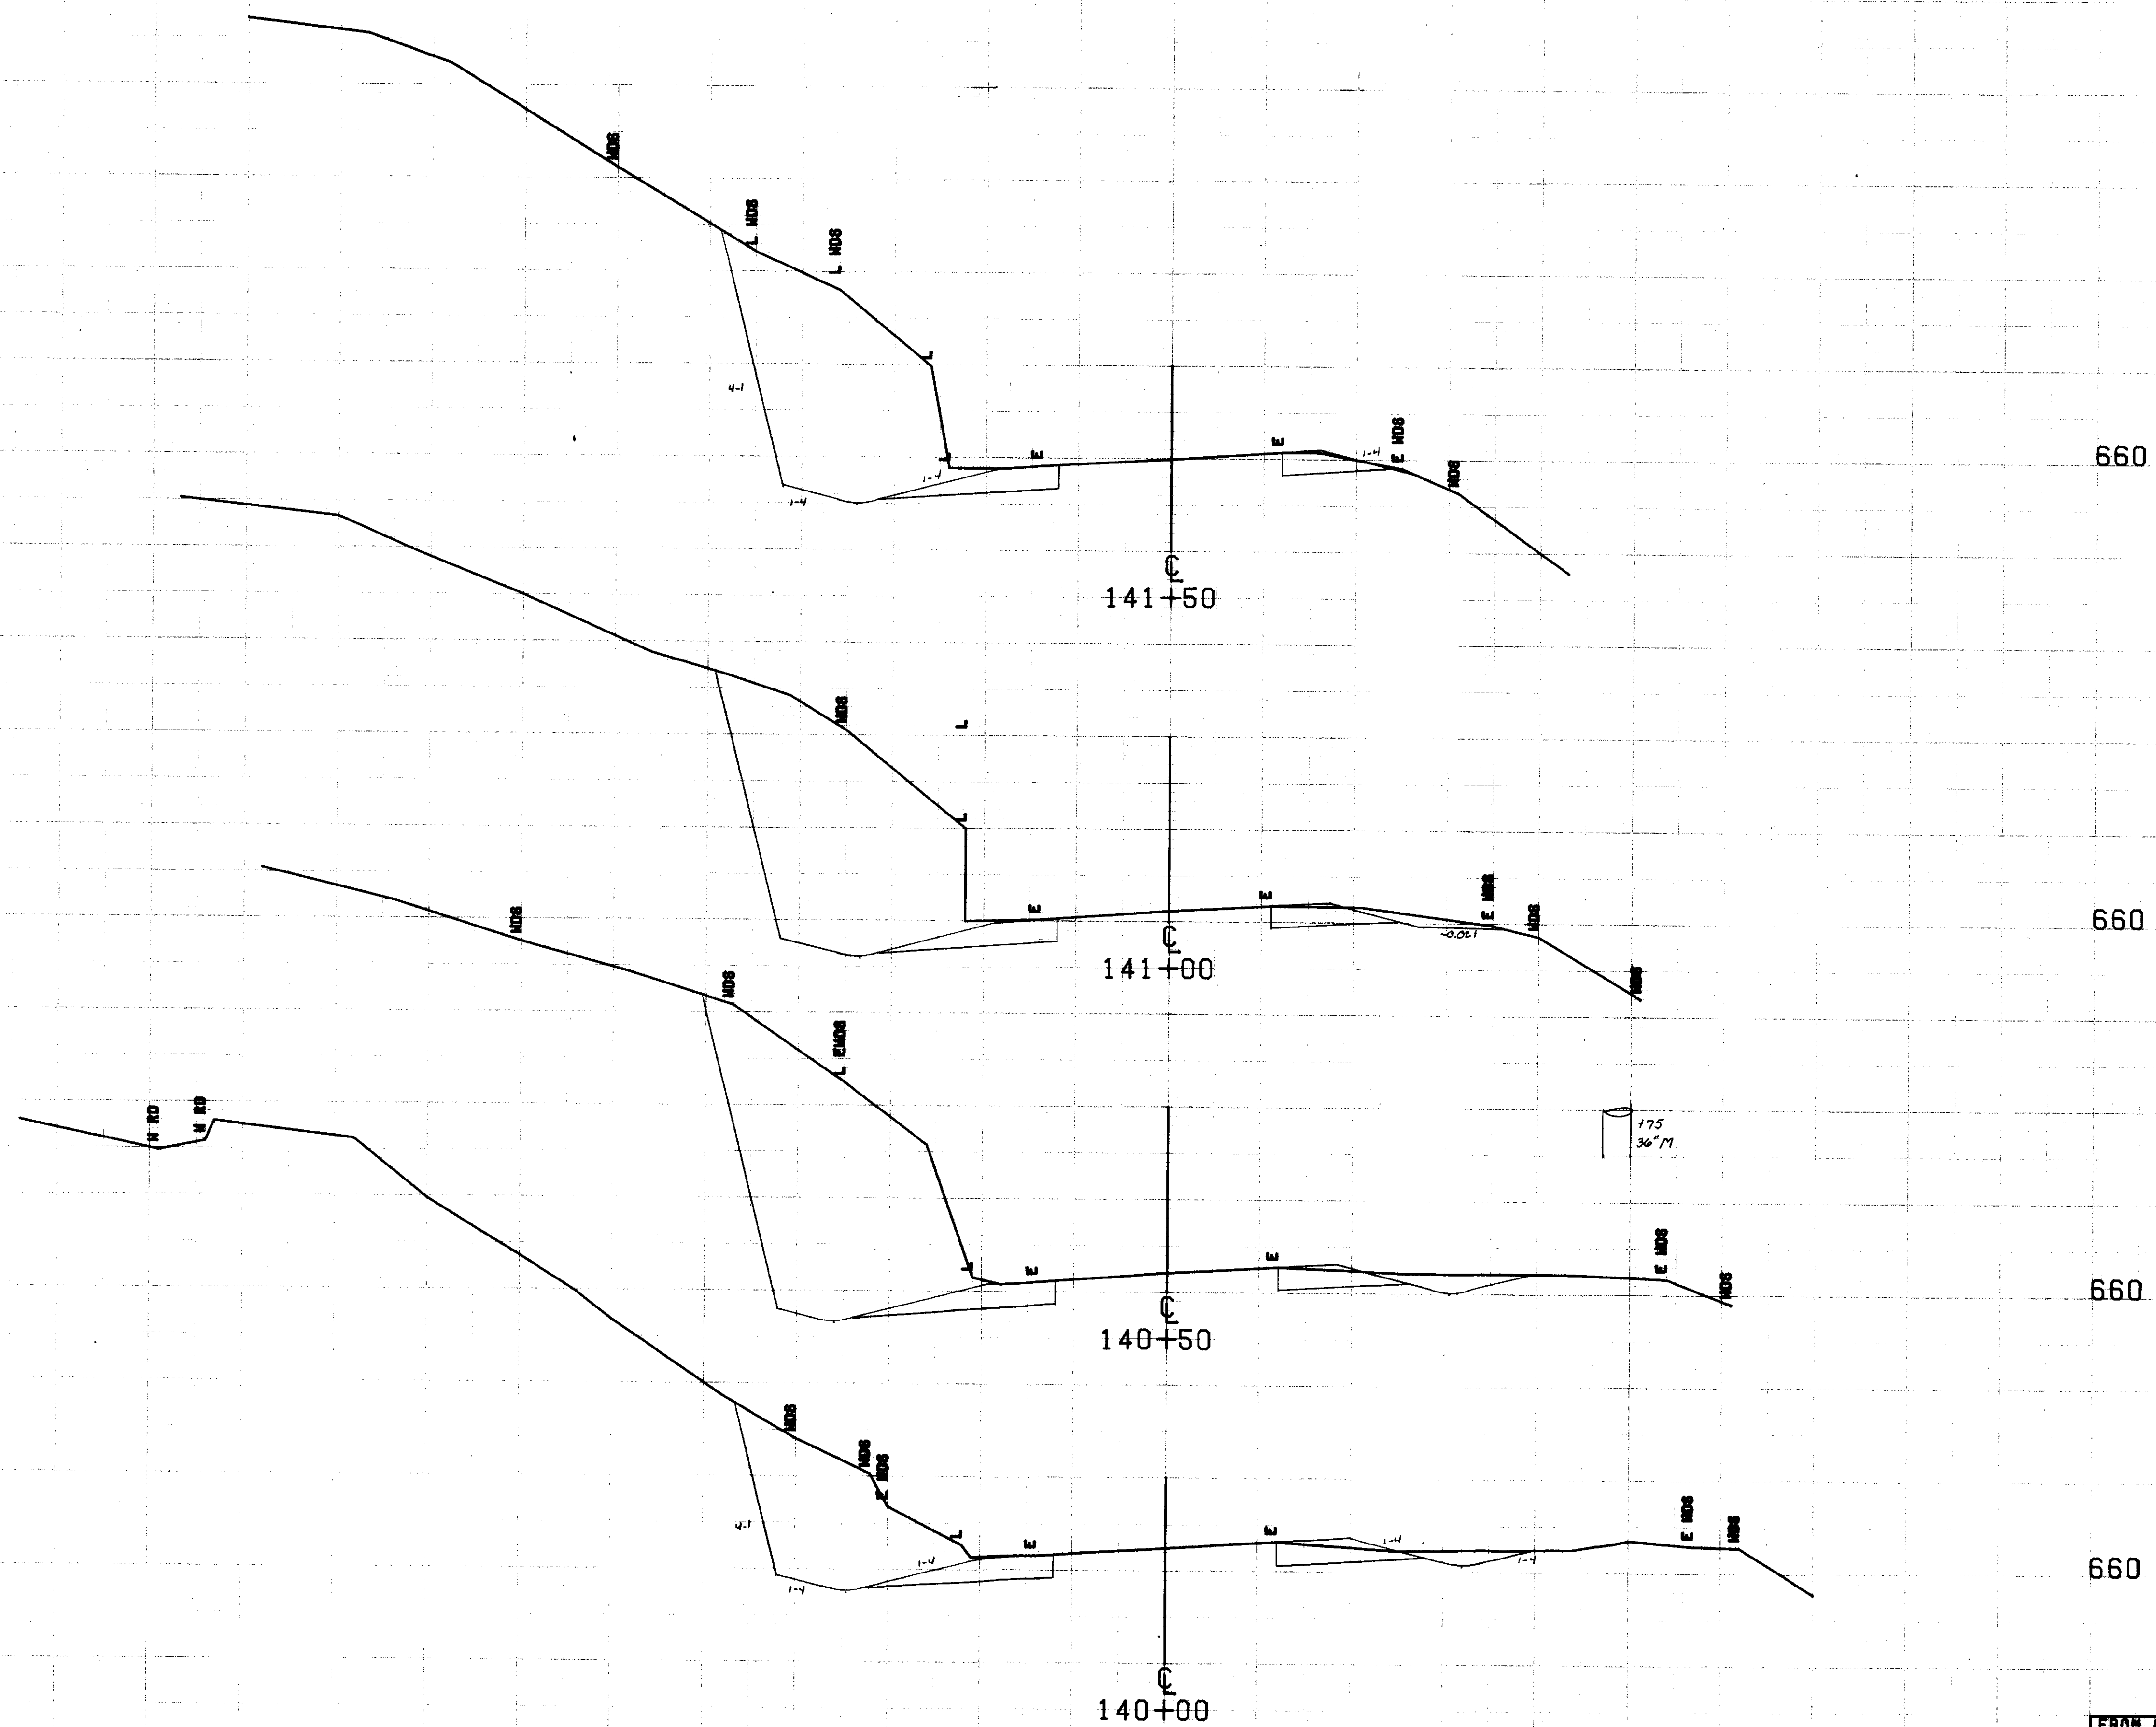

FROM STA. 140+00	TO STA. 141+50
PROJECT NAME	WALLINGFORD
NO.	R80137(6)
SURVEYED BY	DAVIS
SHEET OF	8 SHEETS
	PLOTTED 10/06/80
	02/80