


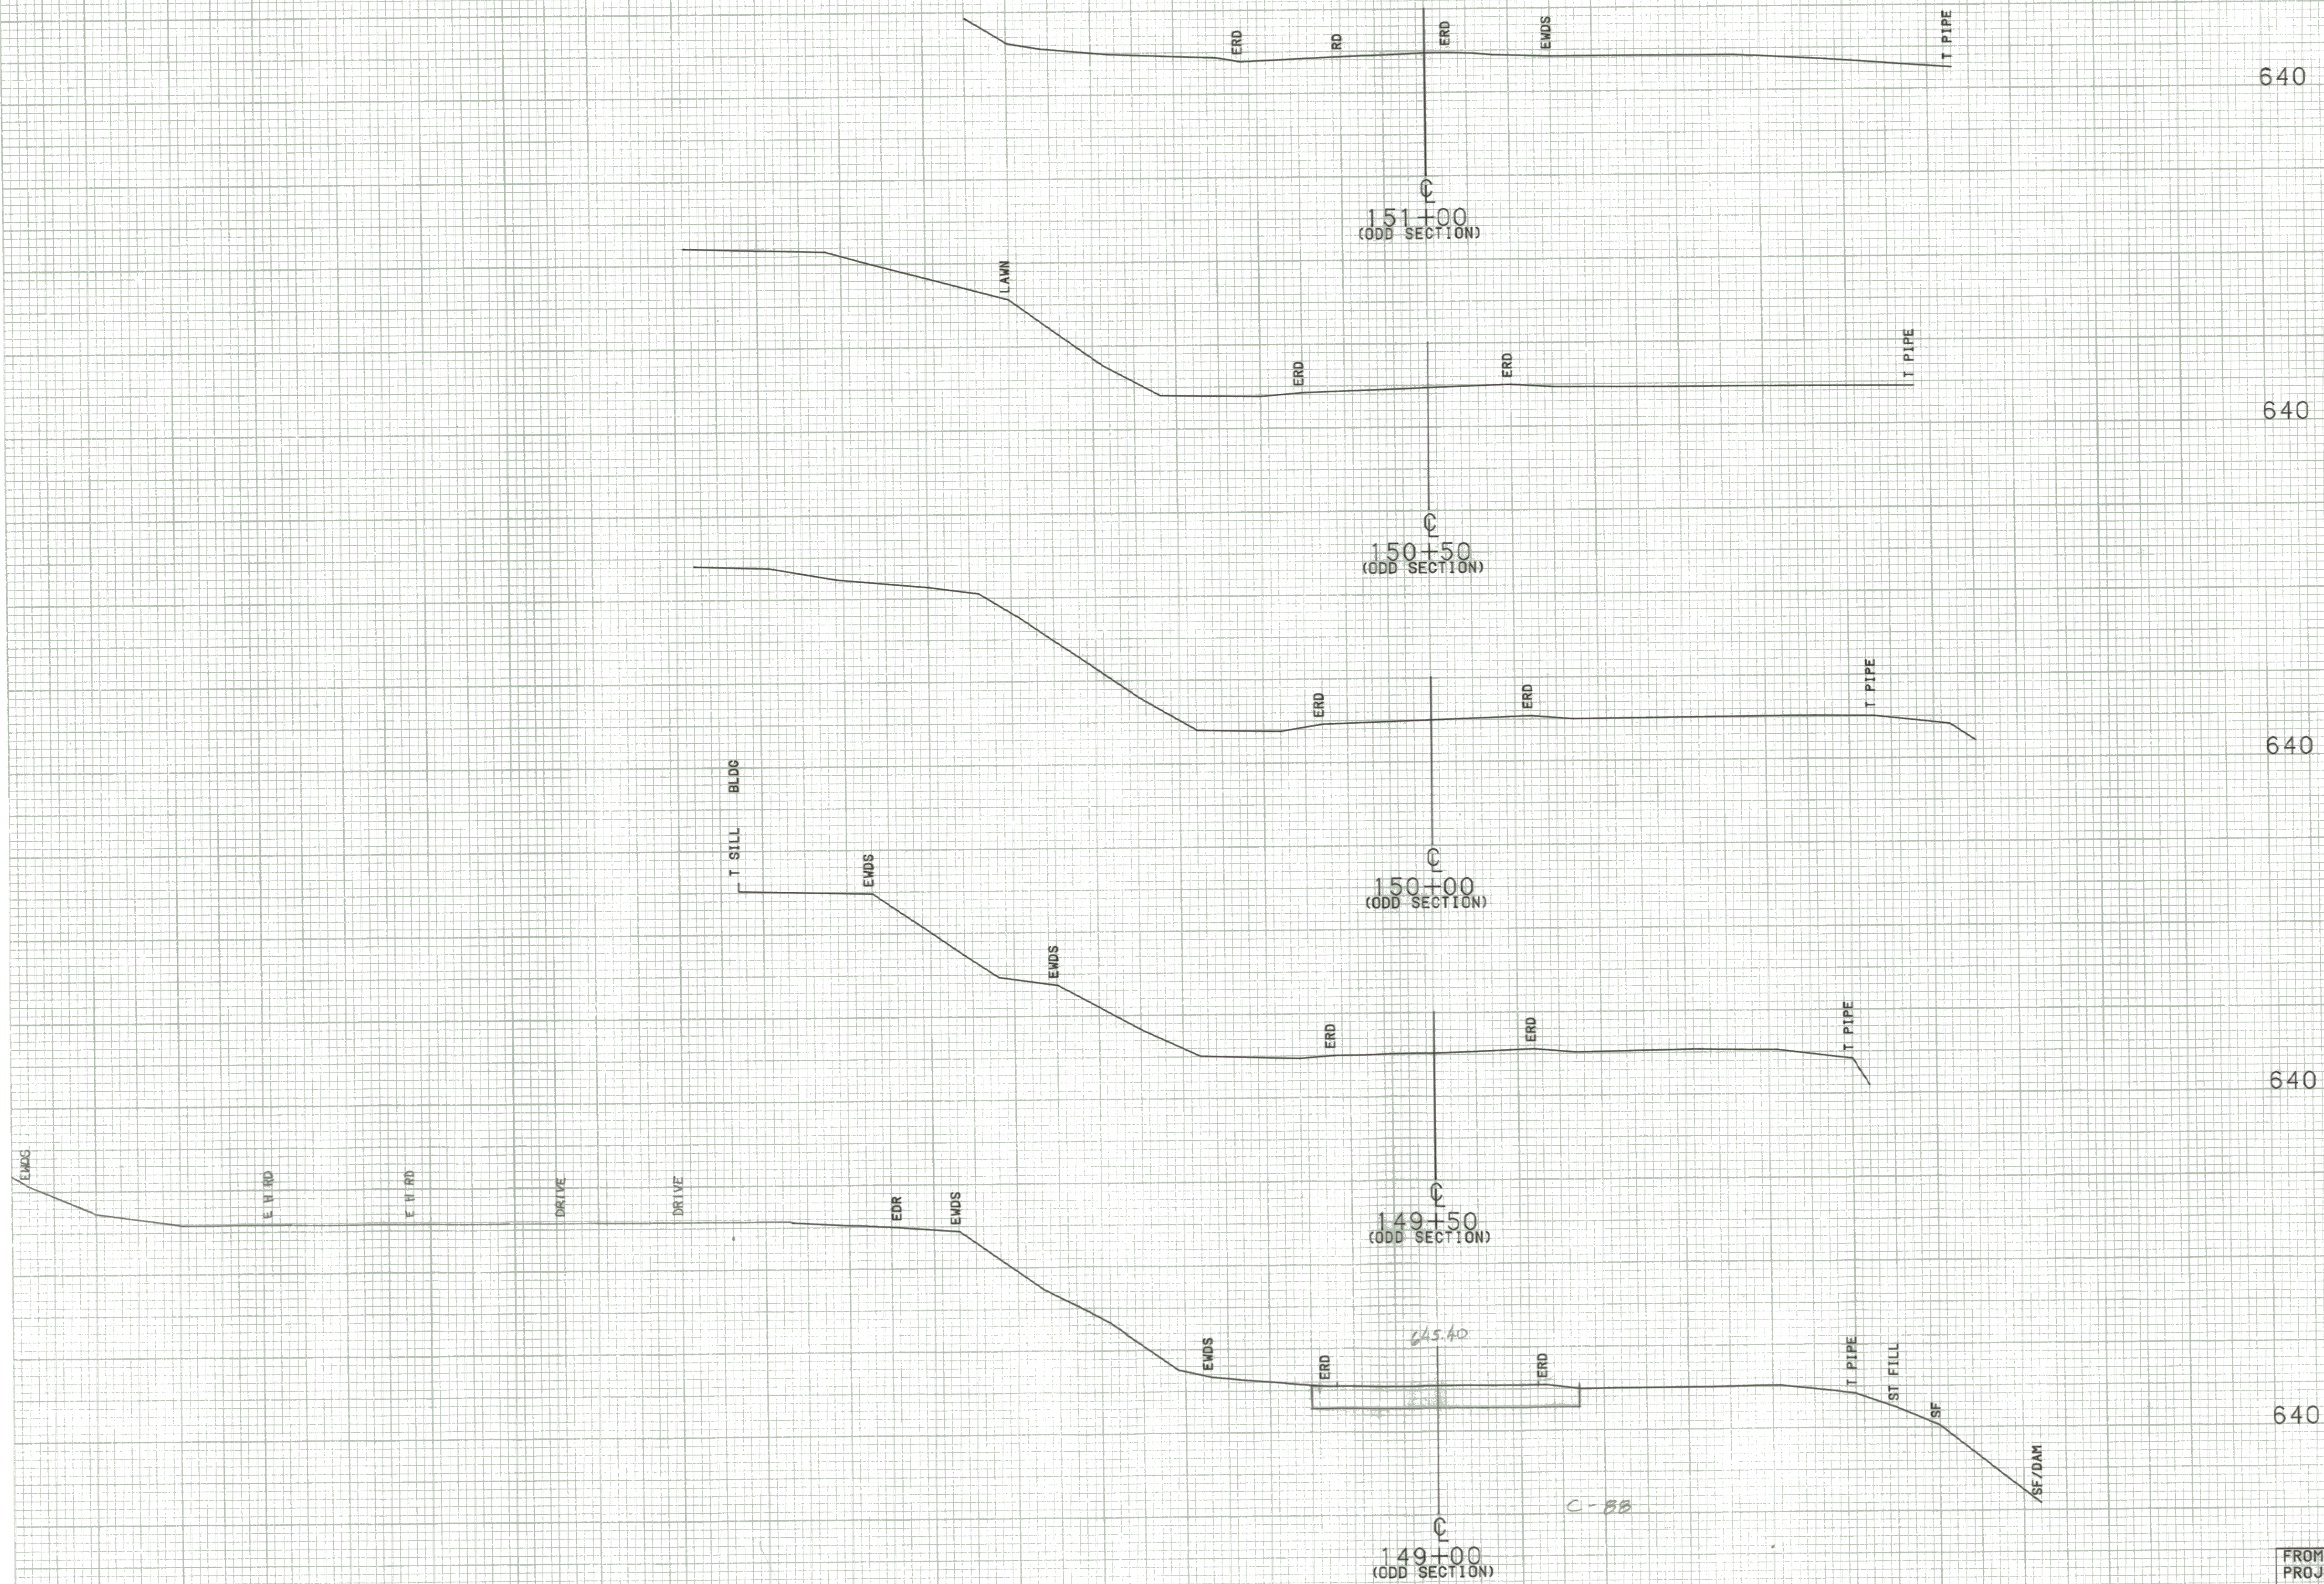

SCALE 1" = 10 FEET

|                  |                  |
|------------------|------------------|
| FROM STA. 149+00 | TO STA. 151+00   |
| PROJECT NAME     | WALLINGFORD      |
| NO.              | RS0137-5         |
| SURVEYED BY      | FANTONI          |
| SHEET OF         | SHEETS           |
|                  | PLOTTED 11/13/85 |
|                  | MAY - 85         |