


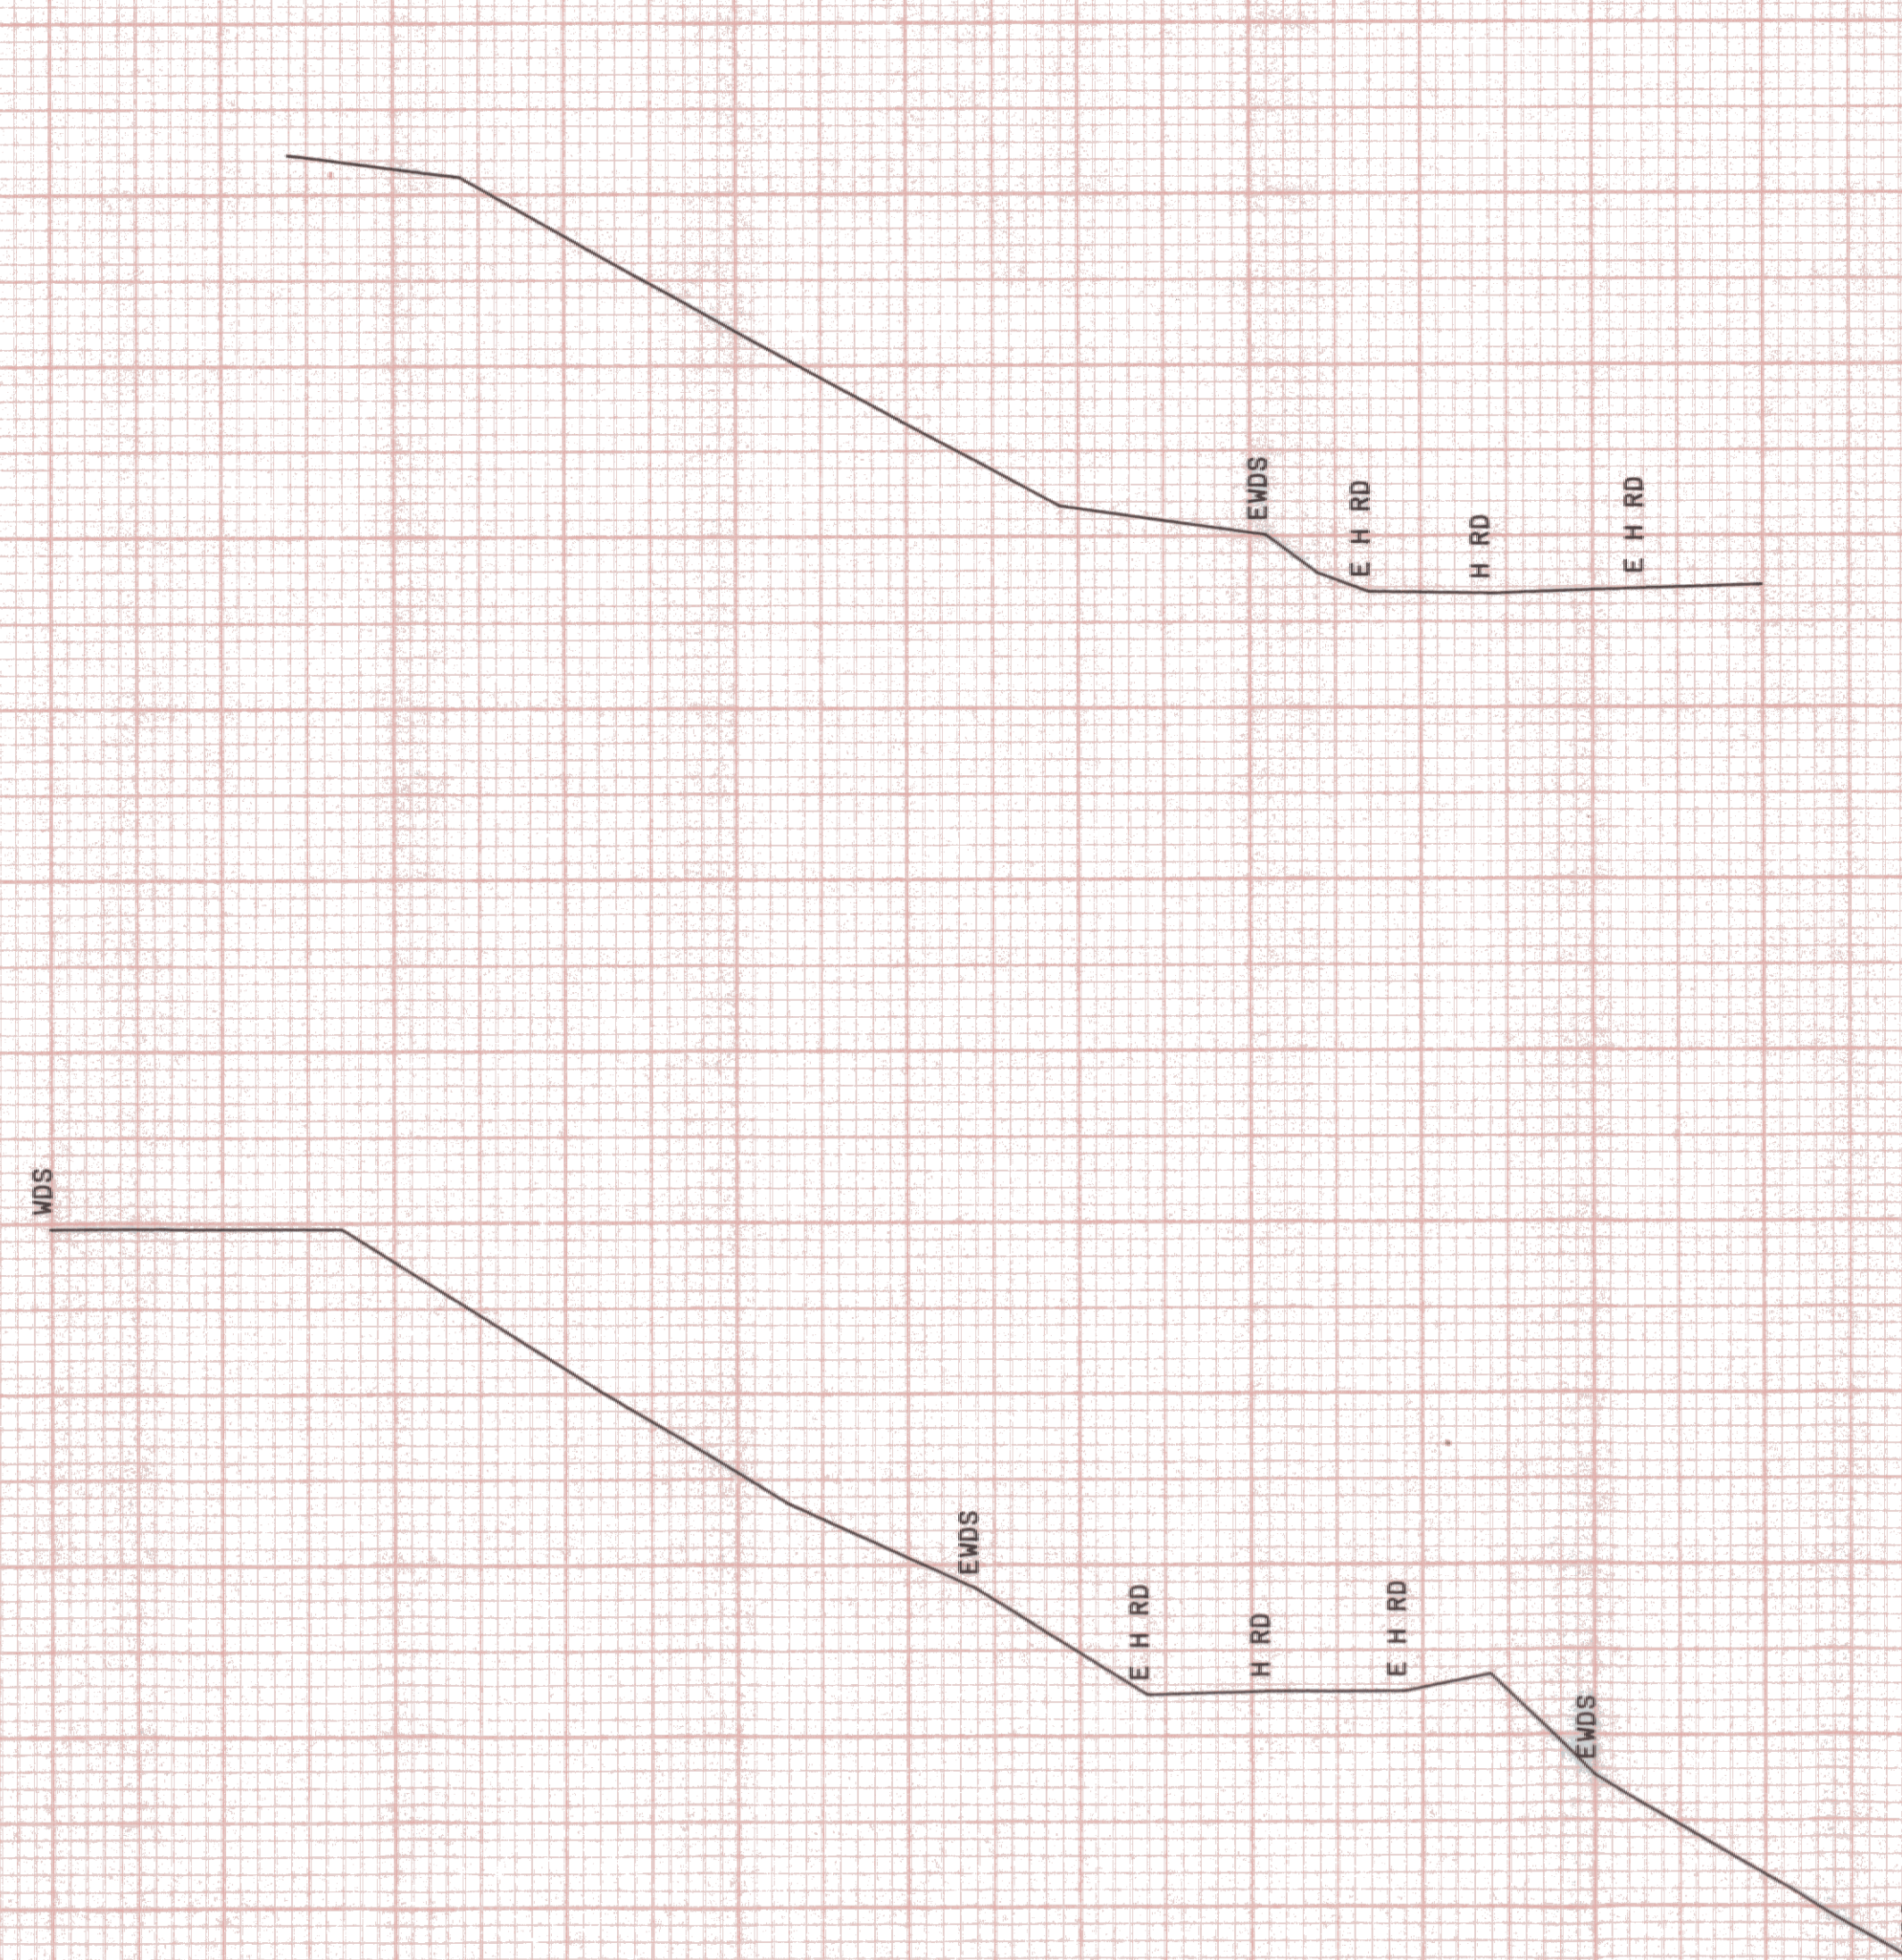

700
139+50

680
139+00

FROM STA.	139+00	TO STA.	139+50
PROJECT NAME	WALLINGFORD	EXT	
NO.	RS0137(5)	PLOTTED	05/14/86
SURVEYED BY	GILMAN	APRIL	1986
SHEET	OF	SHEETS	

SCALE 10 FEET