


680  
 145+00

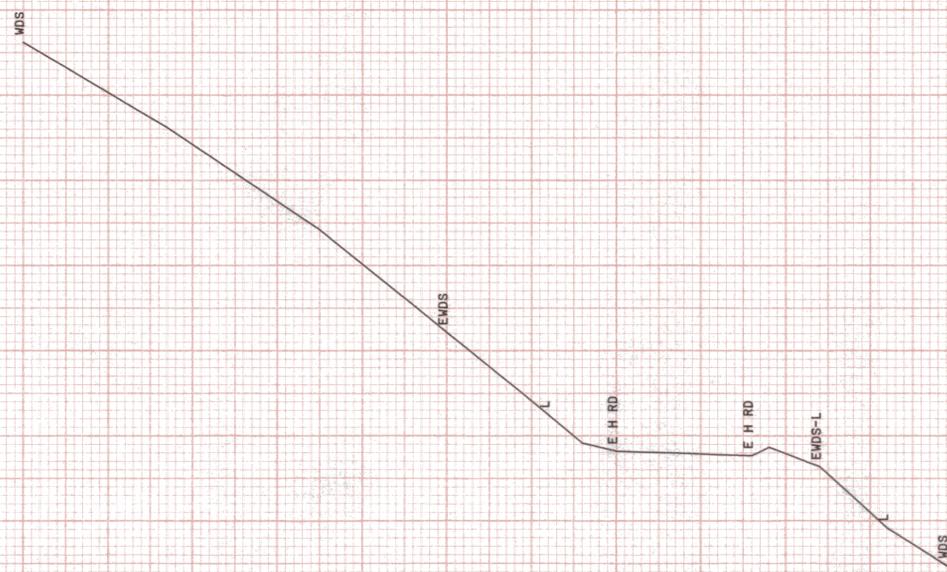

680  
 144+50

|              |                 |                  |        |
|--------------|-----------------|------------------|--------|
| FROM STA.    | 144+50          | TO STA.          | 145+00 |
| PROJECT NAME | WALLINGFORD EXT |                  |        |
| NO.          | RS0137 (5)      | PLOTTED 05/14/86 |        |
| SURVEYED BY  | GILMAN          | APRIL 1986       |        |
| SHEET        | OF              | SHEETS           |        |

SCALE 1" = 10 FEET