
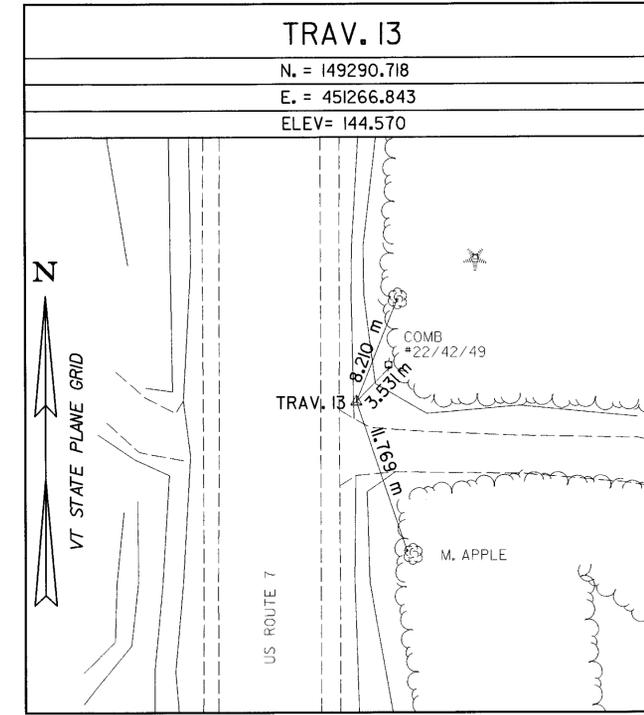
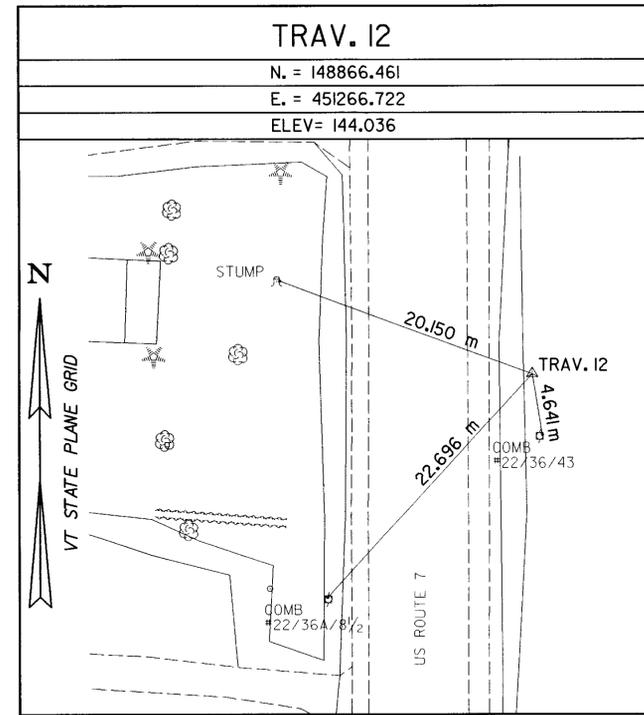
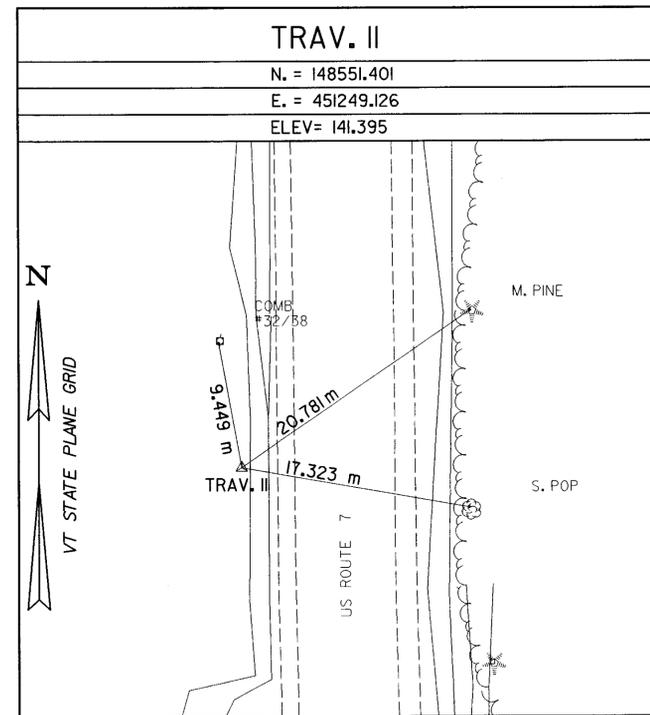
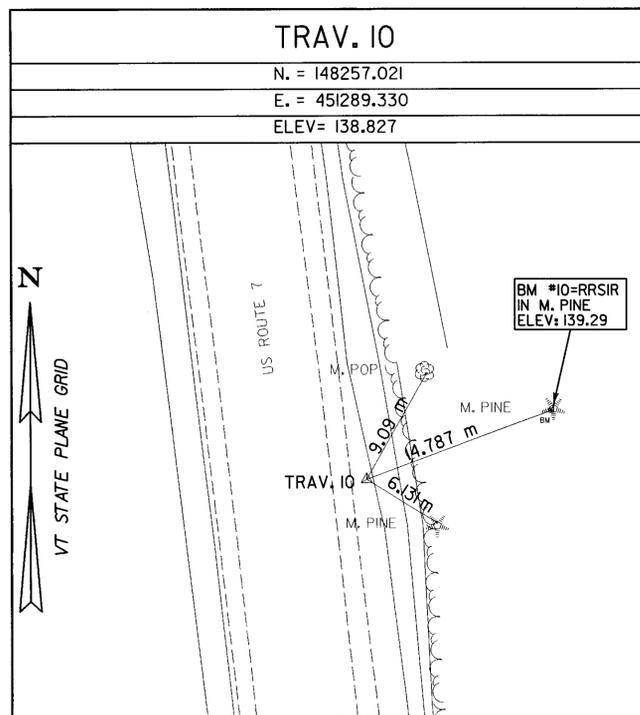
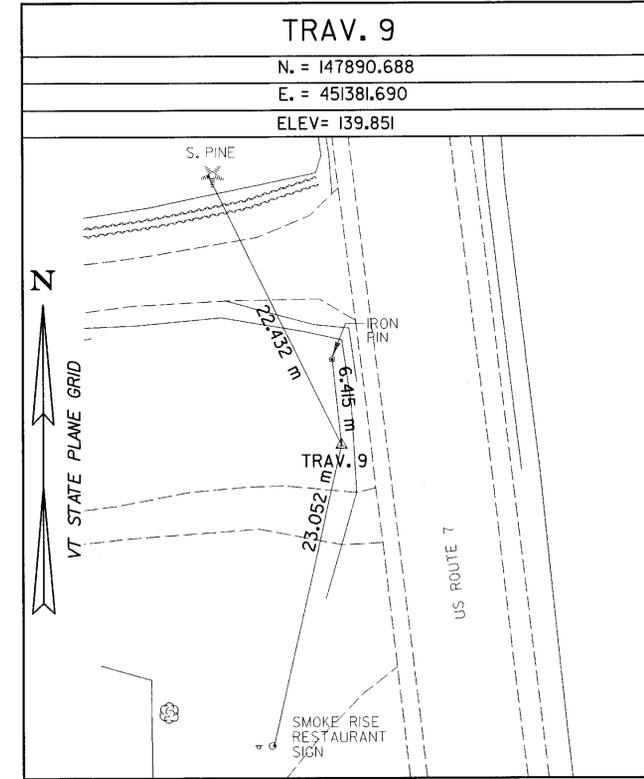
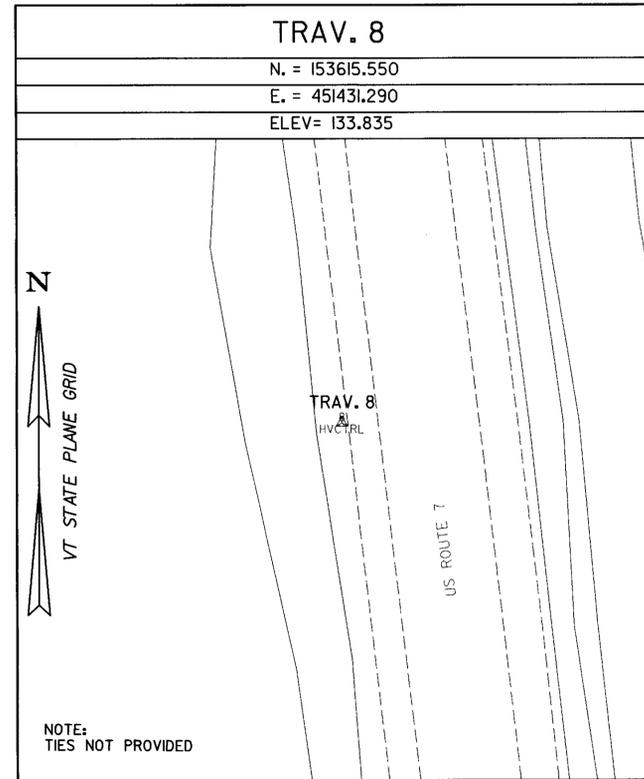
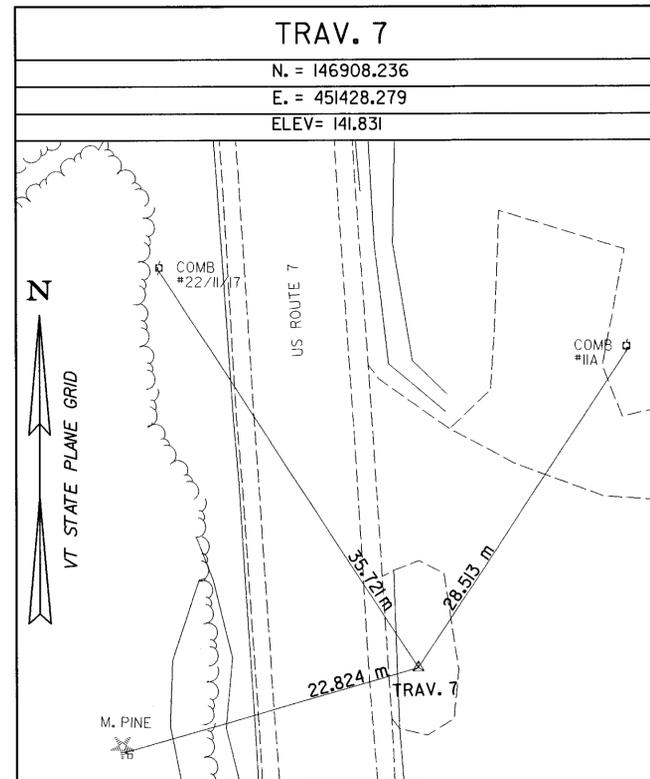


TRAVERSE TIES (SEGMENT 1)

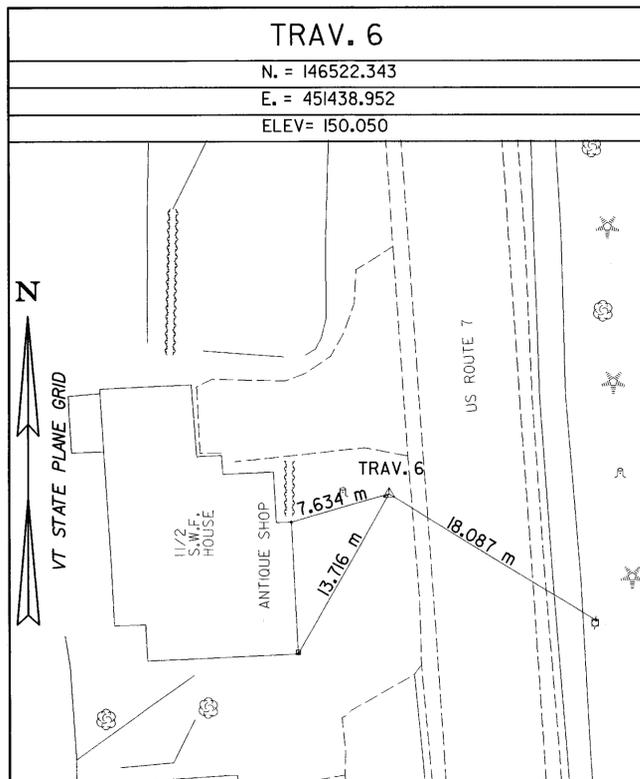

**DATUM**

VERTICAL	NAVD 88
HORIZONTAL	NAD 83

PROJECT:	BRANDON-LEICESTER	PROJECT NO.:	FEGC F 019-3 (29)
DESIGN FILE NAME:	d:\out\Brandon-Leicester_VT7\Survey\Sheet\xd051travl.dgn	PLOT DATE:	07/19/2002
IPARM FILE NAME:		SURVEY DATE:	06-29-2000
SURVEYED BY:	VAOT	DRAWN BY:	
SQUAD LEADER:	L. ORVIS P.C.	SHEET:	OF 94