

TRAVERSE TIES (SEGMENT 2)

GEODETIC CONTROL POINTS

TT 40 C AZ MK (NOT SHOWN)








N = 150937.184
E = 451280.360
Z = 151.660

GENERAL LOCATION: LEICESTER, VT. OWNERSHIP: CHURCH OF THE NAZARENE, 39 WINDY KNOLL LANE, LEICESTER, VT 05733. TO REACH FROM THE INTERSECTION OF US ROUTE 7 AND VT ROUTE 73 WEST AT THE NORTH END OF BRANDON VILLAGE, GO NORTH ALONG US ROUTE 7 FOR 6.4 KM (4.0 MI) TO THE INTERSECTION OF WINDY KNOLL LANE RIGHT AND SITE OF THE MARK. THE MARK IS SET FLUSH WITH THE GROUND SURFACE IN THE TOP OF A BOULDER EMBEDDED IN THE GROUND. THE MARK IS 18.4 M (60.4 FT) EAST OF AND 1.0 M (3.3 FT) HIGHER THAN THE CENTERLINE OF US ROUTE 7, 12.1 M (39.7 FT) SOUTH OF THE CENTERLINE OF WINDY KNOLL LANE, 7.5 M (24.6 FT) WEST OF A 40 CM MAPLE, 9.4 M (30.8 FT) SOUTHEAST OF POLE NO. 22/65/72 AND A FIBERGLASS WITNESS POST.

TT 40 C 448 1942 (NOT SHOWN)

N = 151889.948
E = 451151.807
Z = 136.334

GENERAL LOCATION: LEICESTER, VT. 1.2 M (4 FT) SOUTH AND 16.5 M (54 FT) WEST OF CENTERLINE OF CROSSROADS, IN NORTH CORNER OF CONCRETE DRAIN BASIN.

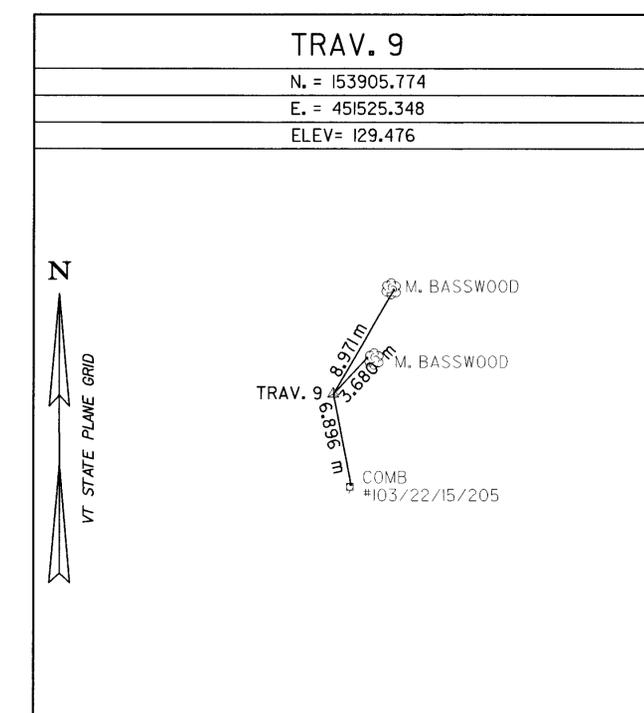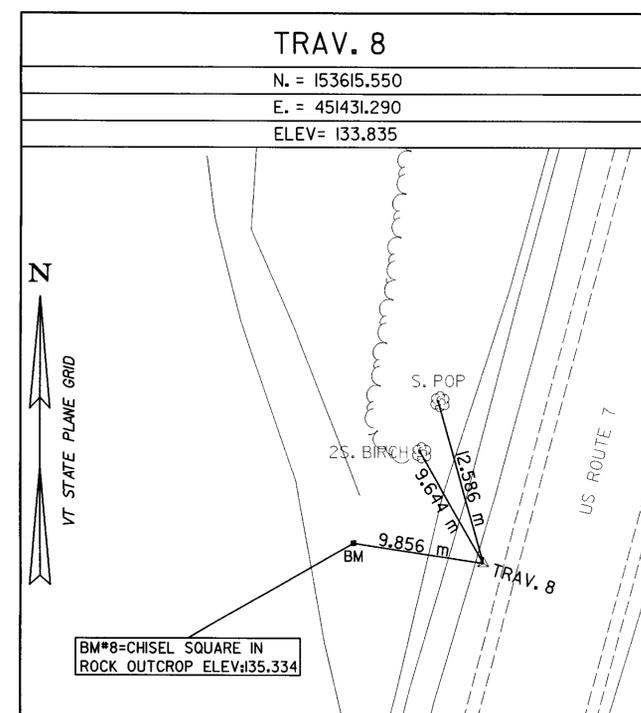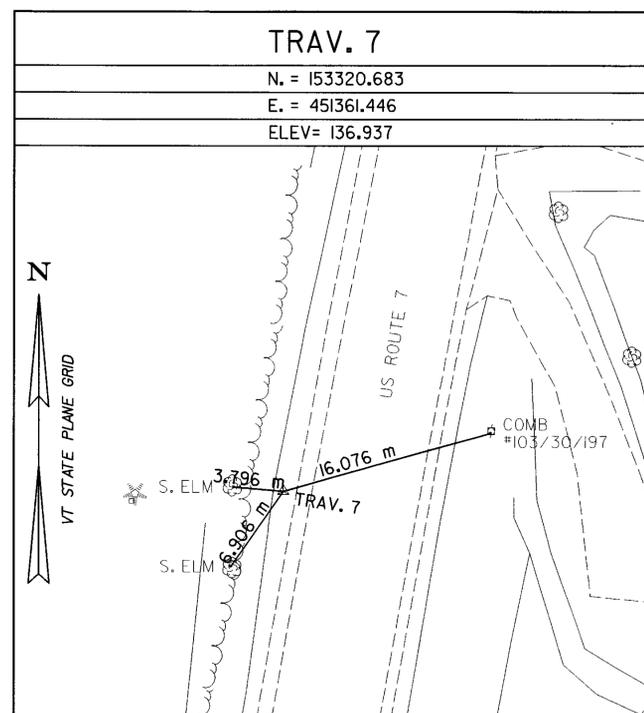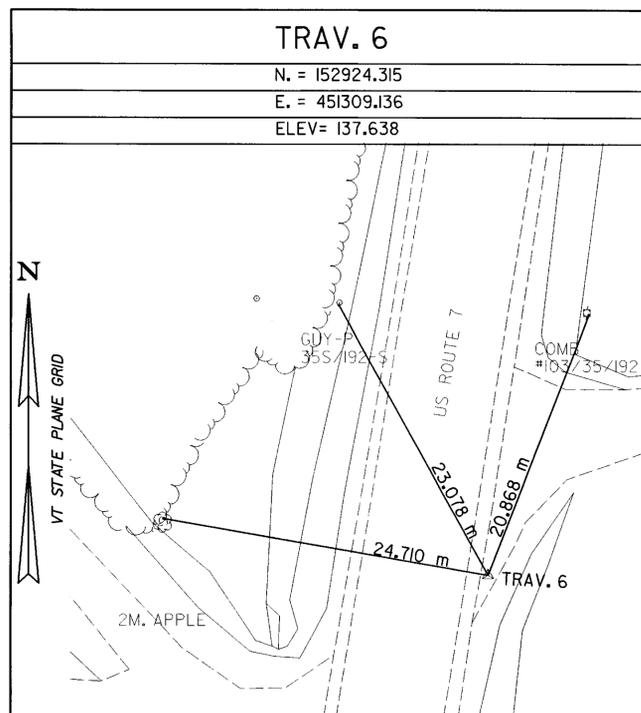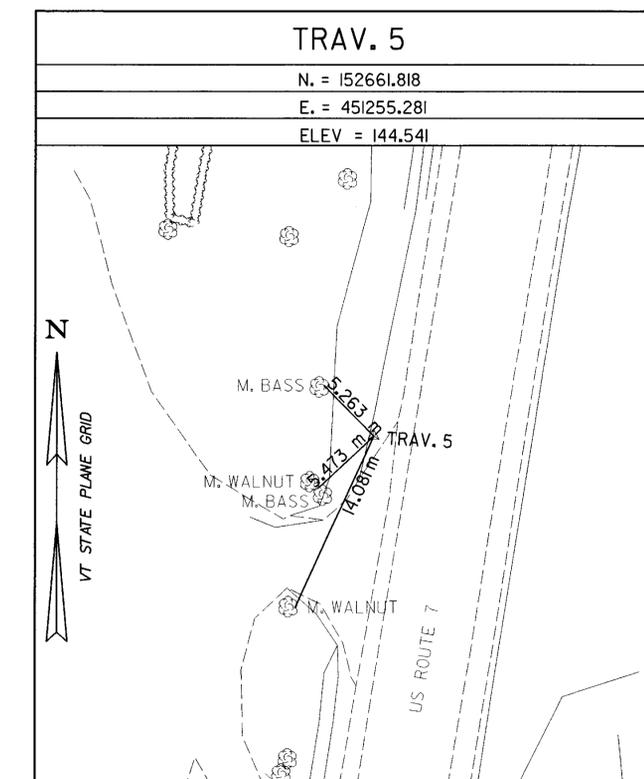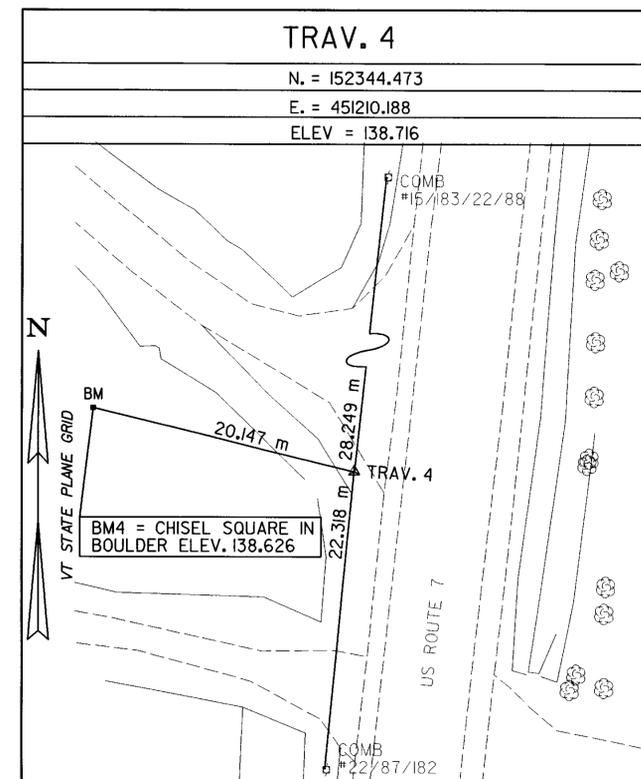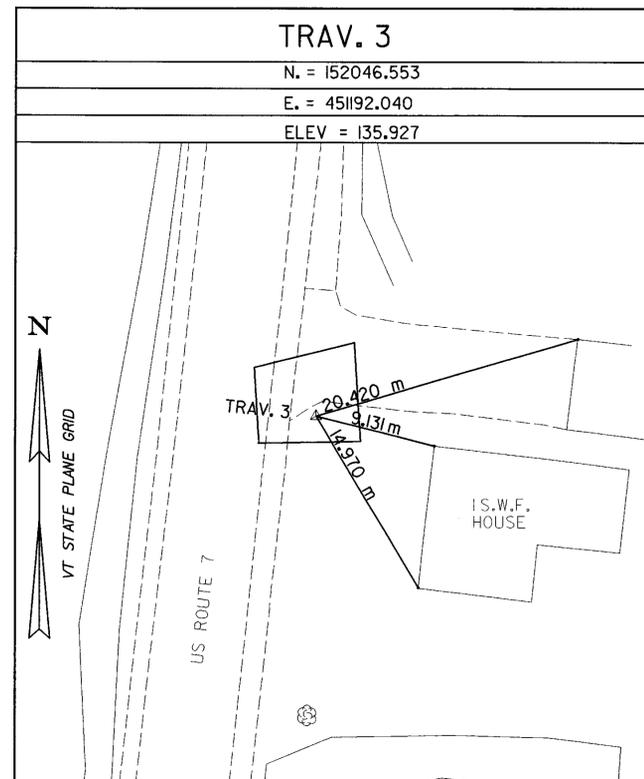

DATUM	
VERTICAL	NAVD 88
HORIZONTAL	NAD 83

PROJECT: BRANDON-LEICESTER	PROJECT NO.: FEGC F 019-3 (29)
DESIGN FILE NAME: d:\out\Brandon-Leicester, VT\Survey\Sheet\xd051trav2.dgn	PLOT DATE: 07/19/2002
IPARM FILE NAME:	SURVEYED BY: VAOT
SQUAD LEADER: L. ORVIS P.C.	DRAWN BY:
	SHEET: OF 94