


FOR CONTINUATION
OF PROFILE SEE
SHEET 37 OF 92

DATUM
VERTICAL NAVD 88
HORIZONTAL NAD 83

US ROUTE 7 PROFILE (SOUTHERN SEGMENT)

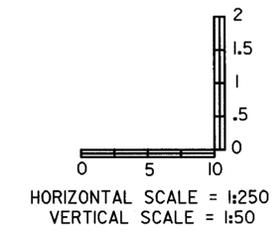

PROJECT: BRANDON-LEICESTER	PROJECT NO.: FEGC F 019-3 (29)
DESIGN FILE NAME: p:\Civil\Sheet\Profiles\zb051prsh+3segl.dgn	PLOT DATE: 07/19/2002
IPARM FILE NAME:	SURVEY DATE: 06-29-2000
SURVEYED BY: VAOT	DRAWN BY: R.ROSS
SQUAD LEADER: L. ORVIS P.C.	SHEET: 36 OF 92