
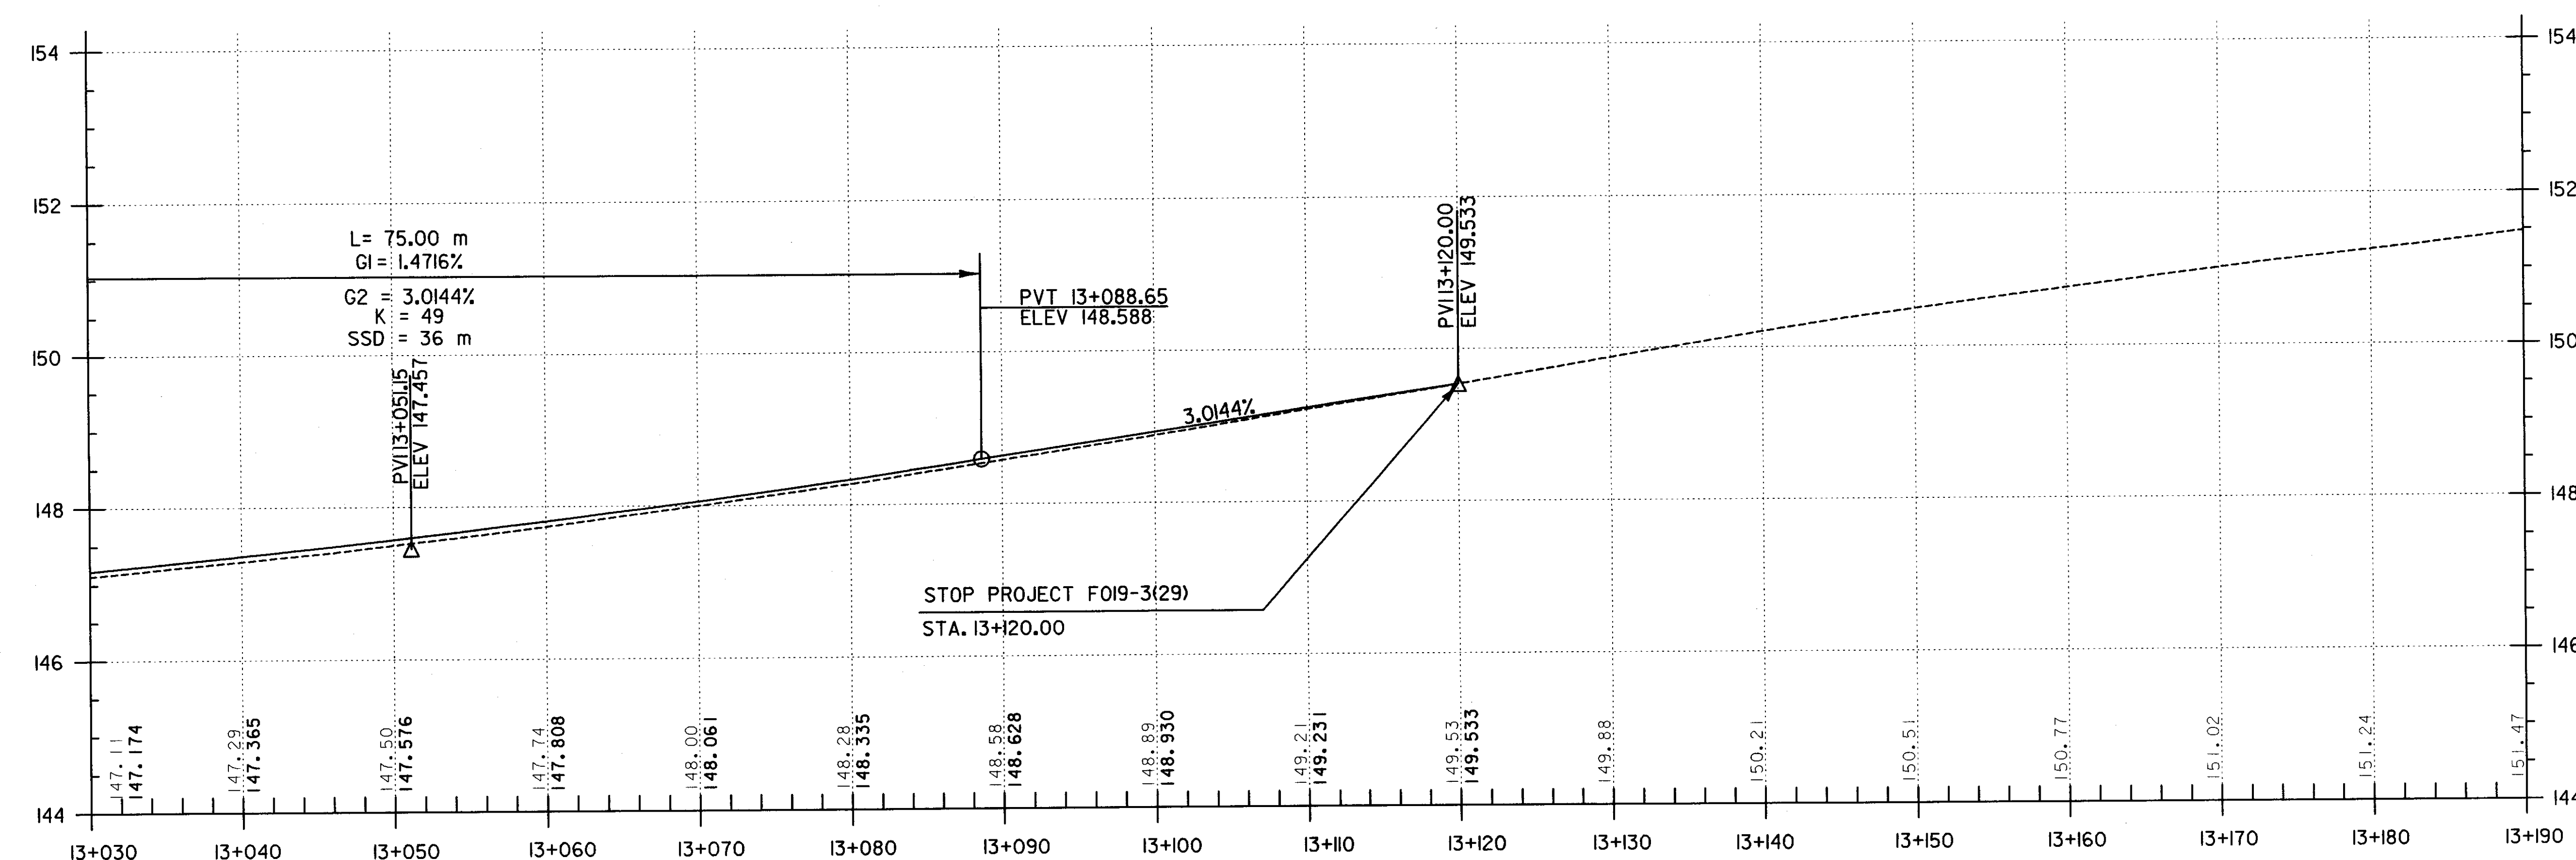


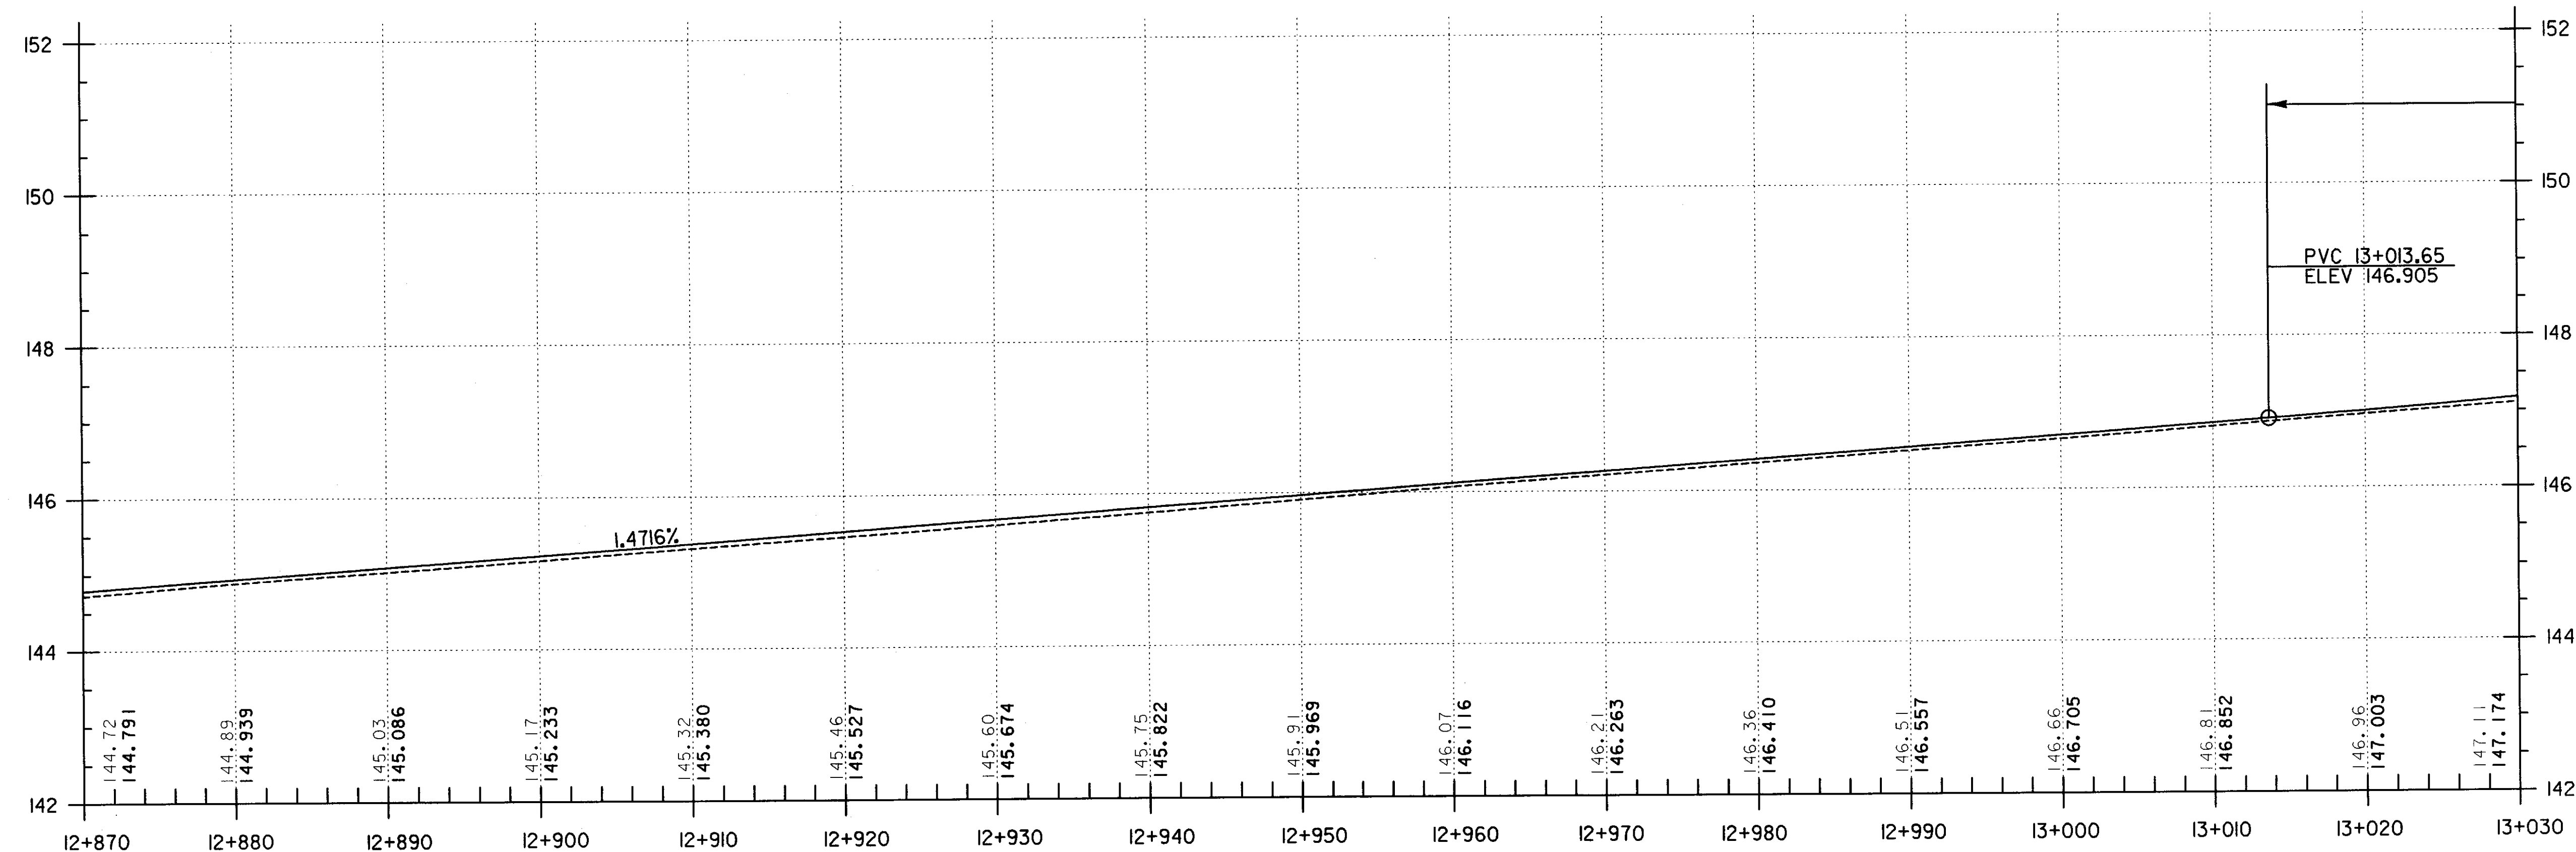

FOR CONTINUATION
OF PROJECT SEE
SHEET 45 OF 76

DATUM
VERTICAL NAVD 88
HORIZONTAL NAD 83

US ROUTE 7 PROFILE (SOUTHERN SEGMENT)

HORIZONTAL SCALE = 1:250
VERTICAL SCALE = 1:50

PROJECT: BRANDON-LEICESTER	PROJECT NO.: FEGC F 019-3 (29)
DESIGN FILE NAME: p:\CIVIL\Sheet\Profiles\zb05\prsh10segl.dgn	PLOT DATE: 07/22/2002
IPARM FILE NAME: VAOT	SURVEY DATE: 06-29-2000
SQUAD LEADER: L. ORVIS P.C.	DRAWN BY: R.ROSS
	SHEET: 43 OF 92