


FOR CONTINUATION
OF PROFILE SEE
SHEET 49 OF 92

DATUM	
VERTICAL	NAVD 88
HORIZONTAL	NAD 83

US ROUTE 7 PROFILE (NORTHERN SEGMENT)

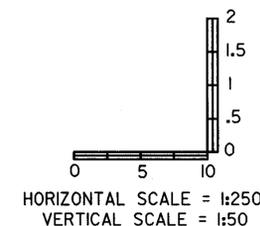

PROJECT: BRANDON-LEICESTER	PROJECT NO. : FEGC F 019-3 (29)
DESIGN FILE NAME: p:\Civil\Sheet\Profiles\zb05\prsh4seg2.dgn	PLOT DATE: 07/19/2002
IPARM FILE NAME:	SURVEY DATE: 06-29-2000
SURVEYED BY: VAOT	DRAWN BY: R.ROSS
SQUAD LEADER: L. ORVIS P.C.	SHEET: 48 OF 92