
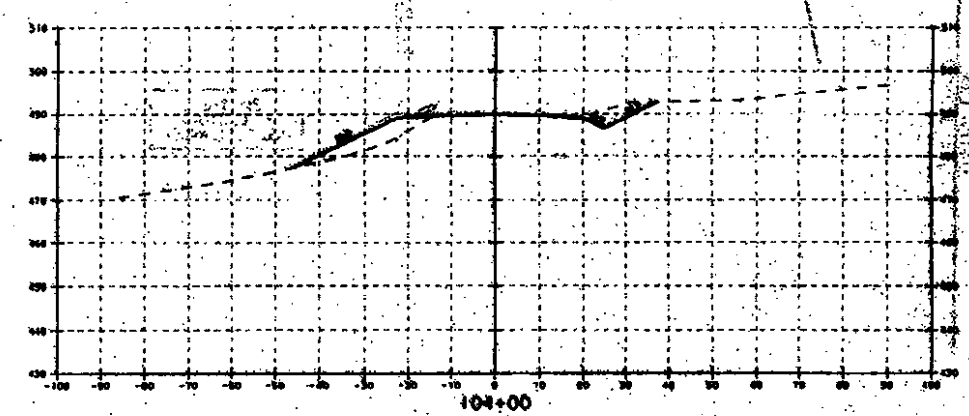
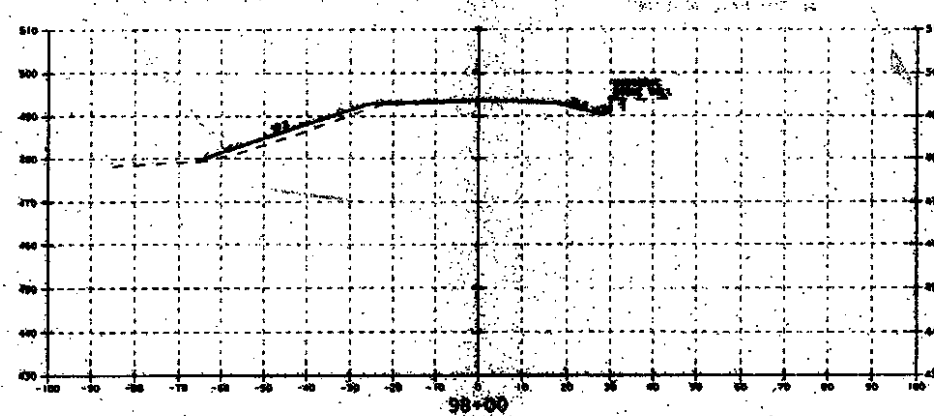
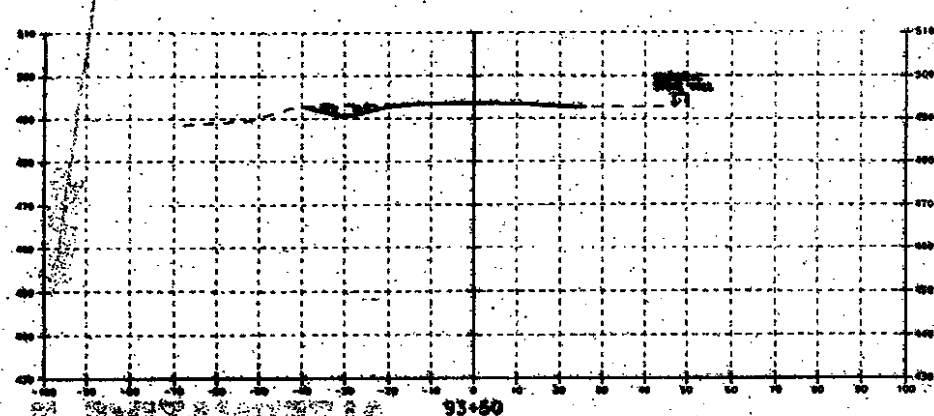
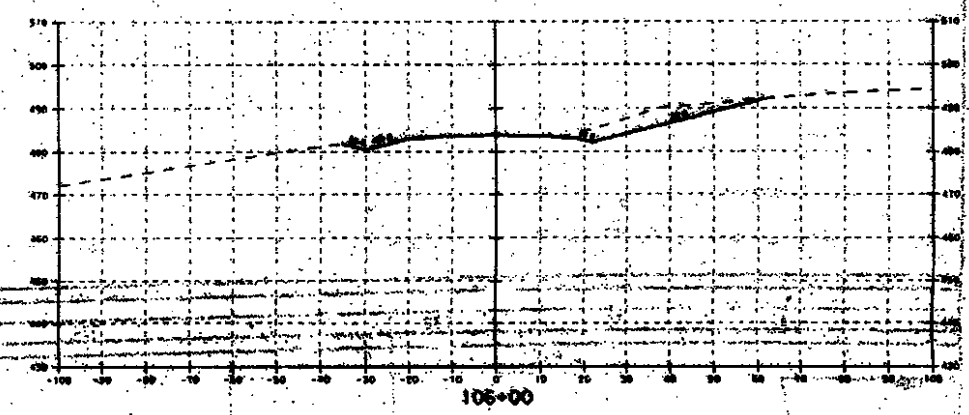
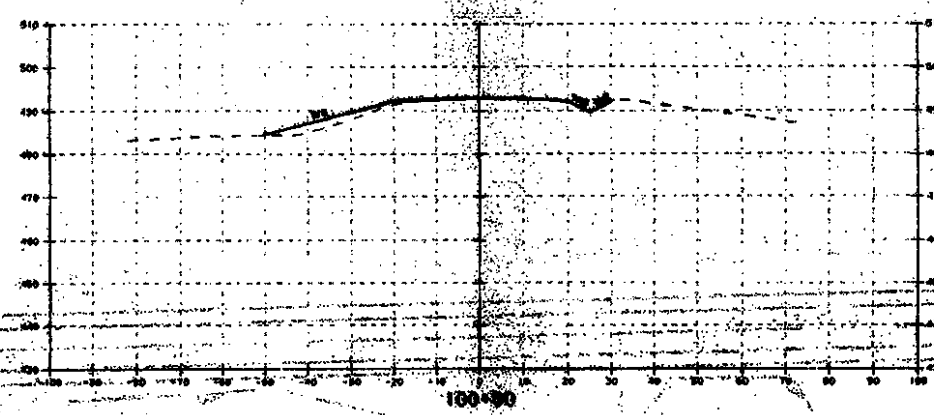
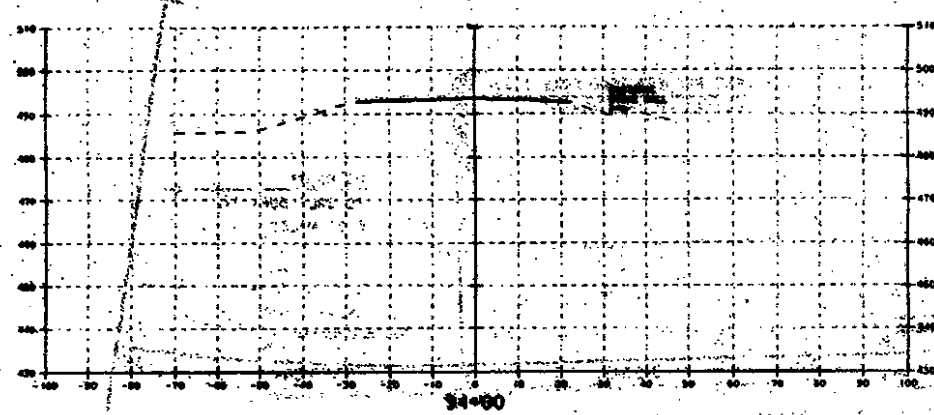
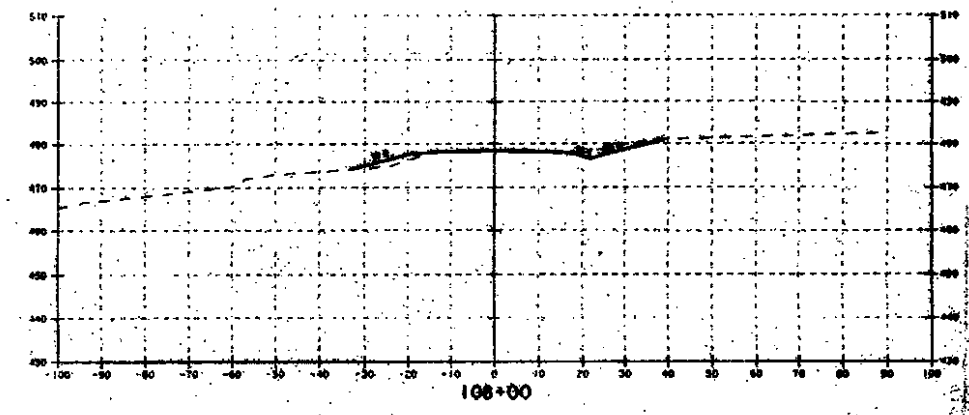
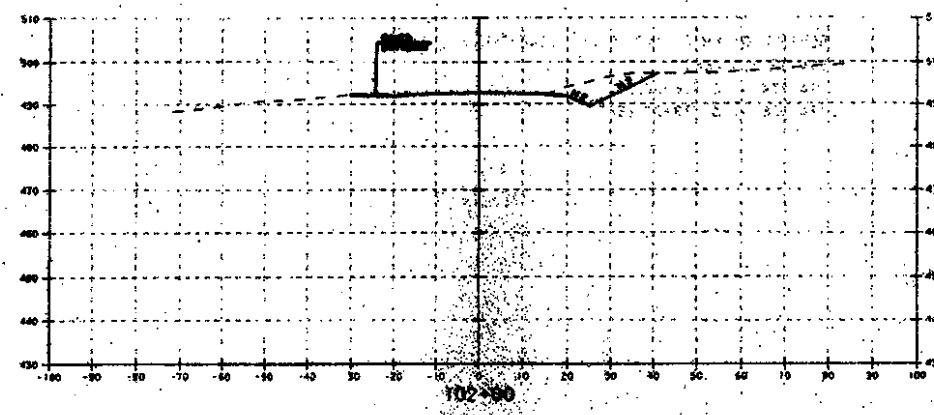


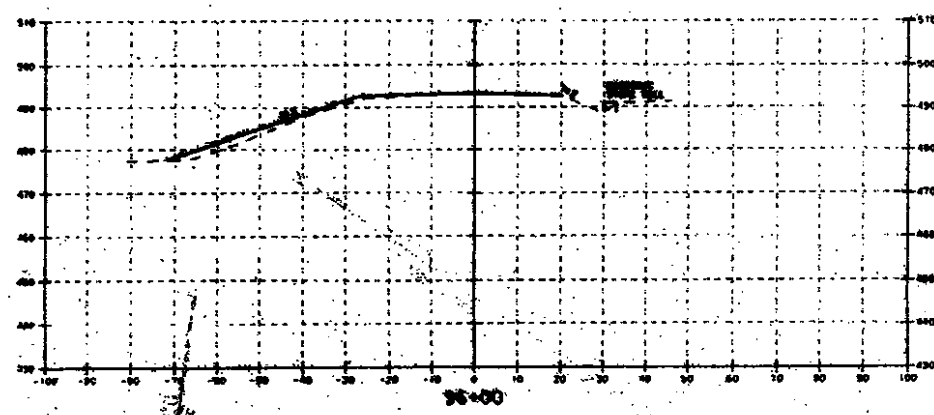

DATE: 10/1/00
 DRAWN BY: J.A. CARSO
 CHECKED BY: J.A. CARSO
 DESIGNED BY: J.A. CARSO
 PROJECT: 100-1000-1000-1000
 SHEET: 100-1000-1000-1000

SCALE: 1" = 40'-0"
 20' 0" 20' 0"

ALTERNATIVE B

SURVEYED BY: C. WOODS
 DATE: 10/1/00
 DRAWN BY: J.A. CARSO
 CHECKED BY: J.A. CARSO
 DESIGNED BY: J.A. CARSO
 PROJECT: 100-1000-1000-1000
 SHEET: 100-1000-1000-1000