
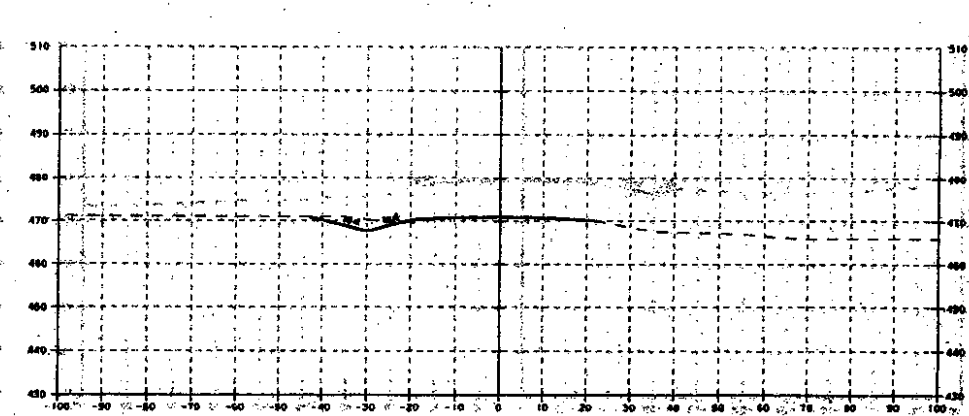
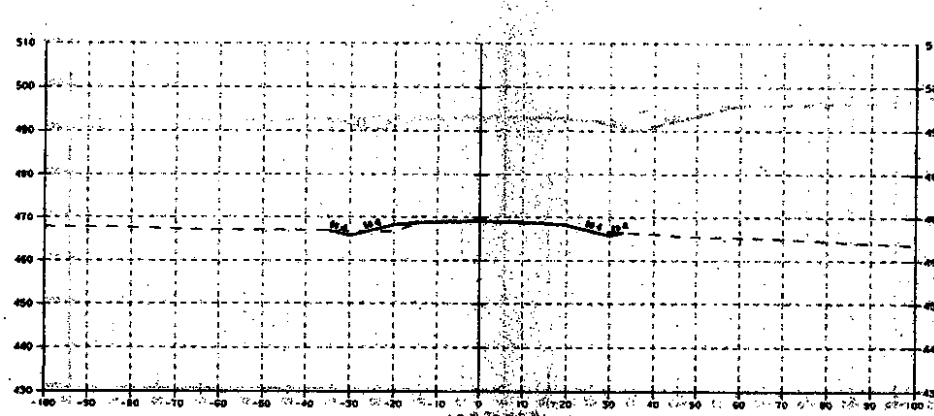
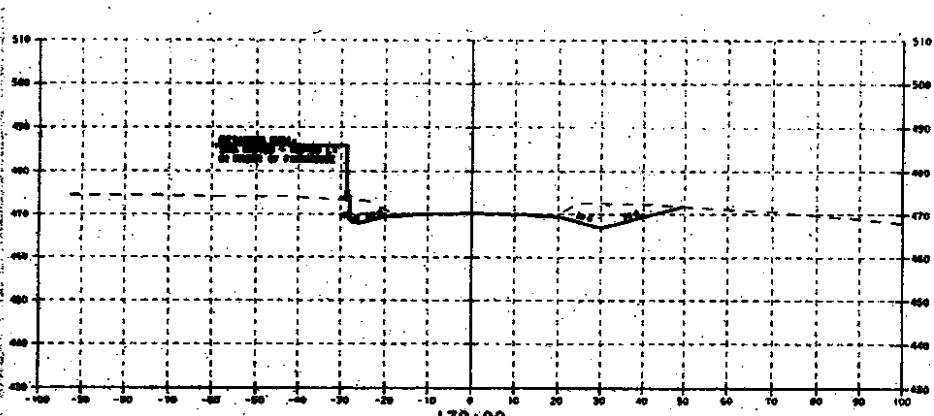
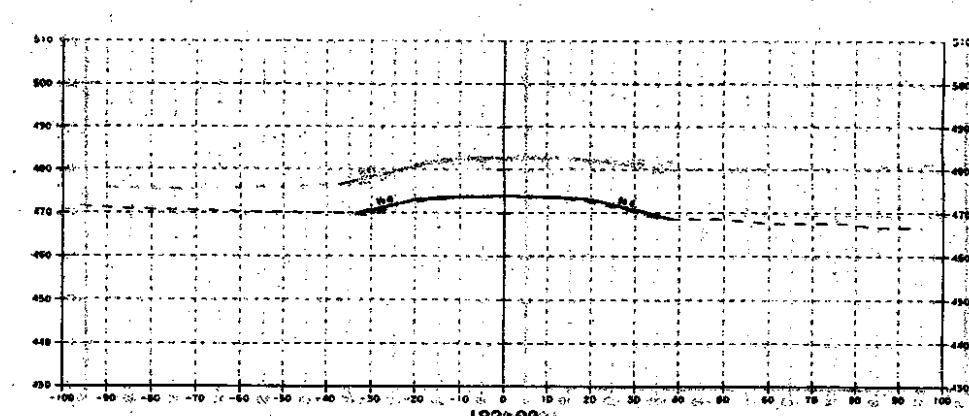
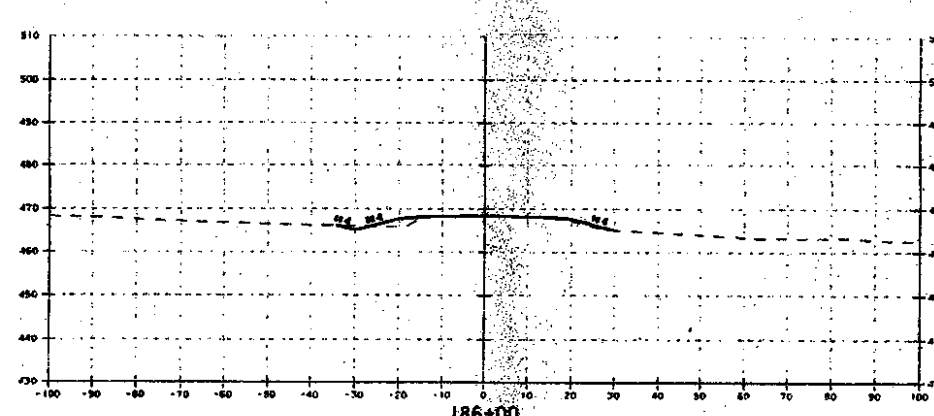
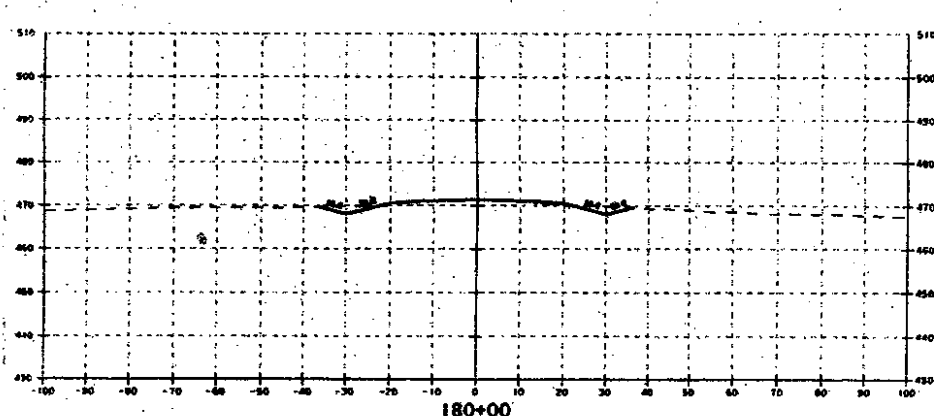
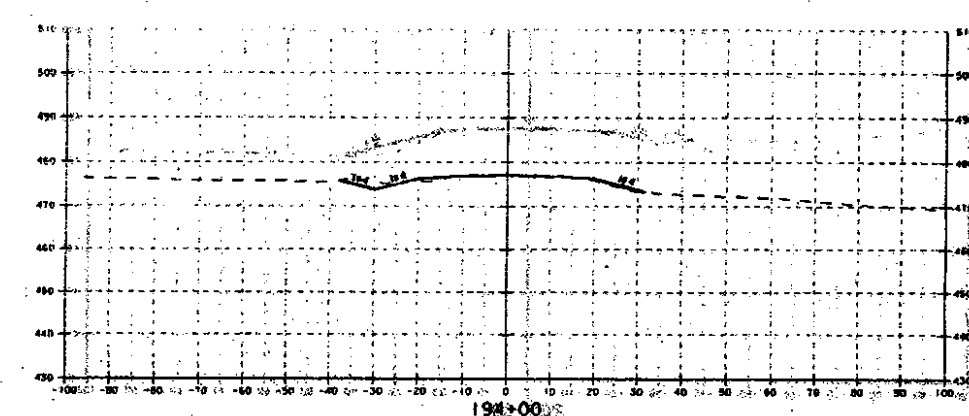
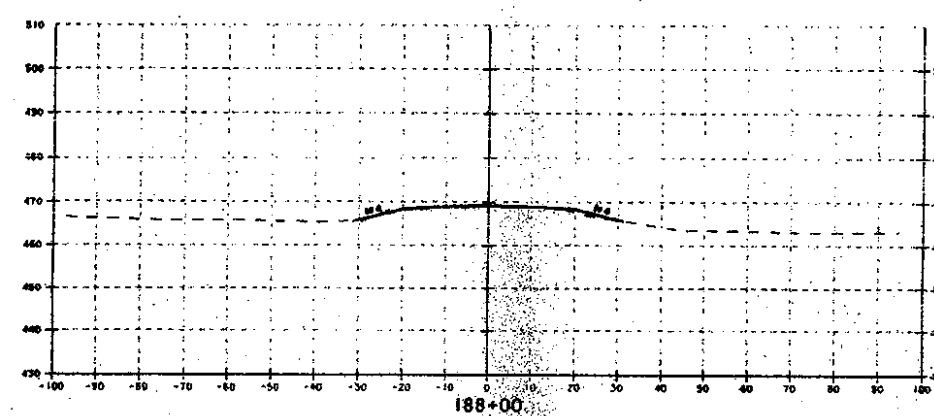


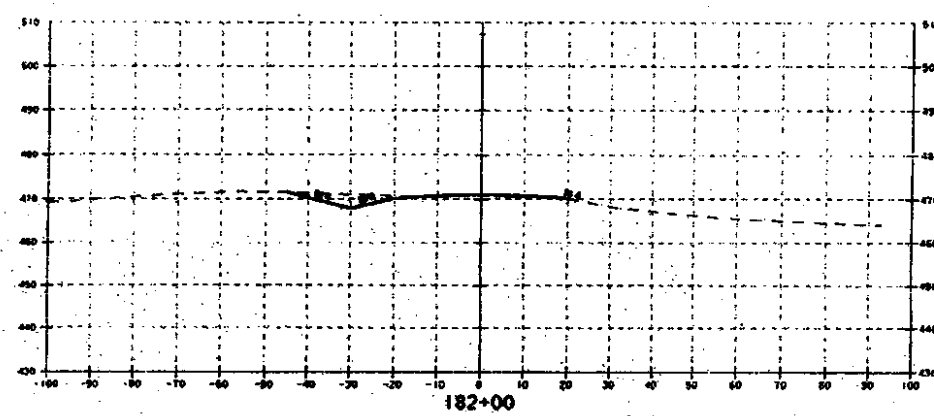

DATUM
 VERTICAL
 HORIZONTAL
 P3302

ALTERNATIVE B
 1-10-1 1877

SCALE 1" = 40'-0"
 20 0 20

ALTERNATIVE B

SURVEYED BY C. WOODS
 DRAWN BY J.A. GARSO
 SQUAD LEADER
 DESIGN FILE NO. /784051/MS14/MS14.dgn
 DATE 7/95
 PROJ. NAME BRANDON - LECESTER
 PROJ. NO. FECC-E-019-3(29)
 SHEET OF SHEETS