




10+320.000

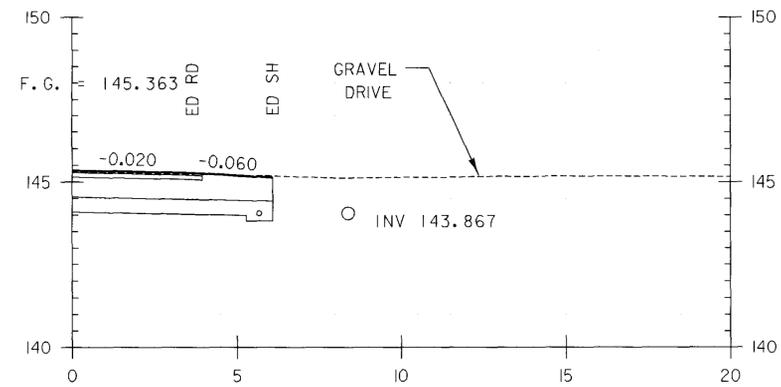

10+313.400

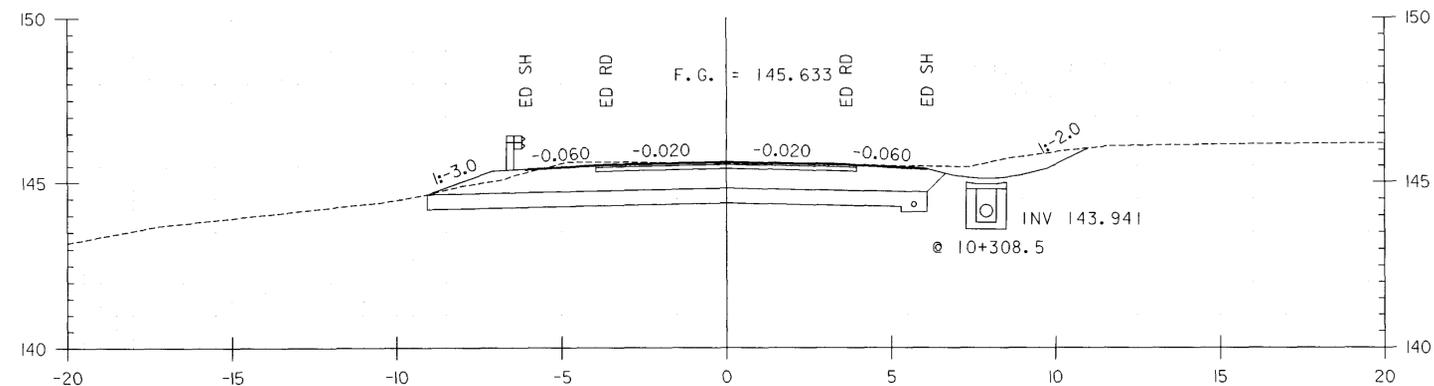

10+300.000

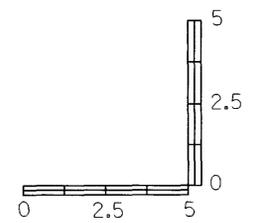

HORIZONTAL SCALE = 1:100
VERTICAL SCALE = 1:100

DATUM	
VERTICAL	NAVD 88
HORIZONTAL	NAD 83

PROJECT:	BRANDON-LEICESTER	PROJECT NO.:	FEGC F 019-3 (29)
DESIGN FILE NAME:	p:\Civil\Sheet\Cross sections & details\Cross sections\	IPARM FILE NAME:	
SURVEYED BY:	VA0T	PLOT DATE:	07/19/2002
SQUAD LEADER:	L. ORVIS P.C.	SURVEY DATE:	06-29-2000
		DRAWN BY:	C.SZCZEPANSKI
		SHEET:	53 OF 106