


11+800.000

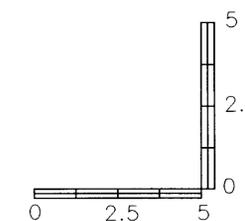

HORIZONTAL SCALE = 1:100  
VERTICAL SCALE = 1:100

<b>DATUM</b>	
VERTICAL	NAVD 88
HORIZONTAL	NAD 83

PROJECT: <b>BRANDON-LEICESTER</b>	PROJECT NO. : <b>FEGC F 019-3 (29)</b>
DESIGN FILE NAME: P:\Civil\Sheet\Cross sections & details\Cross sections\sd051xs44	PLOT DATE: 07/22/2002
IPARM FILE NAME:	SURVEY DATE: 06-29-2000
SURVEYED BY: VAOT	DRAWN BY: C.SZCZEPANSKI
SQUAD LEADER: L. ORVIS P.C.	SHEET: 53 OF 106