




12+180.000

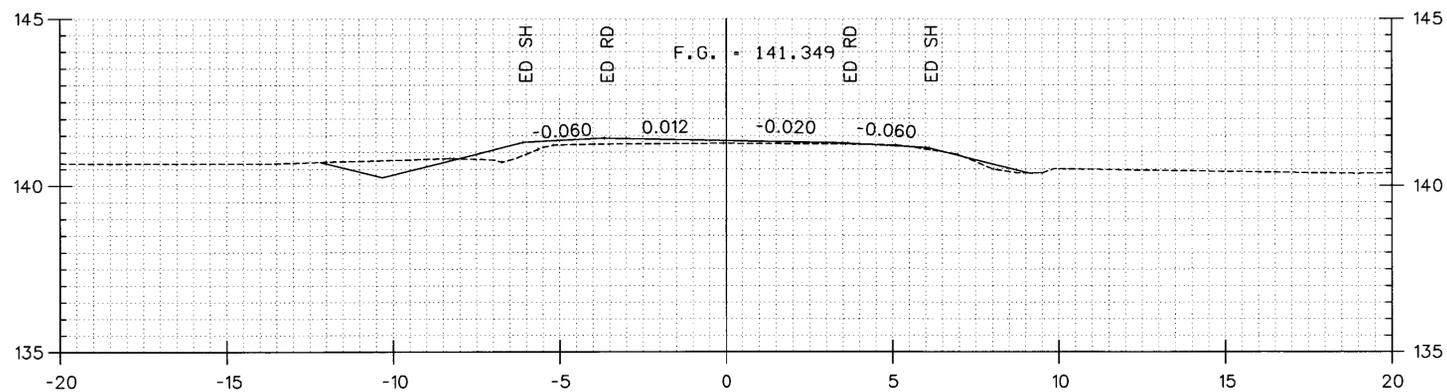

12+160.000

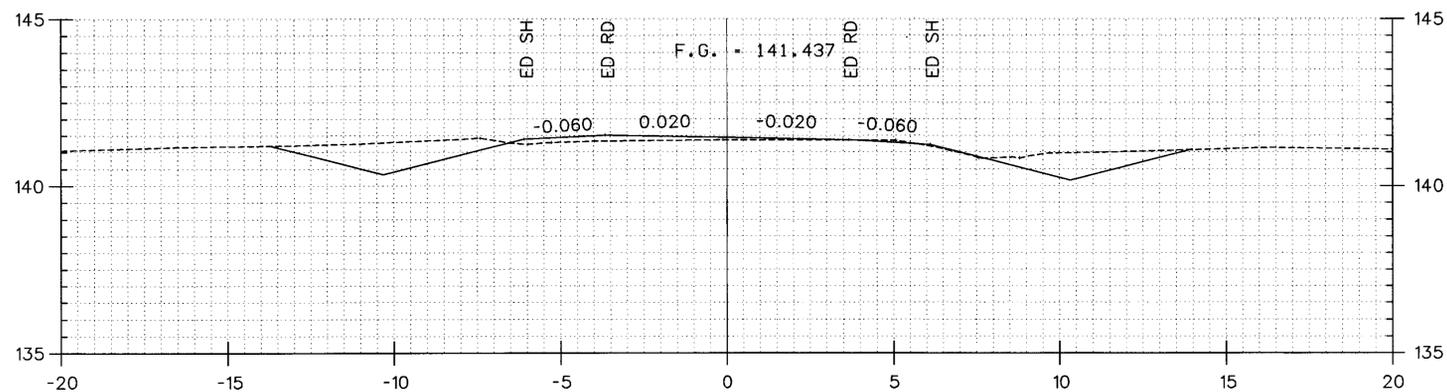

12+140.000

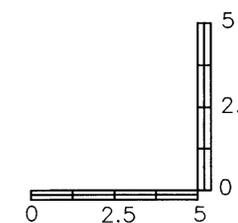

HORIZONTAL SCALE = 1:100
 VERTICAL SCALE = 1:100

DATUM	
VERTICAL	NAVD 88
HORIZONTAL	NAD 83

PROJECT: BRANDON-LEICESTER	PROJECT NO.: FEGC F 019-3 (29)
DESIGN FILE NAME: P:\Civil\Sheet\Cross sections & details\Cross sections\d051xs50	PLOT DATE: 07/22/2002
IPARM FILE NAME:	SURVEY DATE: 06-29-2000
SURVEYED BY: VAOT	DRAWN BY: C.SZCZEPANSKI
SQUAD LEADER: L. ORVIS P.C.	SHEET: 53 OF 106