




100+085.600

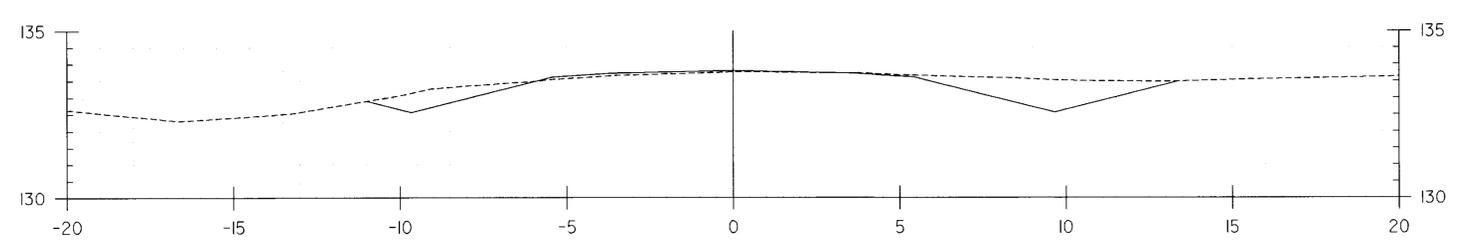

100+080.000

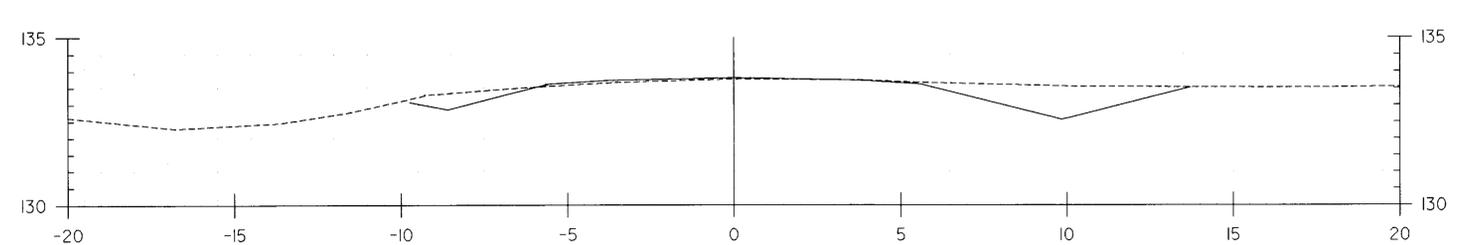

100+077.400

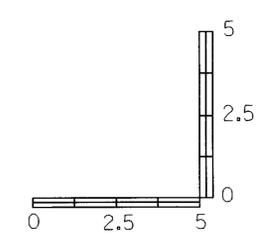

HORIZONTAL SCALE = 1:100
VERTICAL SCALE = 1:100

DATUM	
VERTICAL	NAVD 88
HORIZONTAL	NAD 83

PROJECT:	BRANDON-LEICESTER	PROJECT NO.:	FEGC F 019-3 (29)
DESIGN FILE NAME:	p:\Civ\Sheet\Cross sections & details\Cross sections\	PLOT DATE:	07/19/2002
IPARM FILE NAME:		SURVEY DATE:	06-29-2000
SURVEYED BY:	VAOT	DRAWN BY:	C.SZCZEPANSKI
SQUAD LEADER:	L. ORVIS P.C.	SHEET:	88 OF 106