




100+840.000

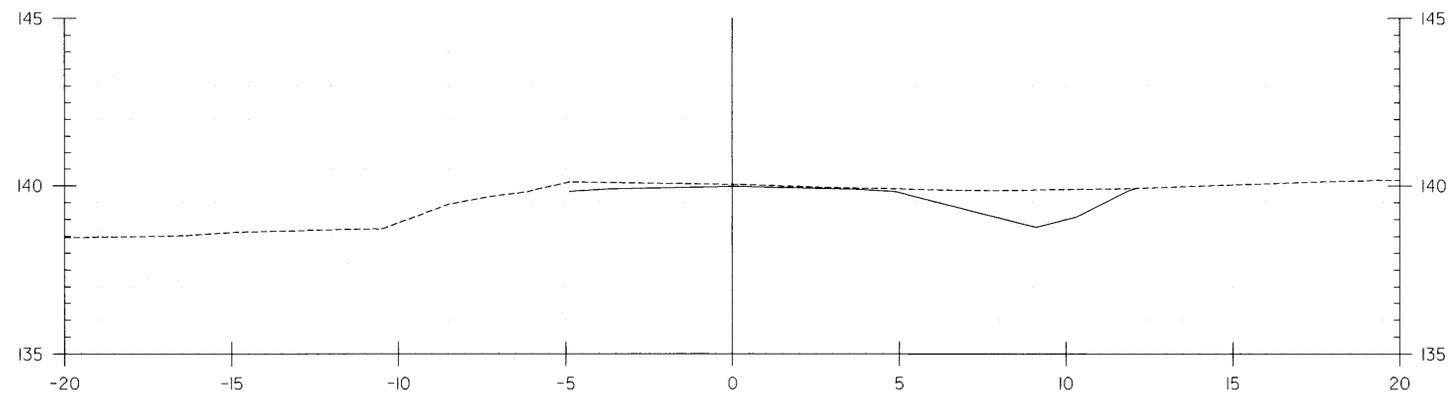

100+825.200

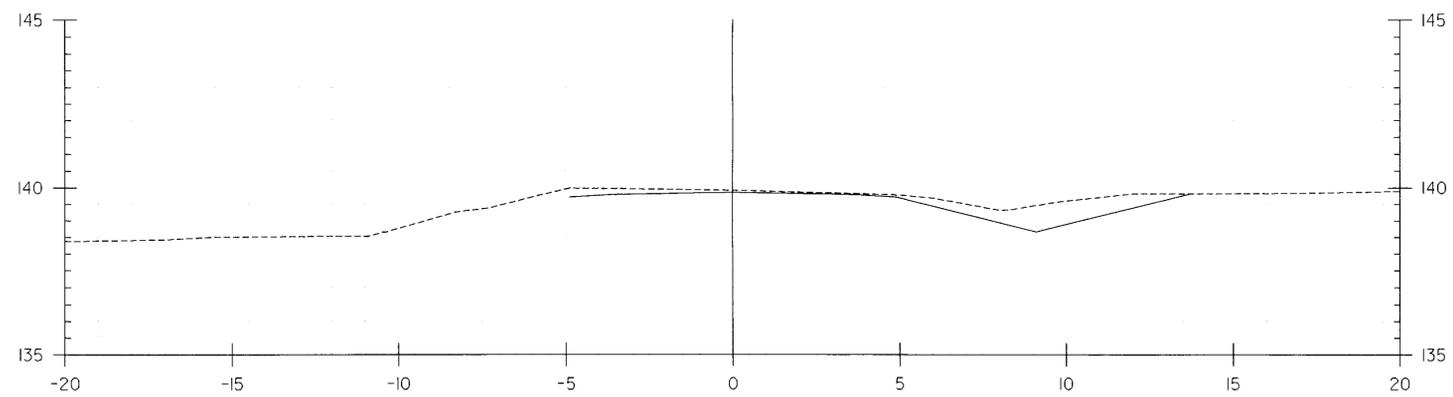

100+820.000

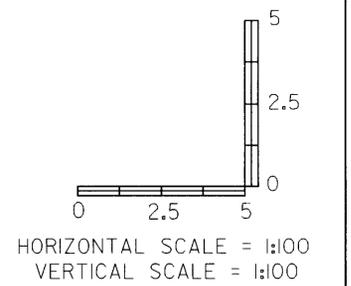

DATUM
 VERTICAL NAVD 88
 HORIZONTAL NAD 83

PROJECT: BRANDON-LEICESTER	PROJECT NO.: FEGC F 019-3 (29)
DESIGN FILE NAME: p:\Civ\1\Sheet\Cross sections & details\Cross sections\xd0	PLOT DATE: 07/19/2002
IPARM FILE NAME:	SURVEY DATE: 06-29-2000
SURVEYED BY: VAOT	DRAWN BY: C.SZCZEPANSKI
SQUAD LEADER: L. ORVIS P.C.	SHEET: 88 OF 106