




101+160.000

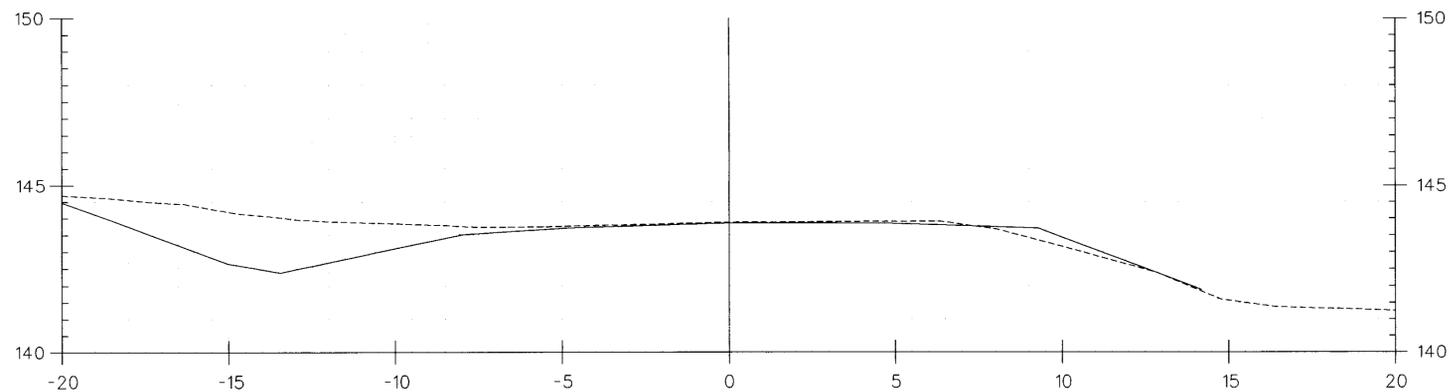

101+141.101

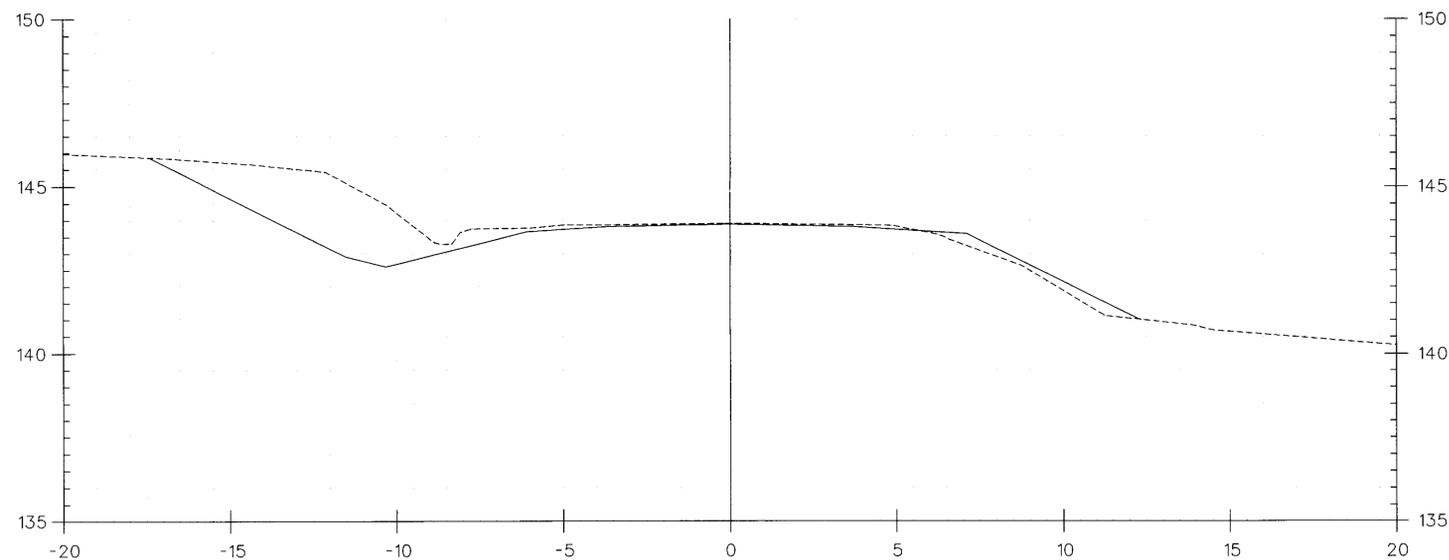

101+140.000

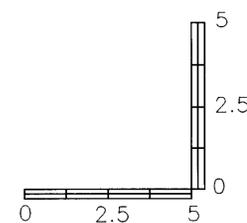

HORIZONTAL SCALE = 1:100
VERTICAL SCALE = 1:100

DATUM
VERTICAL NAVD 88
HORIZONTAL NAD 83

PROJECT: BRANDON-LEICESTER	PROJECT NO. : FEGC F 019-3 (29)
DESIGN FILE NAME: P:\Civil\Sheet\Cross sections & details\Cross sections\rd051xs29	PLOT DATE: 07/22/2002
IPARM FILE NAME:	SURVEY DATE: 06-29-2000
SURVEYED BY: VAOT	DRAWN BY: C.SZCZEPANSKI
SQUAD LEADER: L. ORVIS P.C.	SHEET: 88 OF 106