




101+640.000

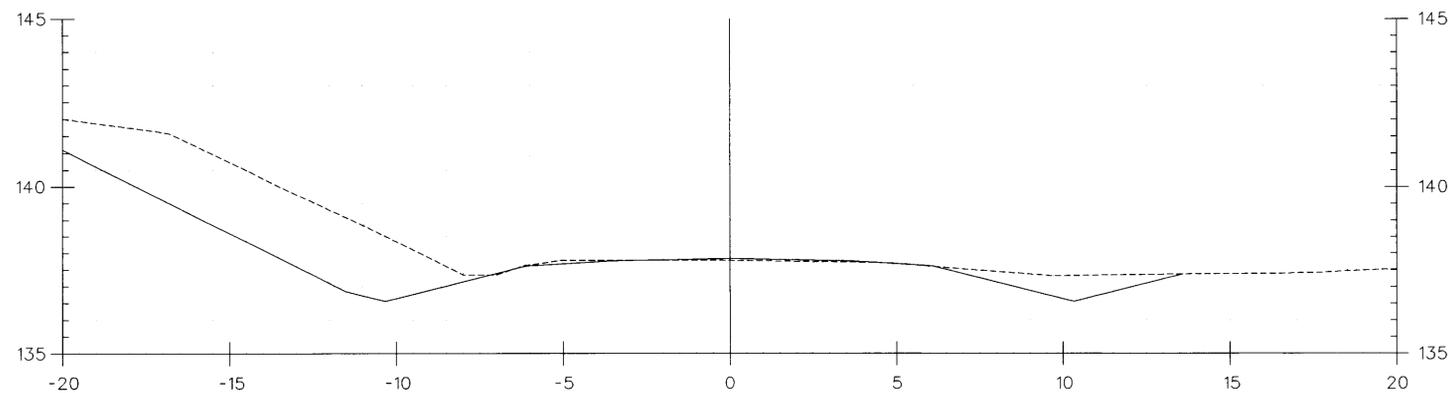

101+635.000

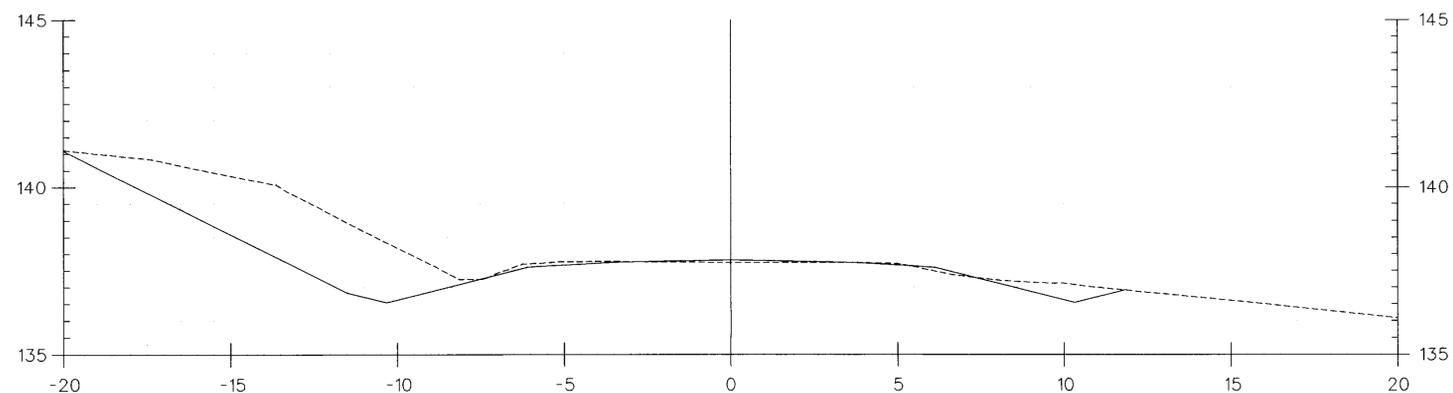

101+620.000

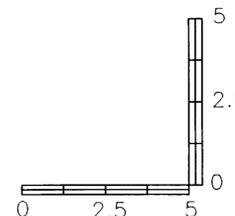

HORIZONTAL SCALE = 1:100
VERTICAL SCALE = 1:100

DATUM	
VERTICAL	NAVD 88
HORIZONTAL	NAD 83

PROJECT:	BRANDON-LEICESTER	PROJECT NO.:	FEGC F 019-3 (29)
DESIGN FILE NAME:	P:\Civil\Sheet\Cross sections & details\Cross sections\sd051xs40		
IPARM FILE NAME:		PLOT DATE:	07/22/2002
SURVEYED BY:	VAOT	SURVEY DATE:	06-29-2000
SQUAD LEADER:	L. ORVIS P.C.	DRAWN BY:	C.SZCZEPANSKI
		SHEET:	88 OF 106