




102+160.000

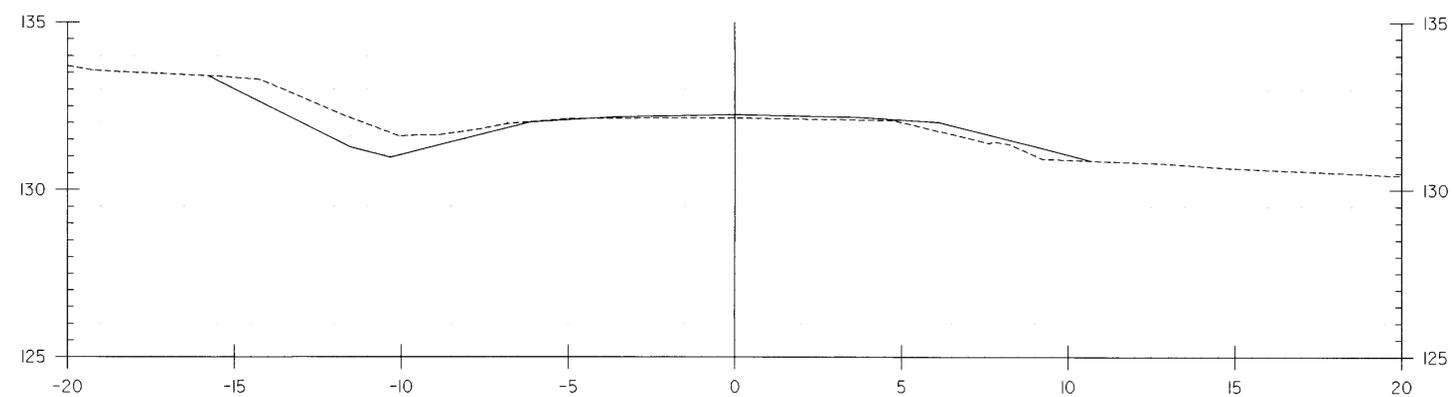

102+140.000

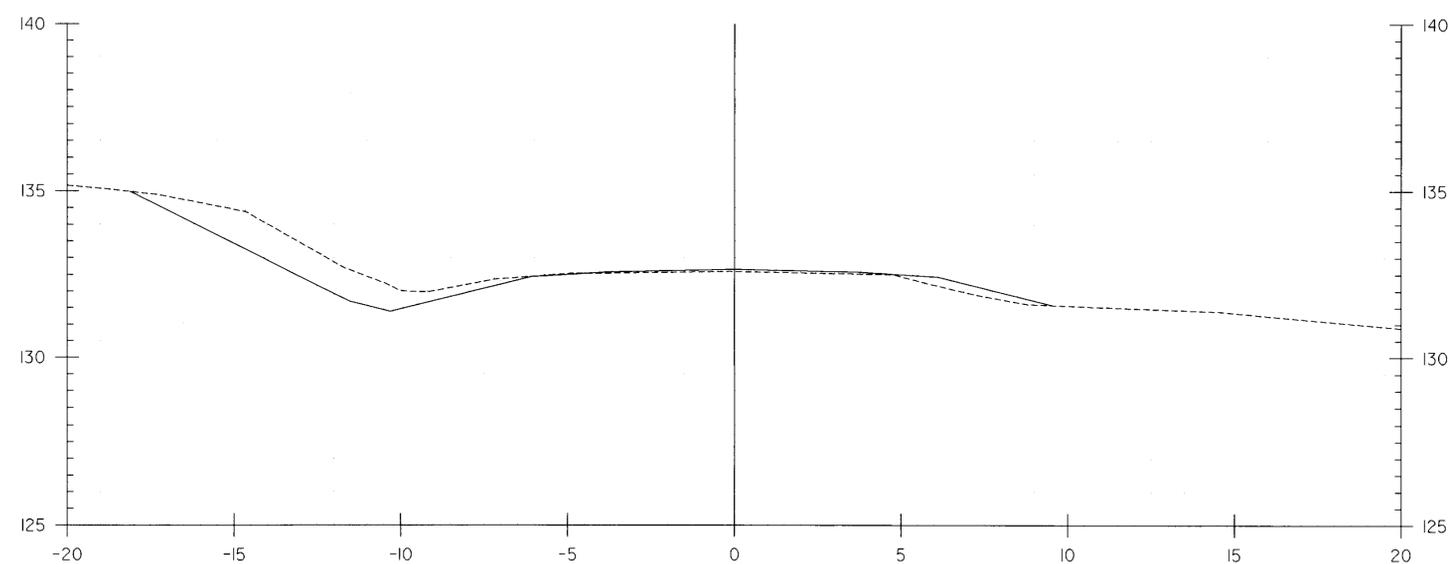

102+120.000

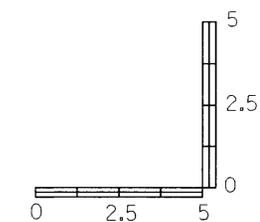

HORIZONTAL SCALE = 1:100
VERTICAL SCALE = 1:100

DATUM
VERTICAL NAVD 88
HORIZONTAL NAD 83

PROJECT: BRANDON-LEICESTER	PROJECT NO. : FEGC F 019-3 (29)
DESIGN FILE NAME: \$FILE\$	PLOT DATE: \$DATE\$
IPARM FILE NAME:	SURVEY DATE: 06-29-2000
SURVEYED BY: VAOT	DRAWN BY: C.SZCZEPANSKI
SQUAD LEADER: L. ORVIS P.C.	SHEET: 88 OF 106