

REMOVAL & DISPOSAL OF GUARD RAIL

REV. STA. 124+69 - 129+78 RT.  
REV. STA. 132+33 - 134+00 LT.

SLOPE STABILIZATION  
W/ TYPE II STONE

REV. STA. 126+00 - 127+00 RT.

LT. EROSION MATTING RT.

REV. STA. 121+96 - 122+45  
REV. STA. 123+50 - 124+50  
REV. STA. 125+62 - 126+62  
REV. STA. 127+48 - 132+82

SCARIFYING PAVEMENT

REV. STA. 124+75 - 128+25

CONSTRUCT T.H. 48 APPROACH

REV. P.O.T. 124+25.54, 29' RT.

LT. BREAKAWAY CABLE TERMINAL RT.

T.H. 48 @ STA. 41+00 - 40+81  
REV. STA. 123+35 - 123+60 RT.  
T.H. 48 @ STA. 42+40 - 42+67

PUB. RD. DIV. NO.	STATE	FED. AID PROJ. NO.	FISCAL YEAR	SHEET NO.	TOTAL SHEETS
1	VT		19		

LT. STEEL BEAM GUARD RAIL RT.

T.H. 48 @ STA. 40+81 - REV. STA. 123+60 - T.H. 48 @ 42+40  
REV. STA. 134+00

LT. CONSTRUCT DRIVE RT.

REV. STA. 122+77 (14' WIDE, GRAV.)  
REV. STA. 127+04 (14' WIDE, GRAV.)  
REV. STA. 133+00 (20' WIDE, GRAV.)


SURVEY CURVE DATA #6

$\Delta = 11^\circ 33' 03''$  LT.  
D = 1° 00' 00"  
R = 5729.58'  
T = 579.50'  
L = 1155.08'  
E = 29.23'

REV. CURVE DATA #7

$\Delta = 8^\circ 52' 04''$  LT.  
D = 1° 45' 00"  
R = 3274.04'  
T = 253.87'  
L = 506.73'  
E = 9.83'  
BANK = 0.034 FT/FT

REVISED  
P.I. #8 132+89.93 =  
132+82.69  
 $\Delta = 20^\circ 21' 44''$  RT.

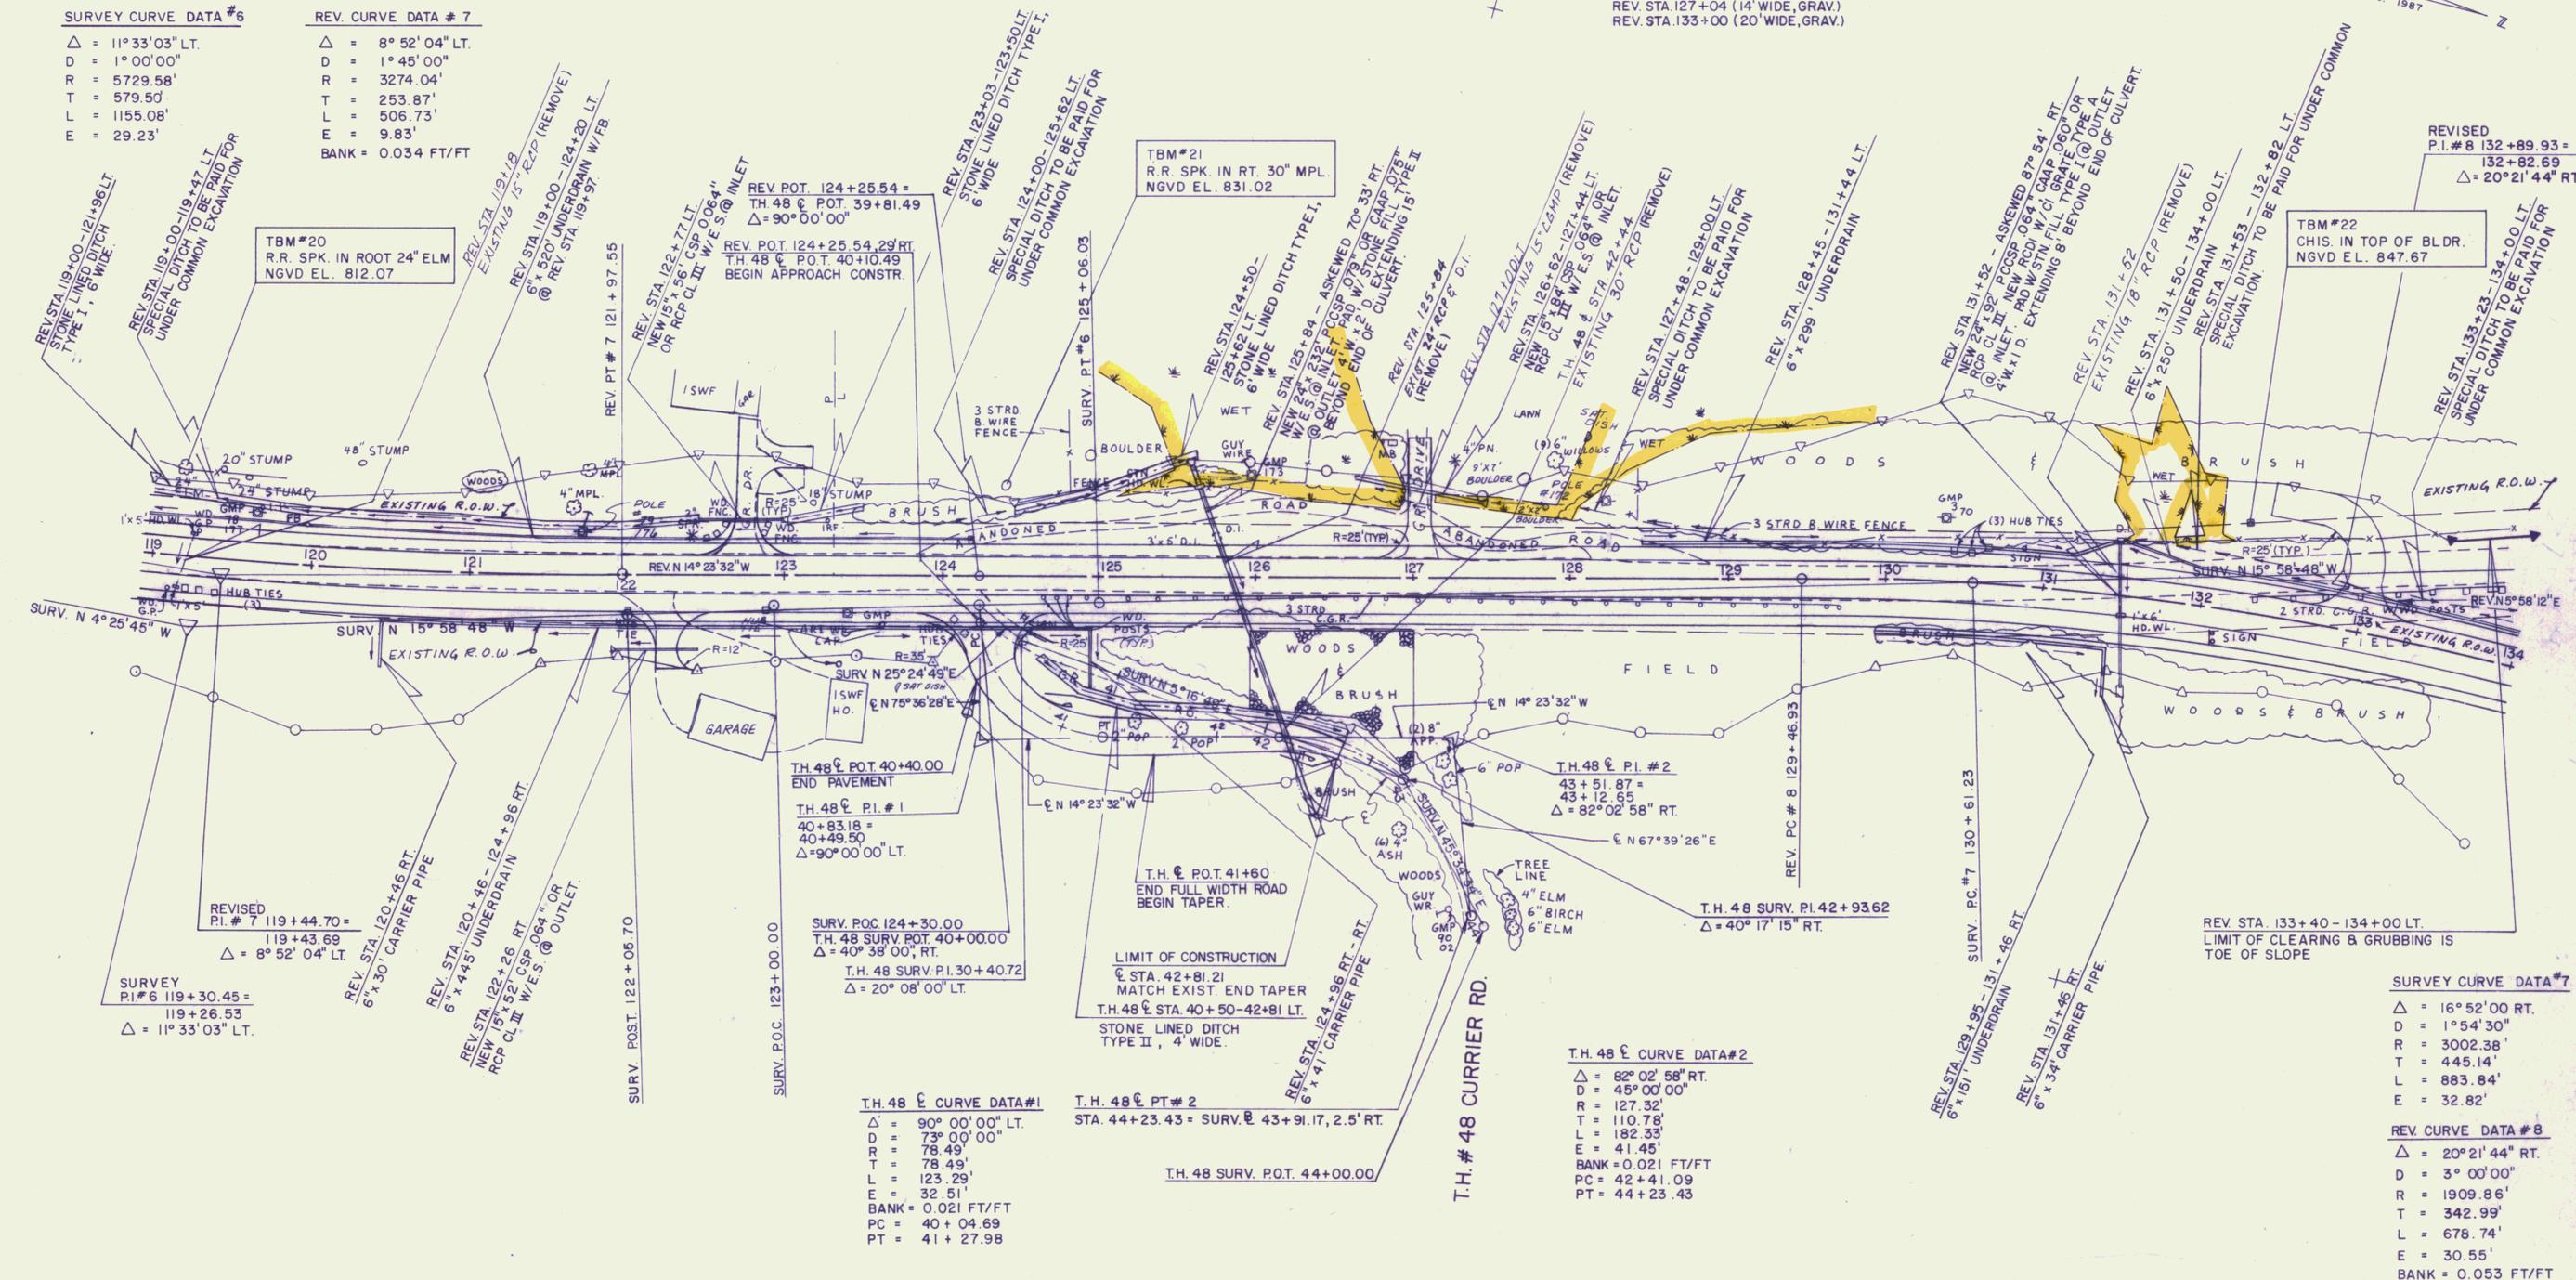

REVISED  
P.I. #7 119+44.70 =  
119+43.69  
 $\Delta = 8^\circ 52' 04''$  LT.

TH. 48 @ P.O.T. 40+40.00  
END PAVEMENT  
TH. 48 @ P.I. #1  
40+83.18 =  
40+49.50  
 $\Delta = 90^\circ 00' 00''$  LT.

T.H. 48 @ CURVE DATA #1  
 $\Delta = 90^\circ 00' 00''$  LT.  
D = 73° 00' 00"  
R = 78.49'  
T = 78.49'  
L = 123.29'  
E = 32.51'  
BANK = 0.021 FT/FT  
PC = 40+04.69  
PT = 41+27.98

T.H. 48 @ PT #2  
STA. 44+23.43 = SURV. @ 43+91.17, 2.5' RT.  
T.H. 48 SURV. P.O.T. 44+00.00

T.H. 48 @ CURVE DATA #2  
 $\Delta = 82^\circ 02' 58''$  RT.  
D = 45° 00' 00"  
R = 127.32'  
T = 110.78'  
L = 182.33'  
E = 41.45'  
BANK = 0.021 FT/FT  
PC = 42+41.09  
PT = 44+23.43

REV. STA. 133+40 - 134+00 LT.  
LIMIT OF CLEARING & GRUBBING IS  
TOE OF SLOPE

SURVEY CURVE DATA #7  
 $\Delta = 16^\circ 52' 00''$  RT.  
D = 1° 54' 30"  
R = 3002.38'  
T = 445.14'  
L = 883.84'  
E = 32.82'

REV. CURVE DATA #8  
 $\Delta = 20^\circ 21' 44''$  RT.  
D = 3° 00' 00"  
R = 1909.86'  
T = 342.99'  
L = 678.74'  
E = 30.55'  
BANK = 0.053 FT/FT



PRINTED  
NOV 09 1992

SURVEYED BY VT. SURVEY CONSULTANTS DATE 3/87  
DRAWN BY BRYANT ASSOC DATE 6/87  
TRACED BY DATE  
U.S. ROUTE 2 - MARSHFIELD  
PROJ. NO. FECC F028 - 3(28)  
SHEET 75 OF 352