
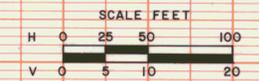


DATE	
BY	
REVIEWED	
APPROVED	
NOTE BOOK NO.	
BY	
DATE	

DATE	
BY	
REVIEWED	
APPROVED	
NOTE BOOK NO.	
BY	
DATE	

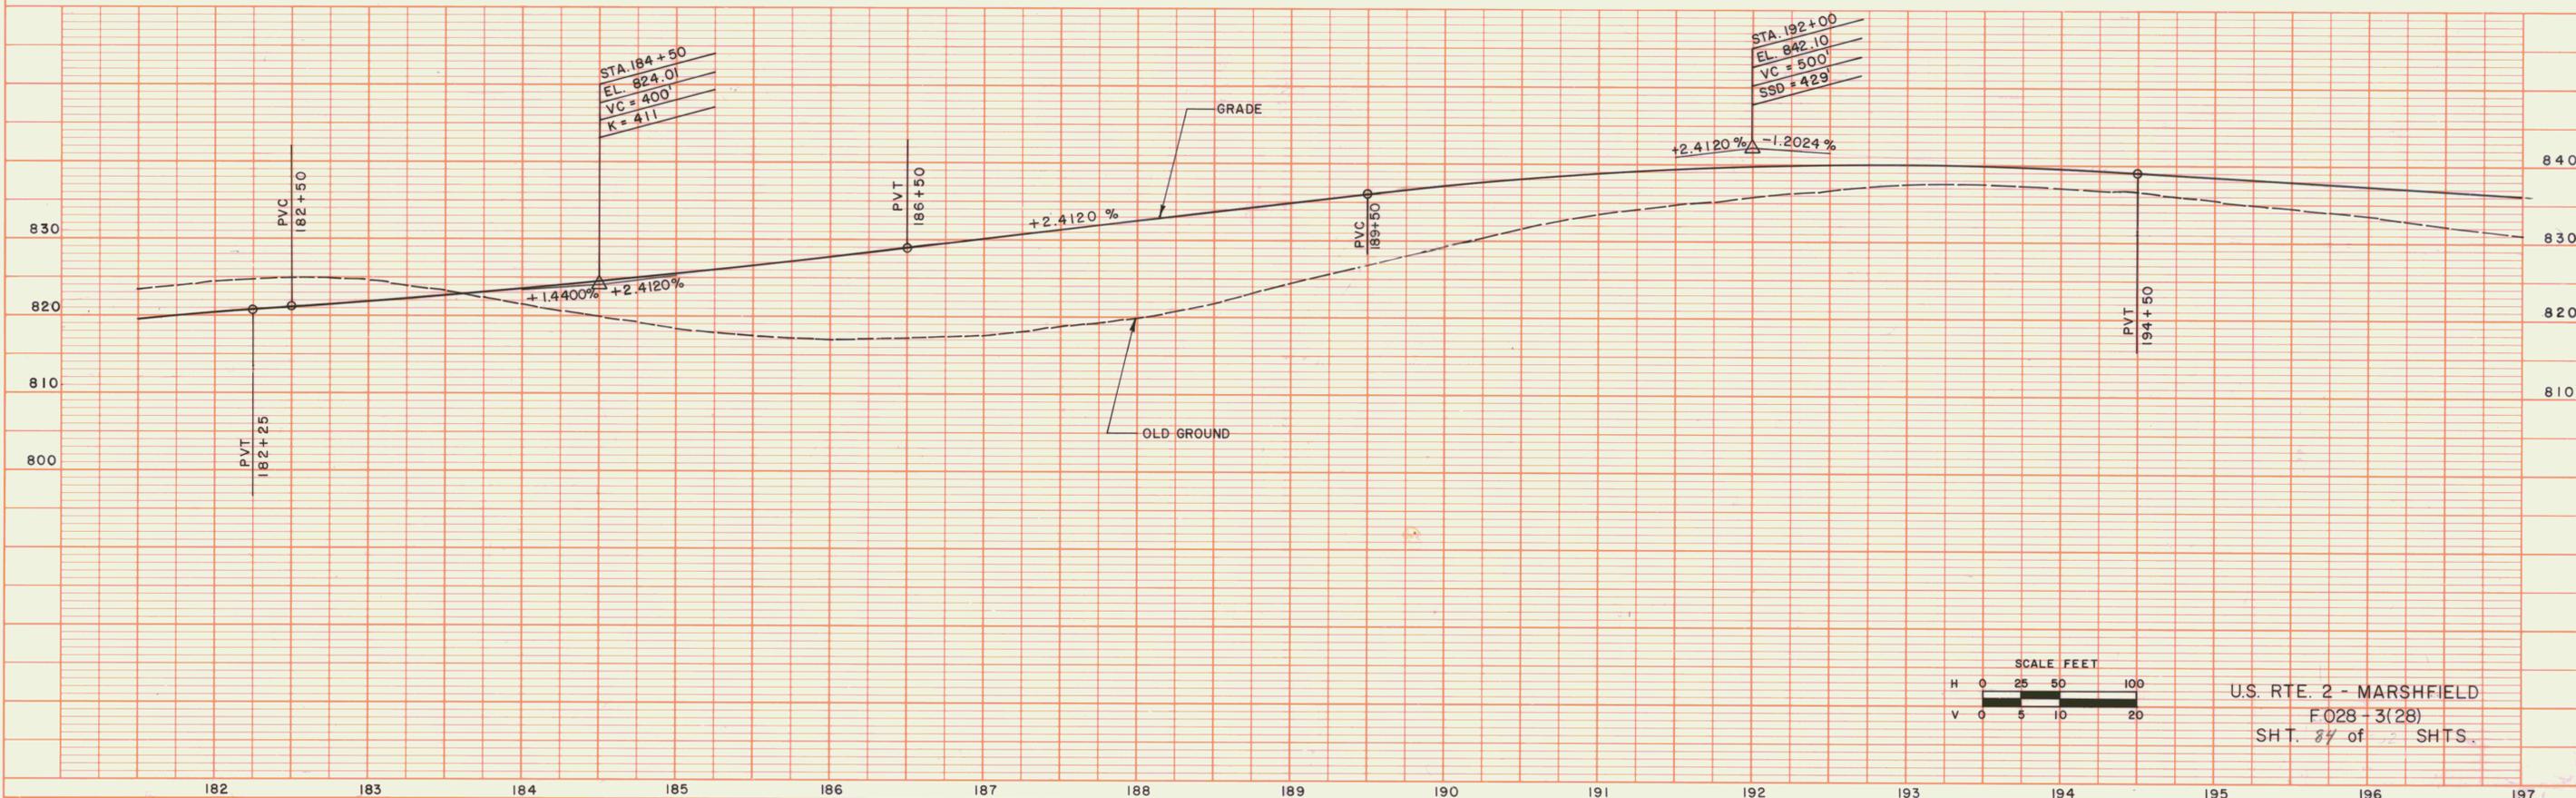

U.S. RTE. 2 - MARSHFIELD  
 F028-3(28)  
 SHT. 87 of 128 SHTS.