
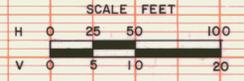


DATE	
BY	
REVIEWED	
NOTE BOOK	
NO.	

DATE	
BY	
REVIEWED	
NOTE BOOK	
NO.	

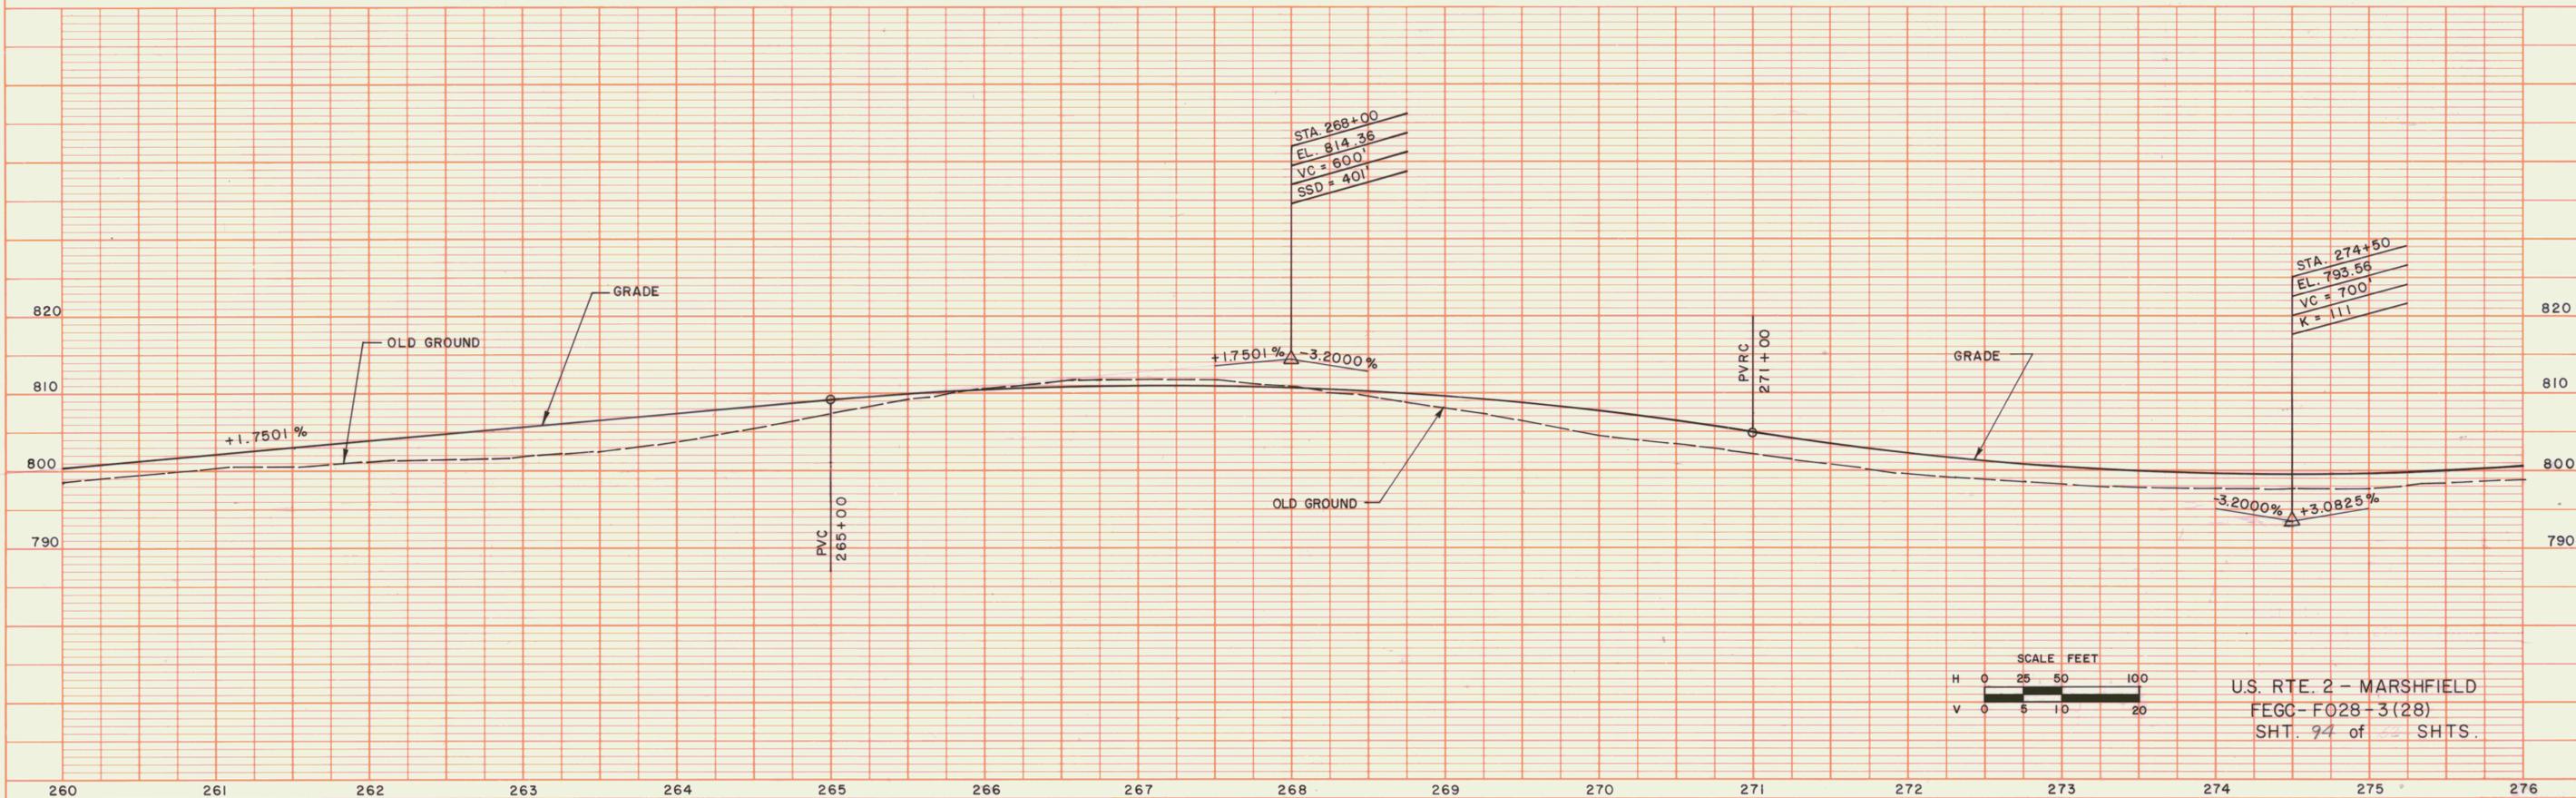

U.S. RTE. 2 - MARSHFIELD
 FEGC-F028-3(28)
 SHT. 94 of SHTS.