
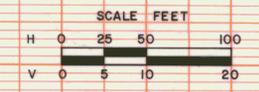


DATE: _____ BY: _____
 SURVEYED: _____ ADJUSTED: _____
 NOTE BOOK: _____
 PLAN NO. _____

DATE: _____ BY: _____
 SURVEYED: _____ ADJUSTED: _____
 NOTE BOOK: _____
 PROFILE NO. _____

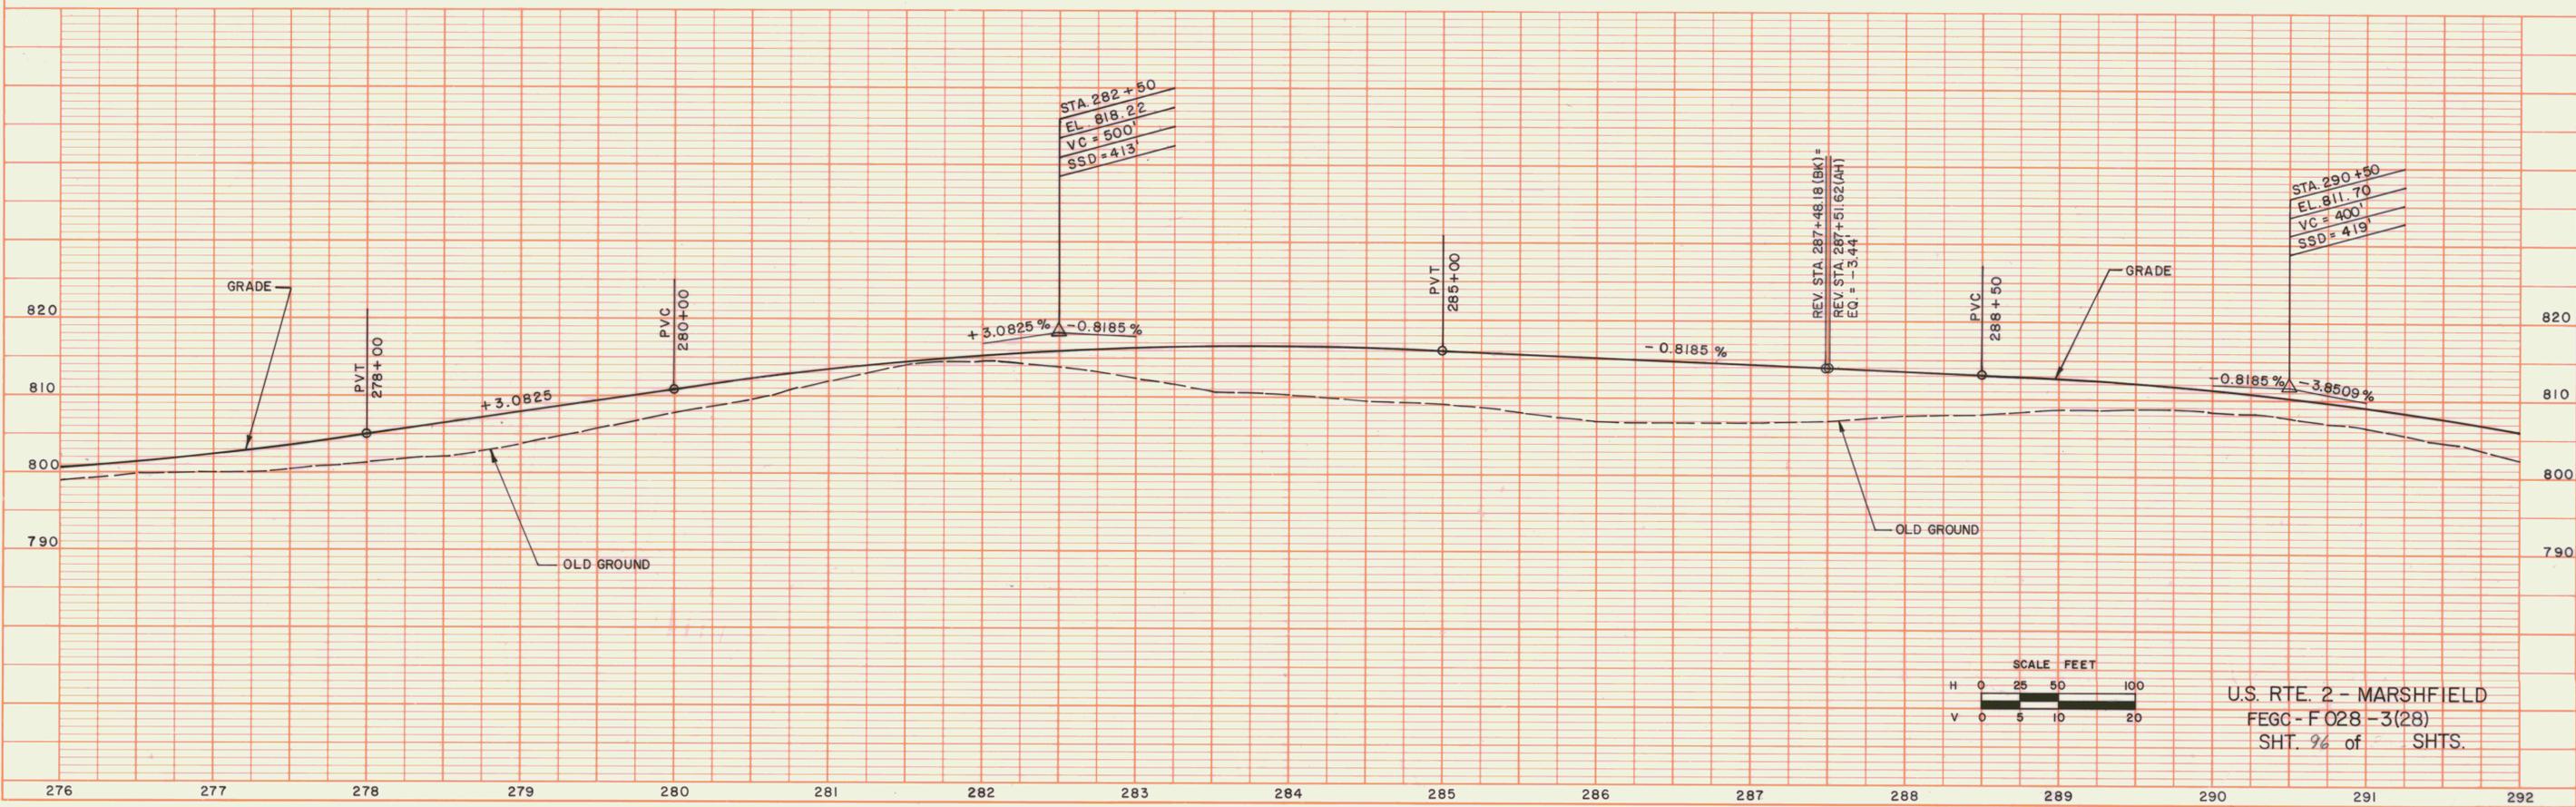

U.S. RTE. 2 - MARSHFIELD
 FECC - F028 - 3(28)
 SHT. 9 of 10 SHTS.