



LI CONSTRUCT DRIVE RT  
 REV. STA. 309+60 (14' WIDE)

PUB. RD. DIV. NO.	STATE	FED. AID PROJ. NO.	FISCAL YEAR	SHEET NO.	TOTAL SHEETS
1	VT		19		

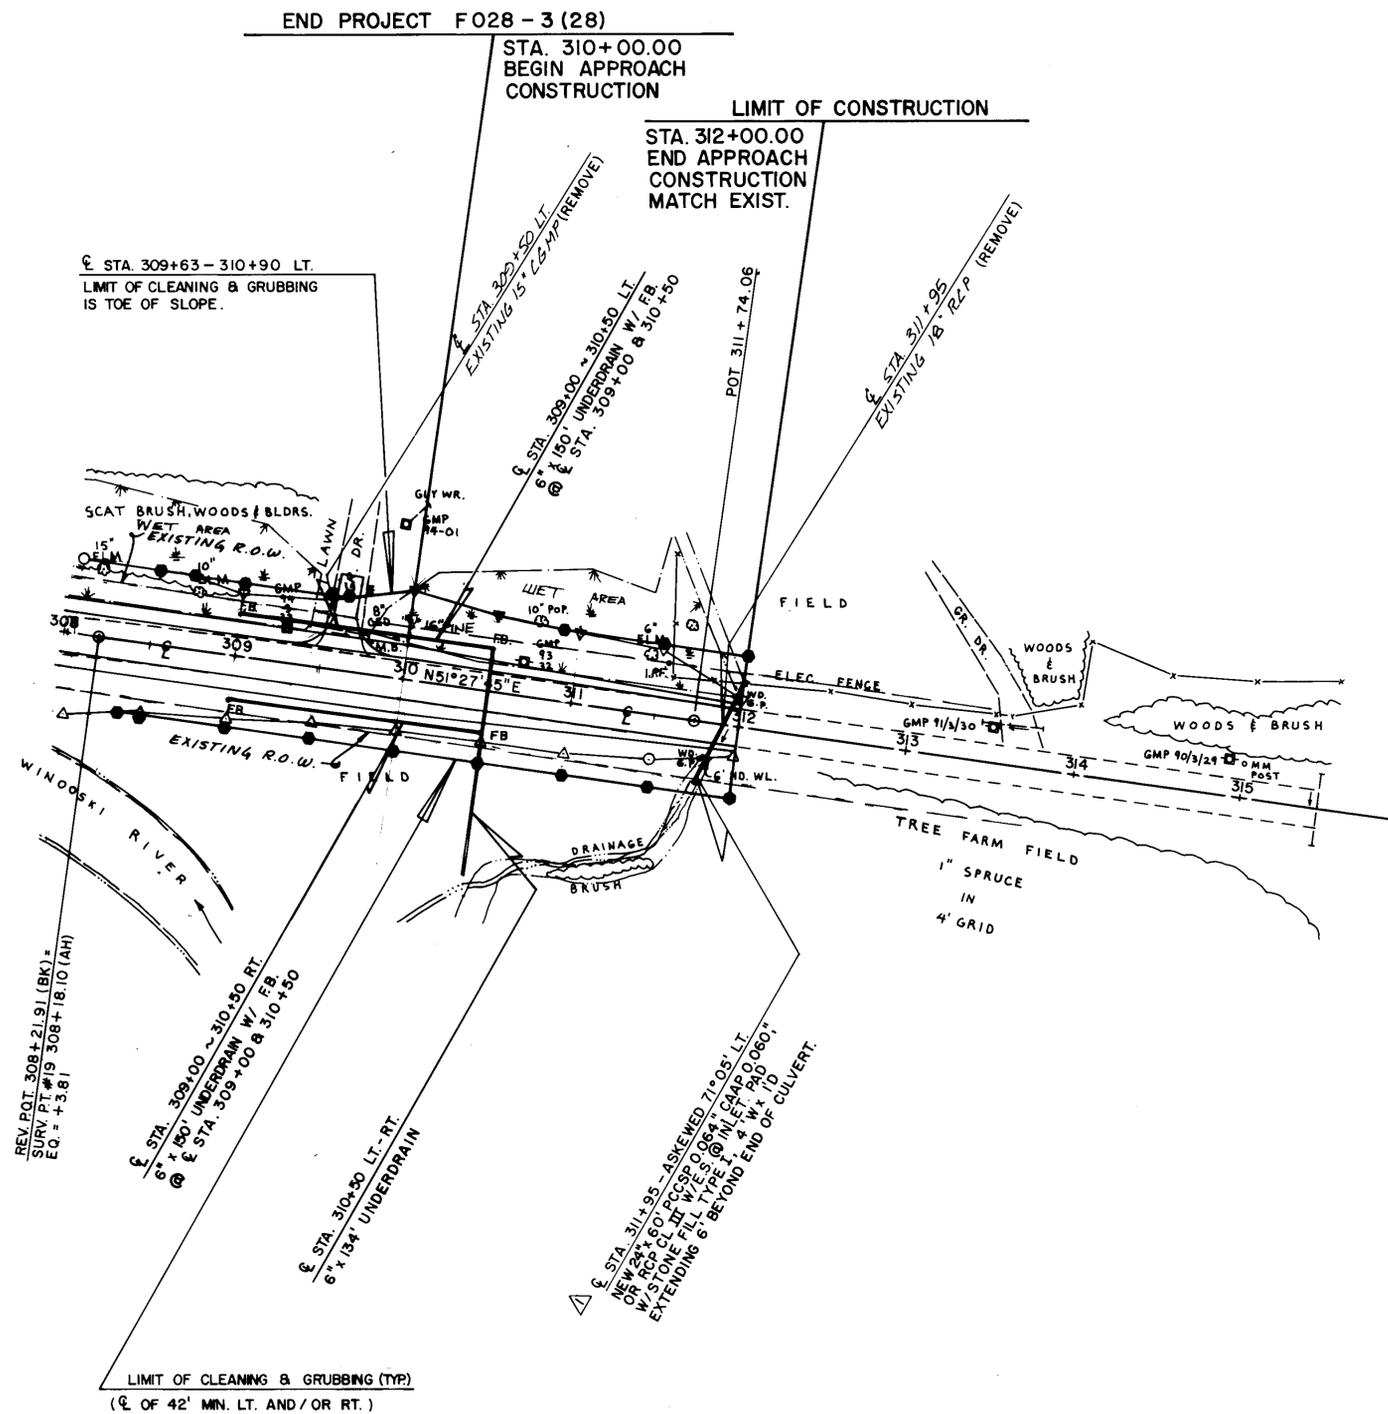

**SURVEY CURVE DATA #19**  
 $\Delta = 26^\circ 26' 23''$  RT  
 $D = 3^\circ 30' 00''$   
 $R = 1637.02'$   
 $T = 384.56'$   
 $L = 755.42'$   
 $E = 44.56'$

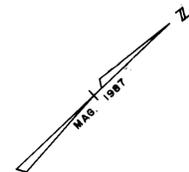

VT. SURVEY  
 SURVEYED BY CONSULTANTS DATE 3/87  
 DRAWN BY BRYANT ASSOC. DATE 6/87  
 TRACED BY DATE  
 U.S. ROUTE 2 - MARSHFIELD  
 PROJ. NO. FECC F028-3(28)  
 SHEET 99 OF

INCLUDE CPEP SMOOTH LINED(SL) OPTION.