
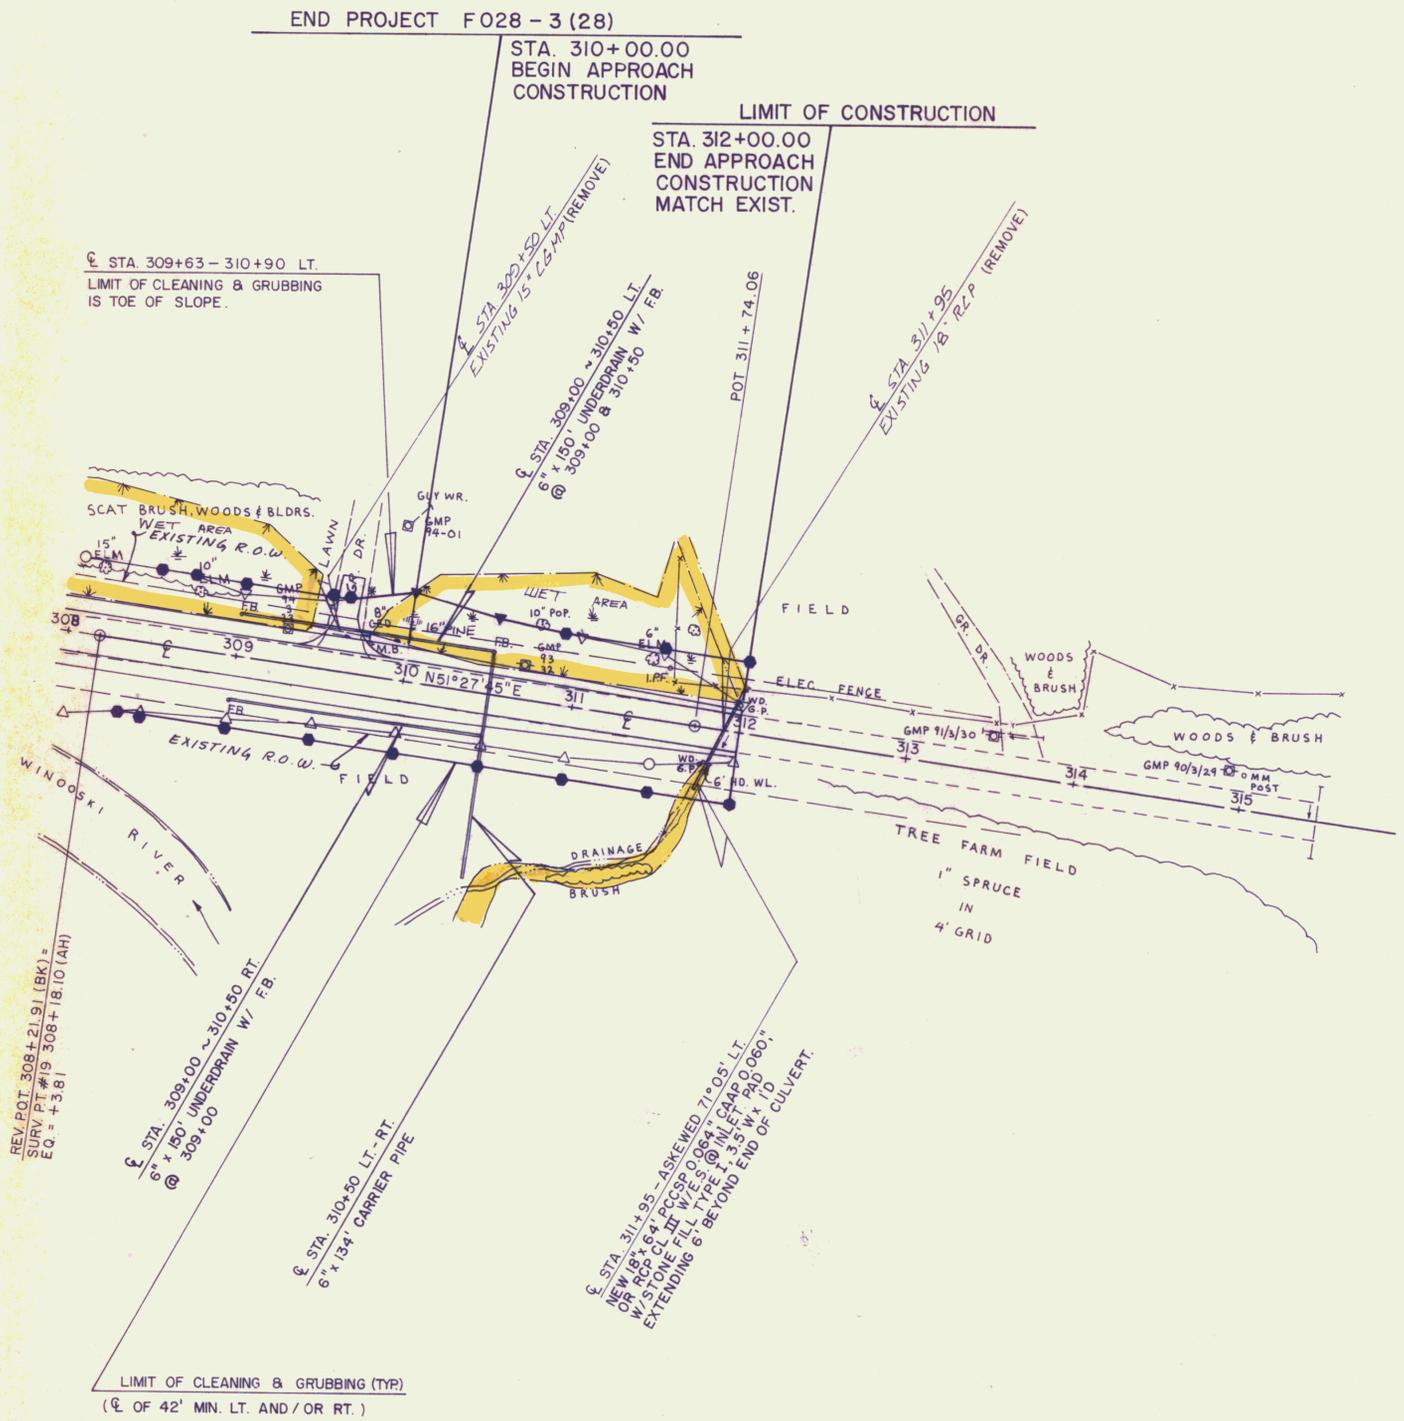


LT CONSTRUCT DRIVE RT
 REV. STA. 309+60 (14' WIDE)

PUB. DIV. NO.	STATE	FED. AID PROJ. NO.	FISCAL YEAR	SHEET NO.	TOTAL SHEETS
1	VT		19		

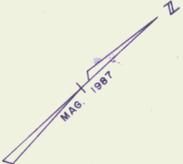

SURVEY CURVE DATA #19

- Δ = 26°26'23" RT
- D = 3°30'00"
- R = 1637.02'
- T = 384.56'
- L = 755.42'
- E = 44.56'



PRINTED

NOV 09 1992

BRYANT ASSOC. P.C.
 SYRACUSE

VT. SURVEY
 SURVEYED BY CONSULTANTS DATE 3/87
 DRAWN BY BRYANT ASSOC. DATE 6/87
 TRACED BY DATE
U.S. ROUTE 2 - MARSHFIELD
 PROJ. NO. FECC F028-3(28)
 SHEET 99 OF 352