


□ REMOVED SIGNS (R)  
 □ NEW SIGNS (N)

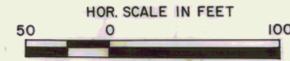

<b>PAVEMENT MARKINGS &amp; TRAFFIC SIGNING PLAN</b>	SURVEYED BY _____ DATE _____
	DRAWN BY _____ DATE _____
	TRACED BY _____ DATE _____
	U. S. RTE. 2 - MARSHFIELD
PROJ. NO. FEGC F028-3(28)	
SHEET 105 OF _____	