
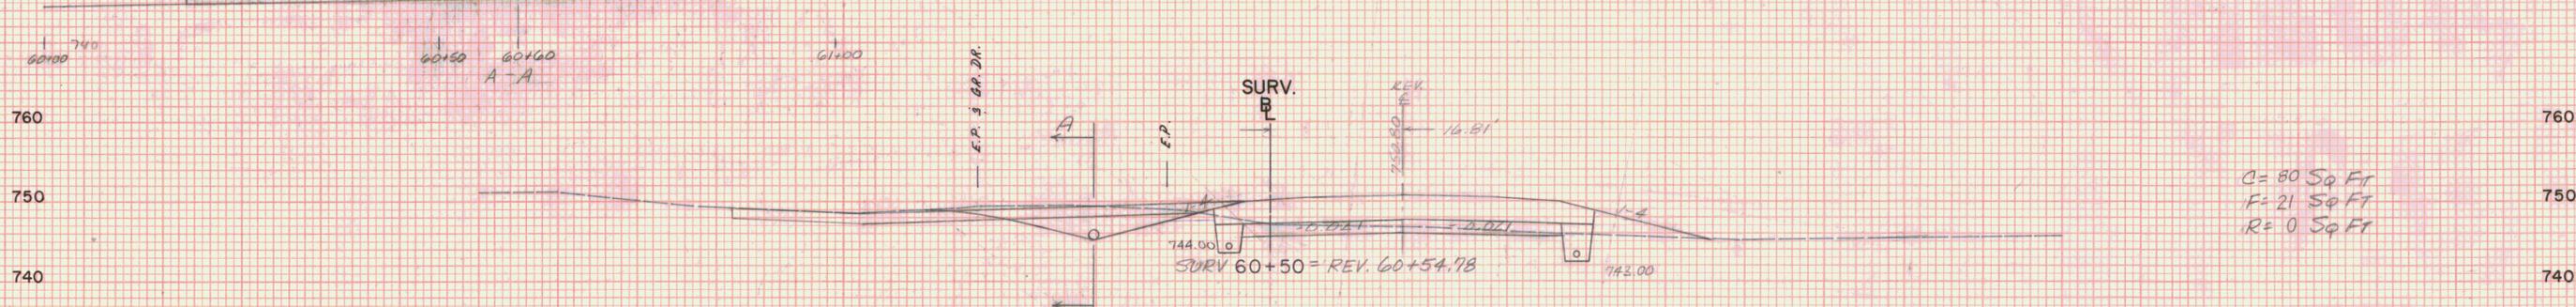
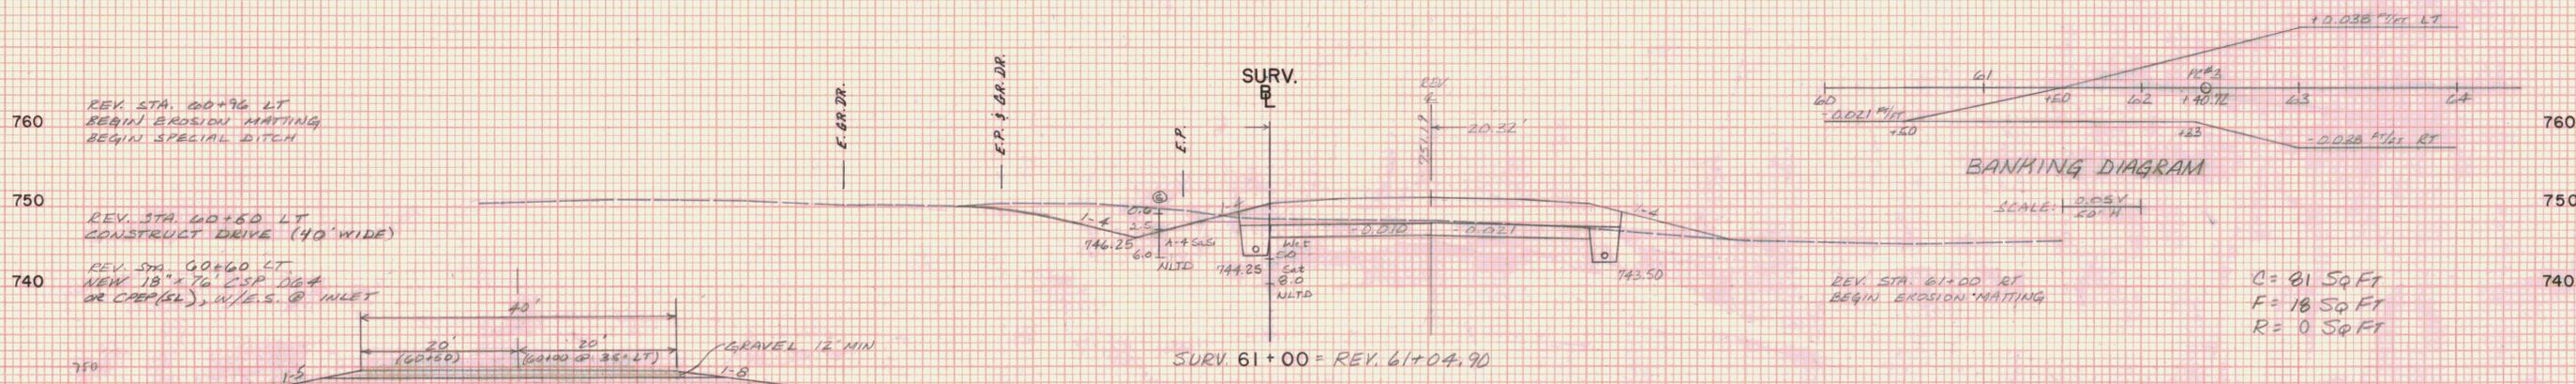
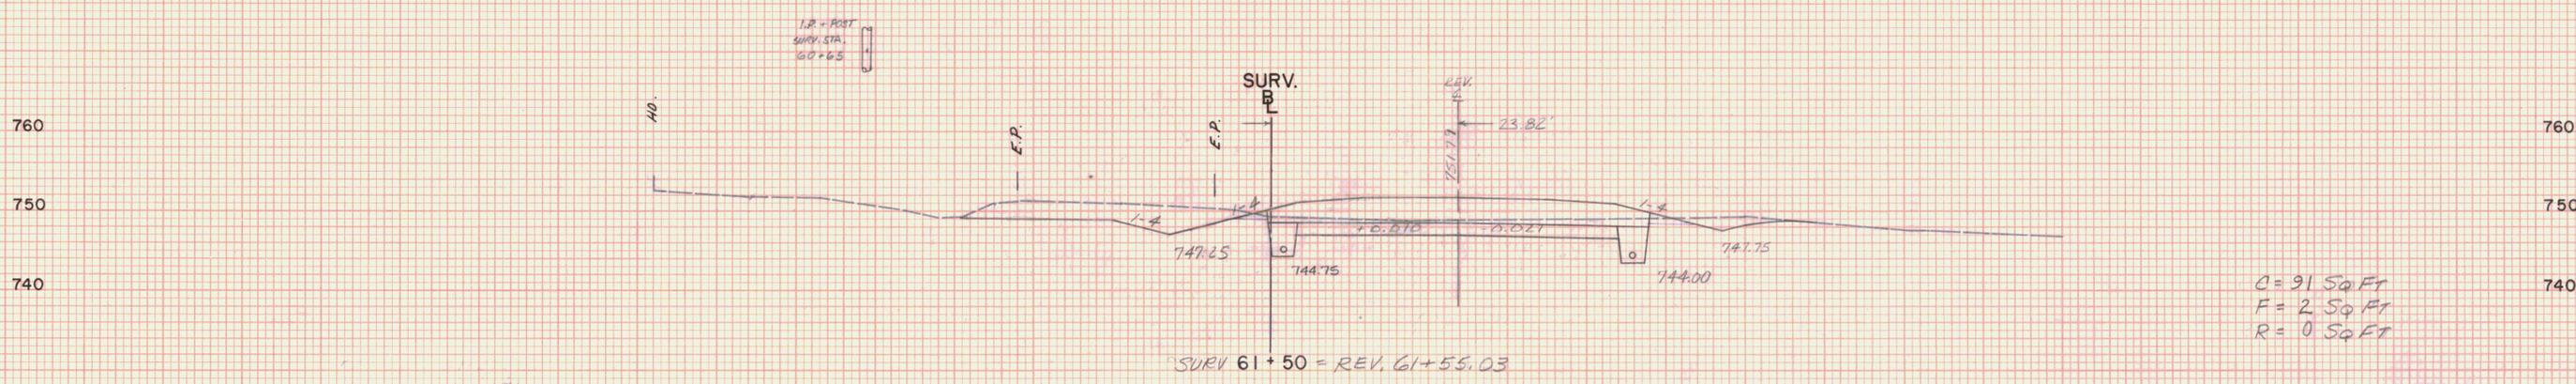


DATE: _____
BY: _____
SURVEYED: _____
PLOTTED: _____
CHECKED: _____
NO. _____

DATE: 8/86
BY: VT SURVEY CONSULTANTS
PLOTTED: BRYANT ASSOC.
CHECKED: _____
NO. _____

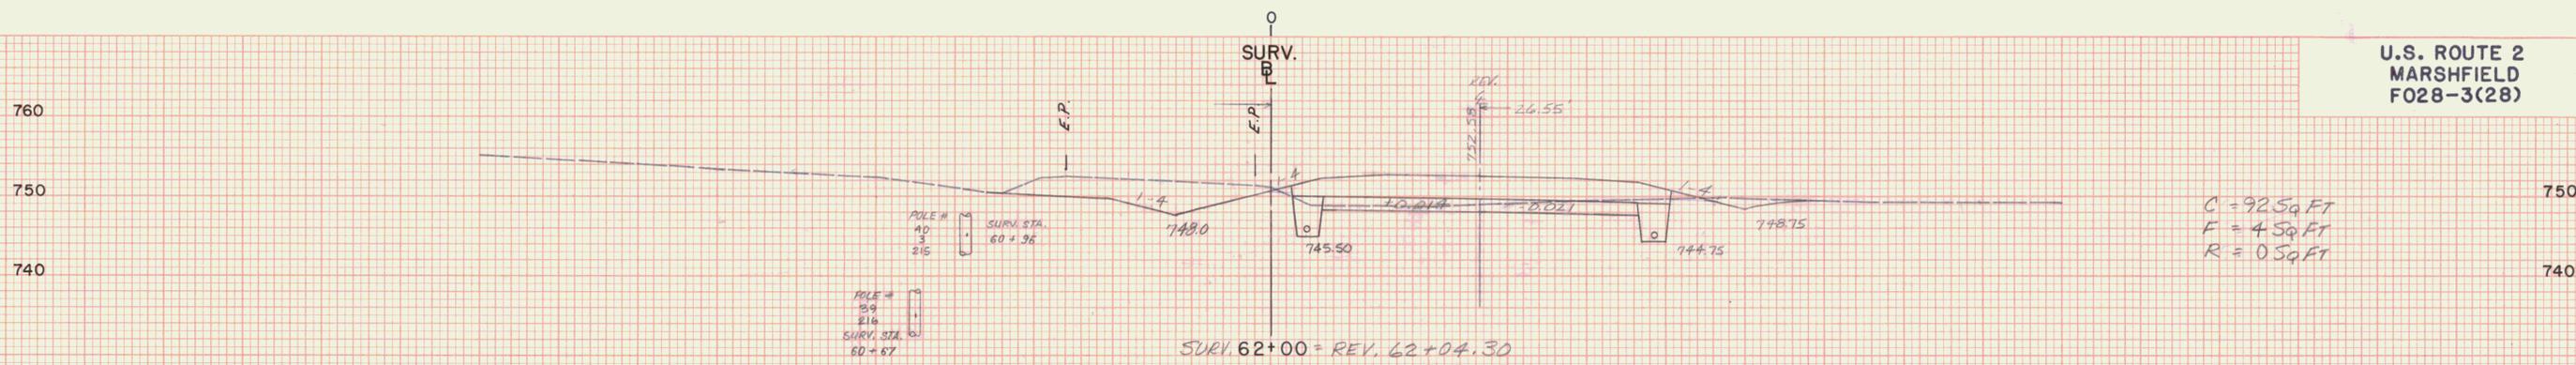

C = 92.5 sq ft
F = 4 sq ft
R = 0.5 sq ft

C = 91.5 sq ft
F = 2 sq ft
R = 0 sq ft

C = 81.5 sq ft
F = 18 sq ft
R = 0.5 sq ft

C = 80.5 sq ft
F = 21 sq ft
R = 0.5 sq ft

BANKING DIAGRAM

SCALE: 1" = 20' H

STA.	60+50	STA.	62+00
TOWN	MARSHFIELD		
PROJECT	F	NO.	028-3(28)
SHEET	127	OF	352 SHEETS
HORIZ. AND VERT. SCALE			
0 10 20			
VT SURVEY			
SURVEYED BY: CONSULTANTS DATE 8/86			