


DATE: _____
BY: _____
REVIEWED: _____
PLOTTED: _____
NO. _____
FINAL SURVEY NOTE BOOK AREA CHECKED

DATE: 8/86
BY: VT SURVEY CONSULTANTS, BRYANT ASSOC.
REVIEWED: _____
PLOTTED: _____
NO. _____
ORIGINAL SURVEY NOTE BOOK AREA CHECKED

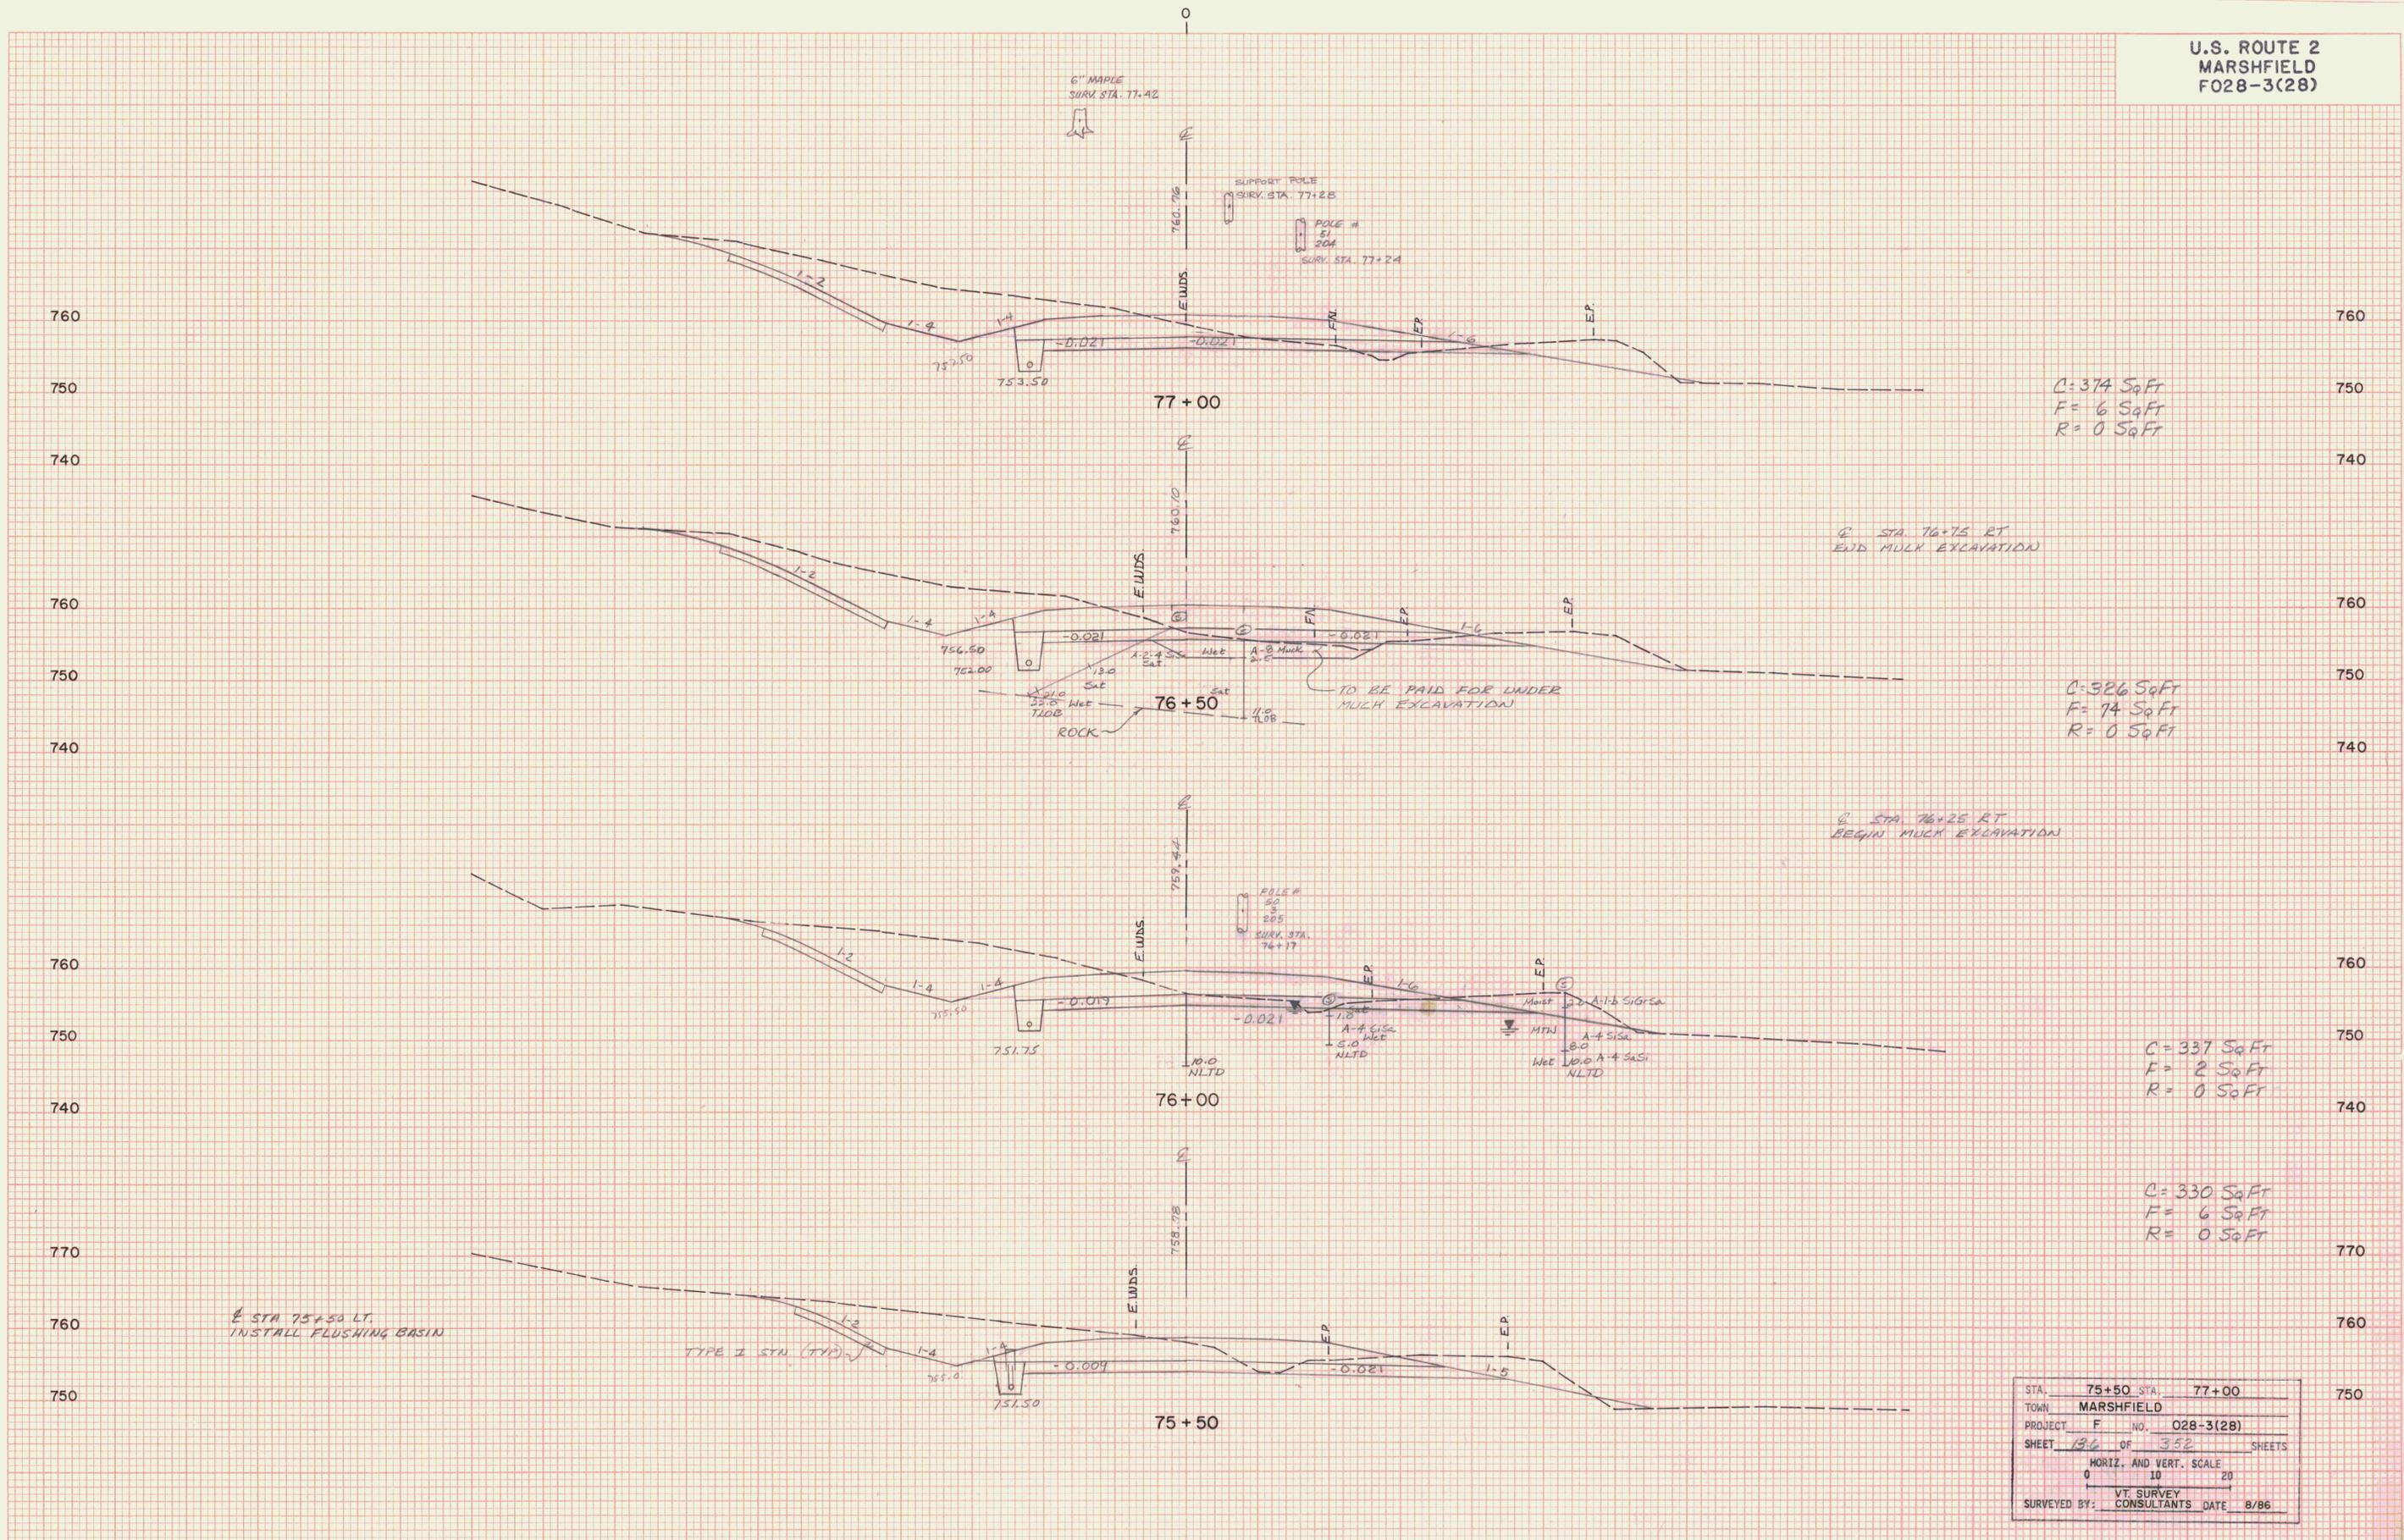

C = 374 Sq Ft
F = 6 Sq Ft
R = 0 Sq Ft

C = 326 Sq Ft
F = 74 Sq Ft
R = 0 Sq Ft

C = 337 Sq Ft
F = 2 Sq Ft
R = 0 Sq Ft

C = 330 Sq Ft
F = 6 Sq Ft
R = 0 Sq Ft

| | | | |
|--|------------|------|------------|
| STA. | 75+50 | STA. | 77+00 |
| TOWN | MARSHFIELD | | |
| PROJECT | F | NO. | 028-3(28) |
| SHEET | 196 | OF | 352 SHEETS |
| HORIZ. AND VERT. SCALE | | | |
| 0 | | 20 | |
| SURVEYED BY: VT SURVEY CONSULTANTS DATE 8/86 | | | |