


DATE: _____
BY: _____
REVIEWED: _____
DATE: _____
NO. _____
FINAL SURVEY NOTE BOOK

DATE: 3/86
BY: _____
REVIEWED: _____
DATE: _____
NO. _____
ORIGINAL SURVEY NOTE BOOK



STA 78+75 ~ 79+00 RT
BREAKAWAY CABLE TERMINAL

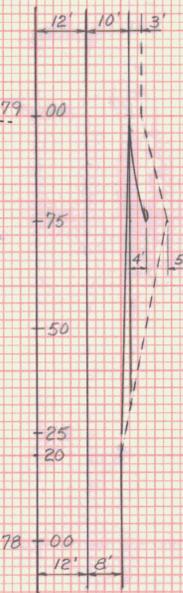

C = 448 Sq Ft
F = 15 Sq Ft
R = 0 Sq Ft

GUARD RAIL
FLARE DETAIL
1" = 20'
SCALE

C = 487 Sq Ft
F = 15 Sq Ft
R = 0 Sq Ft

STA 77+64 RT
BEGIN REMOVAL & DISPOSAL
OF GUARD RAIL

STA 77+50 RT
BEGIN LIMIT OF CLEARING
AND GRUBBING RIGHT MOST EDED
OF REMOVAL OF SURFACE &
PAVEMENT

C = 458 Sq Ft
F = 5 Sq Ft
R = 0 Sq Ft

STA 77+25
BEGIN SCRAPING
EXISTING PAVEMENT
BEGIN REMOVAL OF
SURFACES & PAVEMENTS

STA.	77+50	STA.	78+50
TOWN	MARSHFIELD		
PROJECT	F	NO.	028-3(28)
SHEET	137	OF	152 SHEETS
HORIZ. AND VERT. SCALE			
0 10 20			
SURVEYED BY: VT SURVEY CONSULTANTS DATE 3/86			

PK