


FINAL SURVEY NOTE BOOK NO.	DATE
	BY
	REVIEWED PLOTTER TEMPLATE AREA CHECKED

ORIGINAL SURVEY NOTE BOOK NO.	DATE
	BY
	REVIEWED PLOTTER TEMPLATE AREA CHECKED

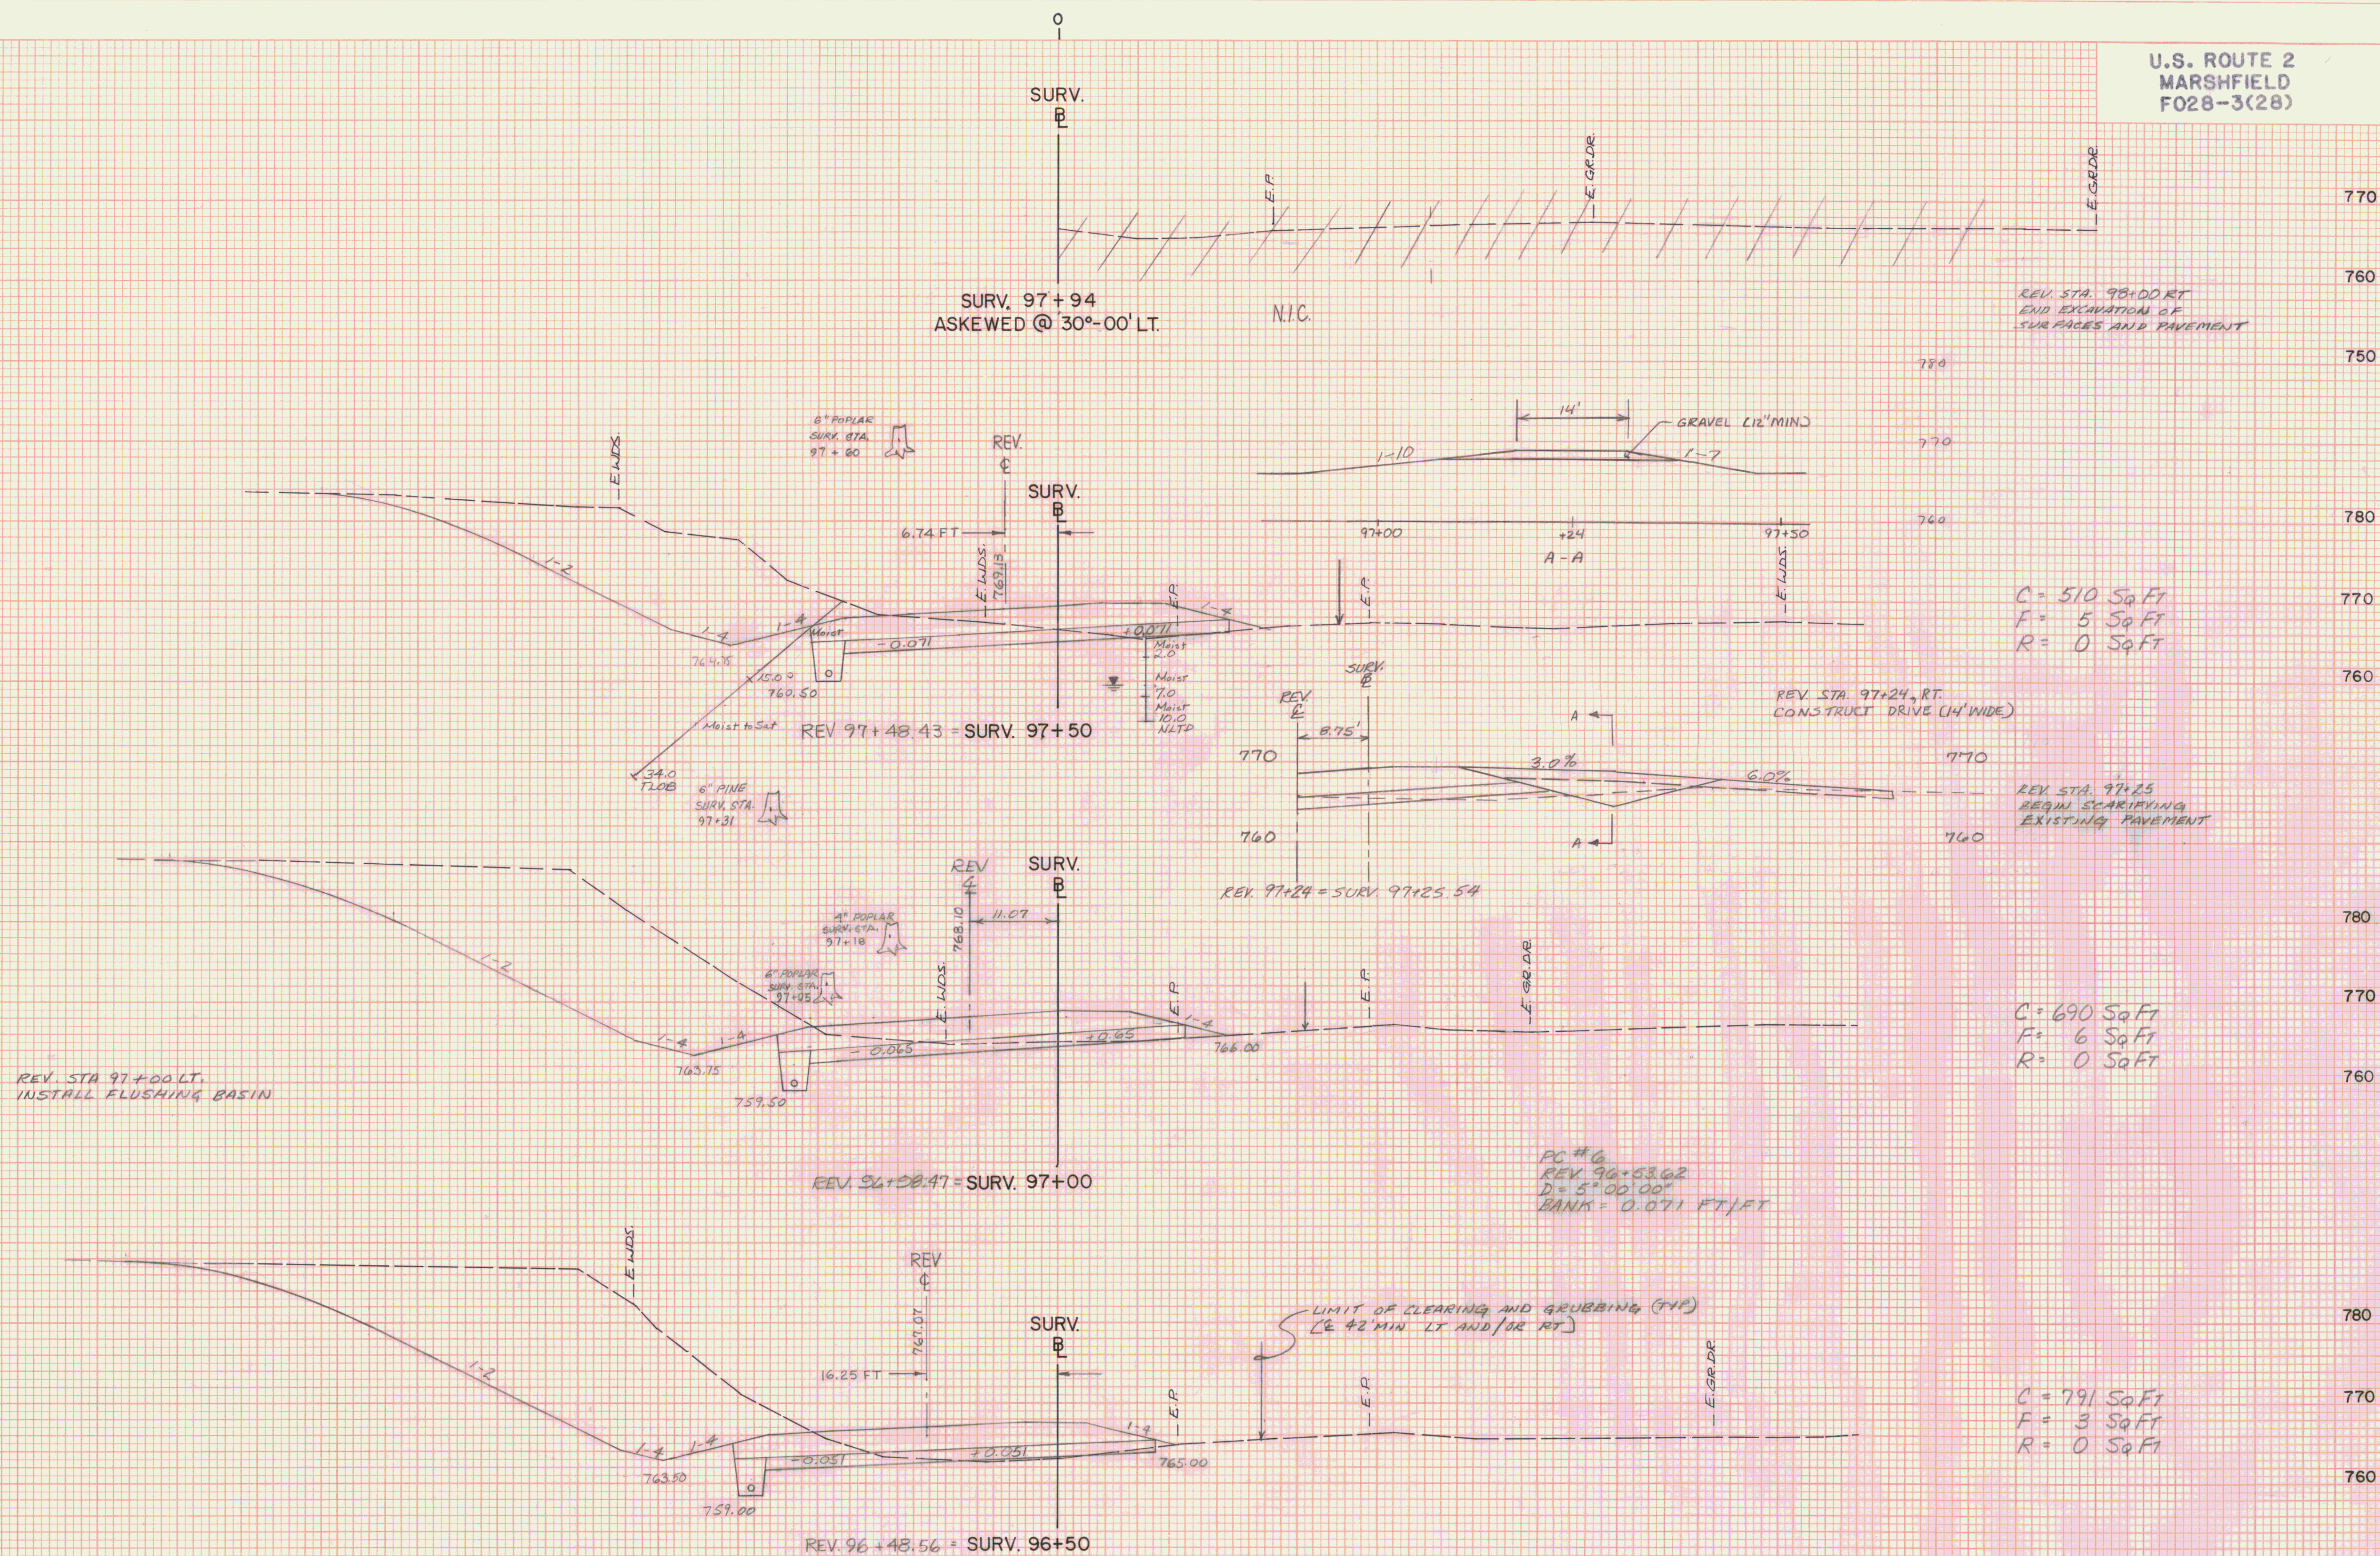

STA. 96+50	STA. 97+50
TOWN MARSHFIELD	
PROJECT F	NO. 028-3(28)
SHEET 151	SHEETS 352
HORIZ. AND VERT. SCALE 0 10 20	
VERMONT SURVEY	
SURVEYED BY: CONSULTANTS	DATE 8/86