


FINAL SURVEY NOTE BOOK	SURVEYED	BY	DATE
	PLOTTED		
	TEMPLATE		
	AREAS		
	AREAS		

ORIGINAL SURVEY	SURVEYED _____	BY <i>VT. SURVEY CONSULT.</i>	DATE <i>8/86</i>
NOTE BOOK	PLOTTED _____	<i>BRYANT ASSOC.</i>	<i>9/86</i>
No. _____	AREAS _____		
	AREAS CHECKED _____		

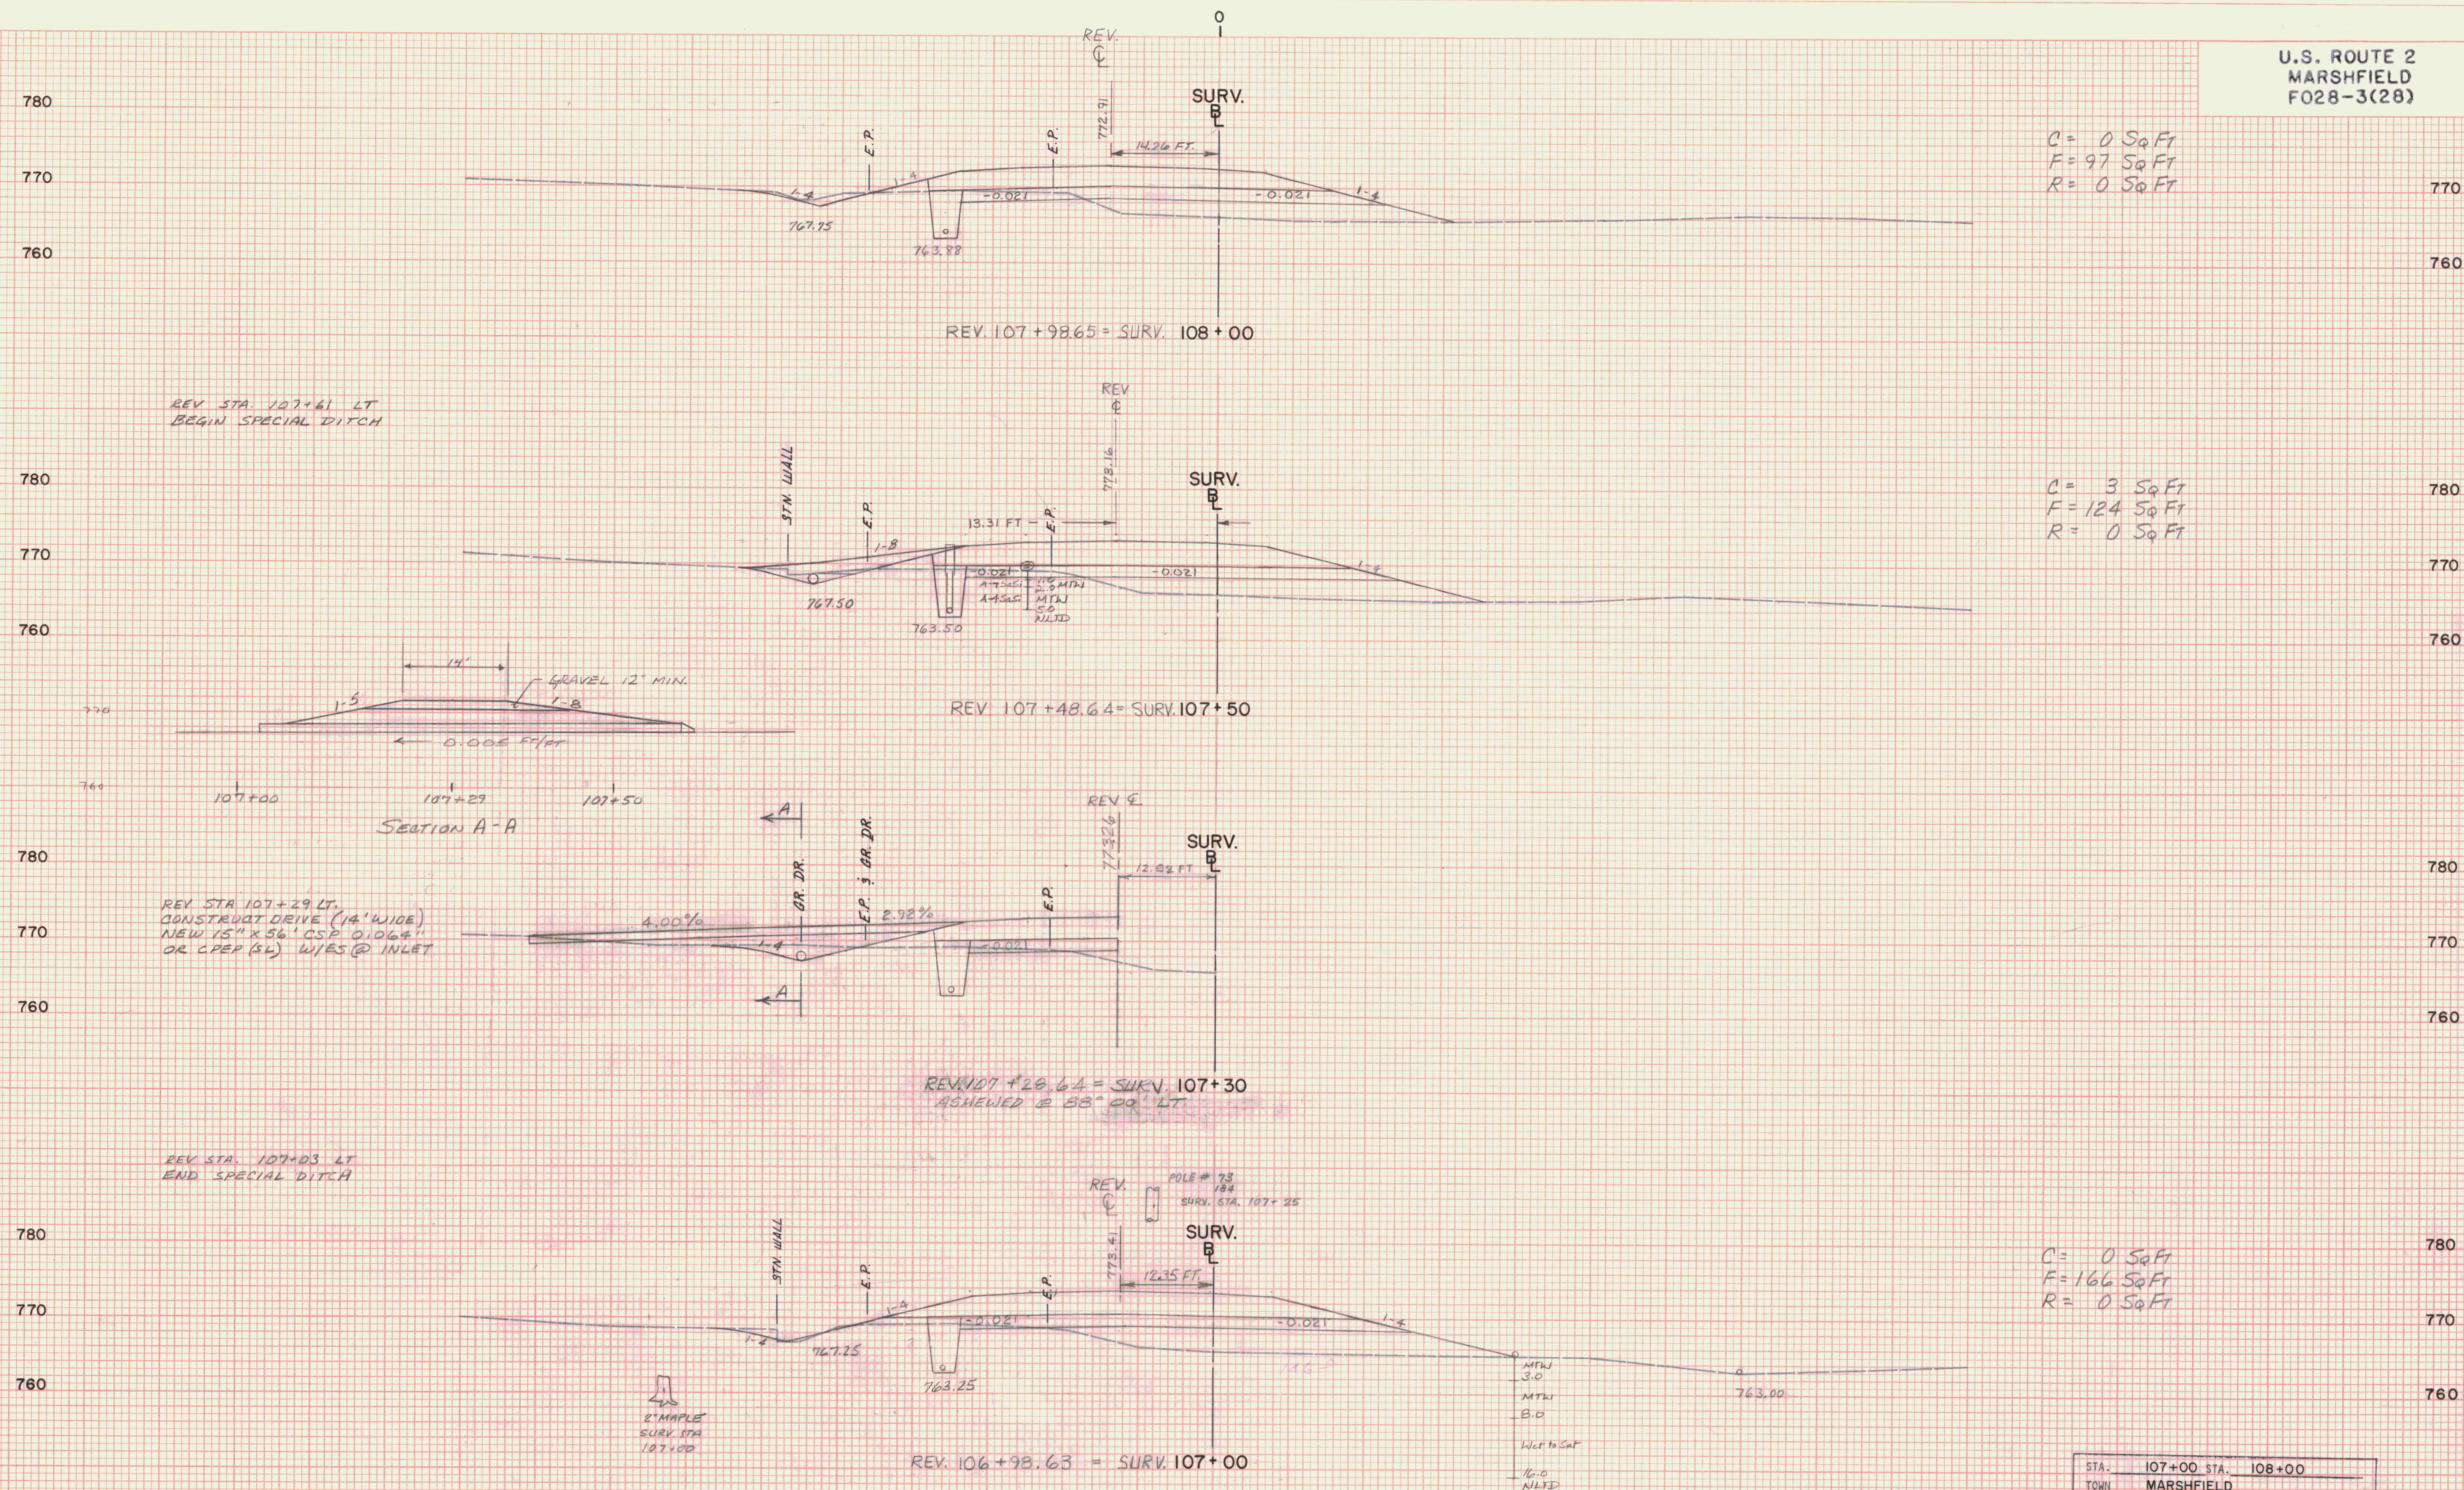

$C = 0.5 \text{ Sq Ft}$
 $F = 166 \text{ Sq Ft}$
 $R = 0.5 \text{ Sq Ft}$

STA. 107+00 STA. 108+00
TOWN MARSHFIELD
PROJECT F NO. 028-3(28)
SHEET 152 OF 1352 SHEET
HORIZ. AND VERT. SCALE
0 10 20
VT. SURVEY
SURVEYED BY: CONSULTANTS DATE 8/86