


C = 71 Sq Ft
F = 11 Sq Ft
R = 0 Sq Ft

REV. STA. 109+99 RT.
BEGIN 6" x 326" U.D.
#1 FB @ STA. 109+99 & 113+25
END 6" x 61" U.D. (LT-RT)
INSTALL FLUSHING BASIN

C = 38 Sq Ft
F = 23 Sq Ft
R = 0 Sq Ft

C = 28 Sq Ft
F = 41 Sq Ft
R = 0 Sq Ft

C = 10 Sq Ft
F = 47 Sq Ft
R = 0 Sq Ft

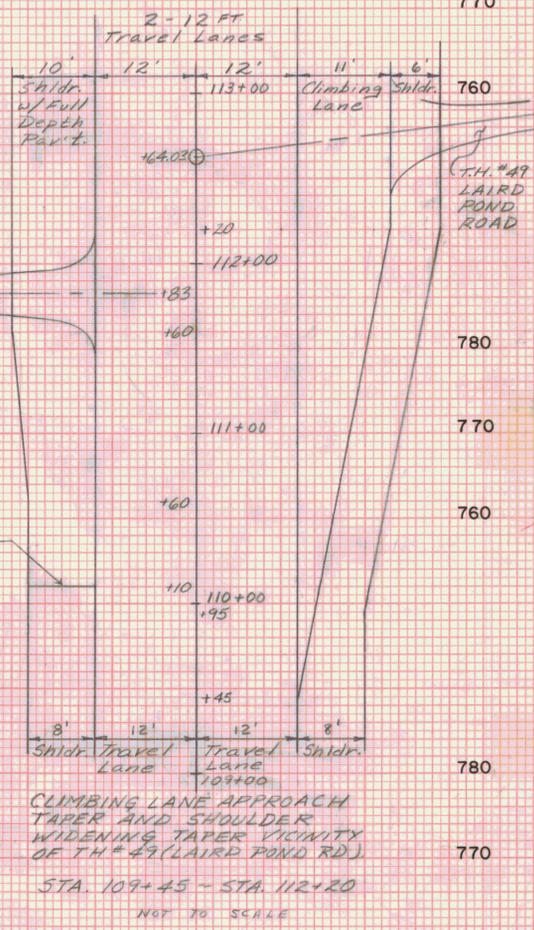

| | | | |
|--|------------|------|-----------|
| STA. | 108+50 | STA. | 110+00 |
| TOWN | MARSHFIELD | | |
| PROJECT | F | NO. | 028-3(28) |
| SHEET | 153 | OF | 352 |
| HORIZ. AND VERT. SCALE | | | |
| 0 10 20 | | | |
| SURVEYED BY: VT SURVEY CONSULTANTS DATE 8/86 | | | |

DATE
BY
REVIEWED
PLOTTED
TEMPERATURE
NOTE BOOK
NO.

DATE
BY
VT SURVEY CONSULTANTS
BRYANT ASSOC.
REVIEWED
PLOTTED
TEMPERATURE
NOTE BOOK
NO.

