


DATE  
BY  
SURVEYED  
PLOTTED  
AREA  
NO. FINAL SURVEY NOTE BOOK

DATE  
BY  
VT. SURVEY CONSULTANTS  
BRYANT ASSOC.  
SURVEYED  
PLOTTED  
AREA  
NO. ORIGINAL SURVEY NOTE BOOK

REV. STA. 114+00  
NEW 110" x 14'-5" x 9'-1" CGMPFA  
W/ REINFORCED CONC. HEADWALL @ INLET,  
CRADLE HEADWALL @ OUTLET, STRUCTURAL  
STEEL BAFFLES @ INVERT SPALED ACCORDING  
TO LAYOUT AND FILLED W/ 2' DEPTH OF NATURAL  
STREAM BED MATERIAL. SEE BR-100 PI AND  
DETAIL SHEETS.

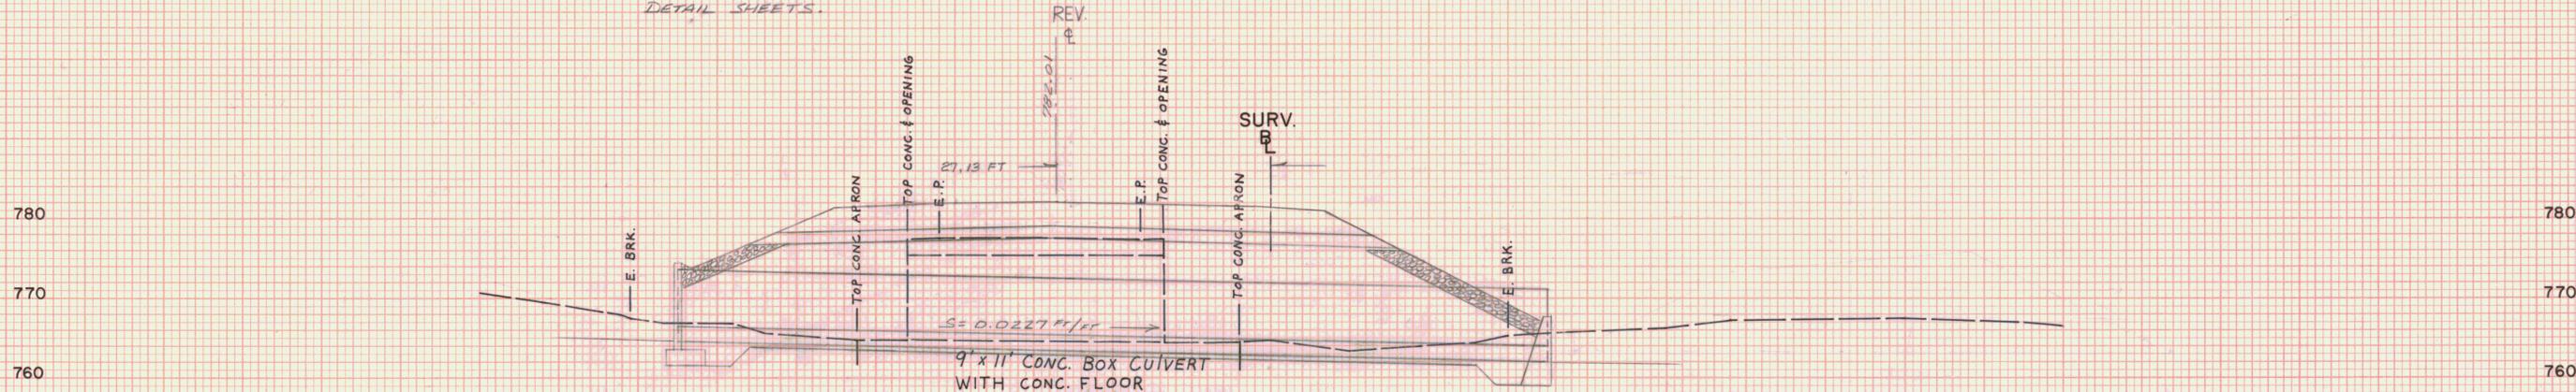

REV. STA. 112+93  
EXISTING STONE BOX CULVERT  
(TO BE REMOVED)

REV. 113+92.97 = SURV. 113 + 85  
ASKEWED @ 69°-48' LT.

STA. 113+85 STA.  
TOWN MARSHFIELD  
PROJECT F NO. 028-3(28)  
SHEET 160 OF 413 SHEETS  
HORIZ. AND VERT. SCALE  
0 10 20  
SURVEYED BY: VT SURVEY CONSULTANTS DATE 8/86