


DATE  
BY  
SURVEYED  
PLOTTED  
CHECKED  
AREAS CHECKED  
FINAL SURVEY NOTE BOOK No.

DATE  
BY  
VT. SURVEY CONSULTANTS  
BRYANT ASSOC.  
8/86  
9/86  
ORIGINAL SURVEY NOTE BOOK No.

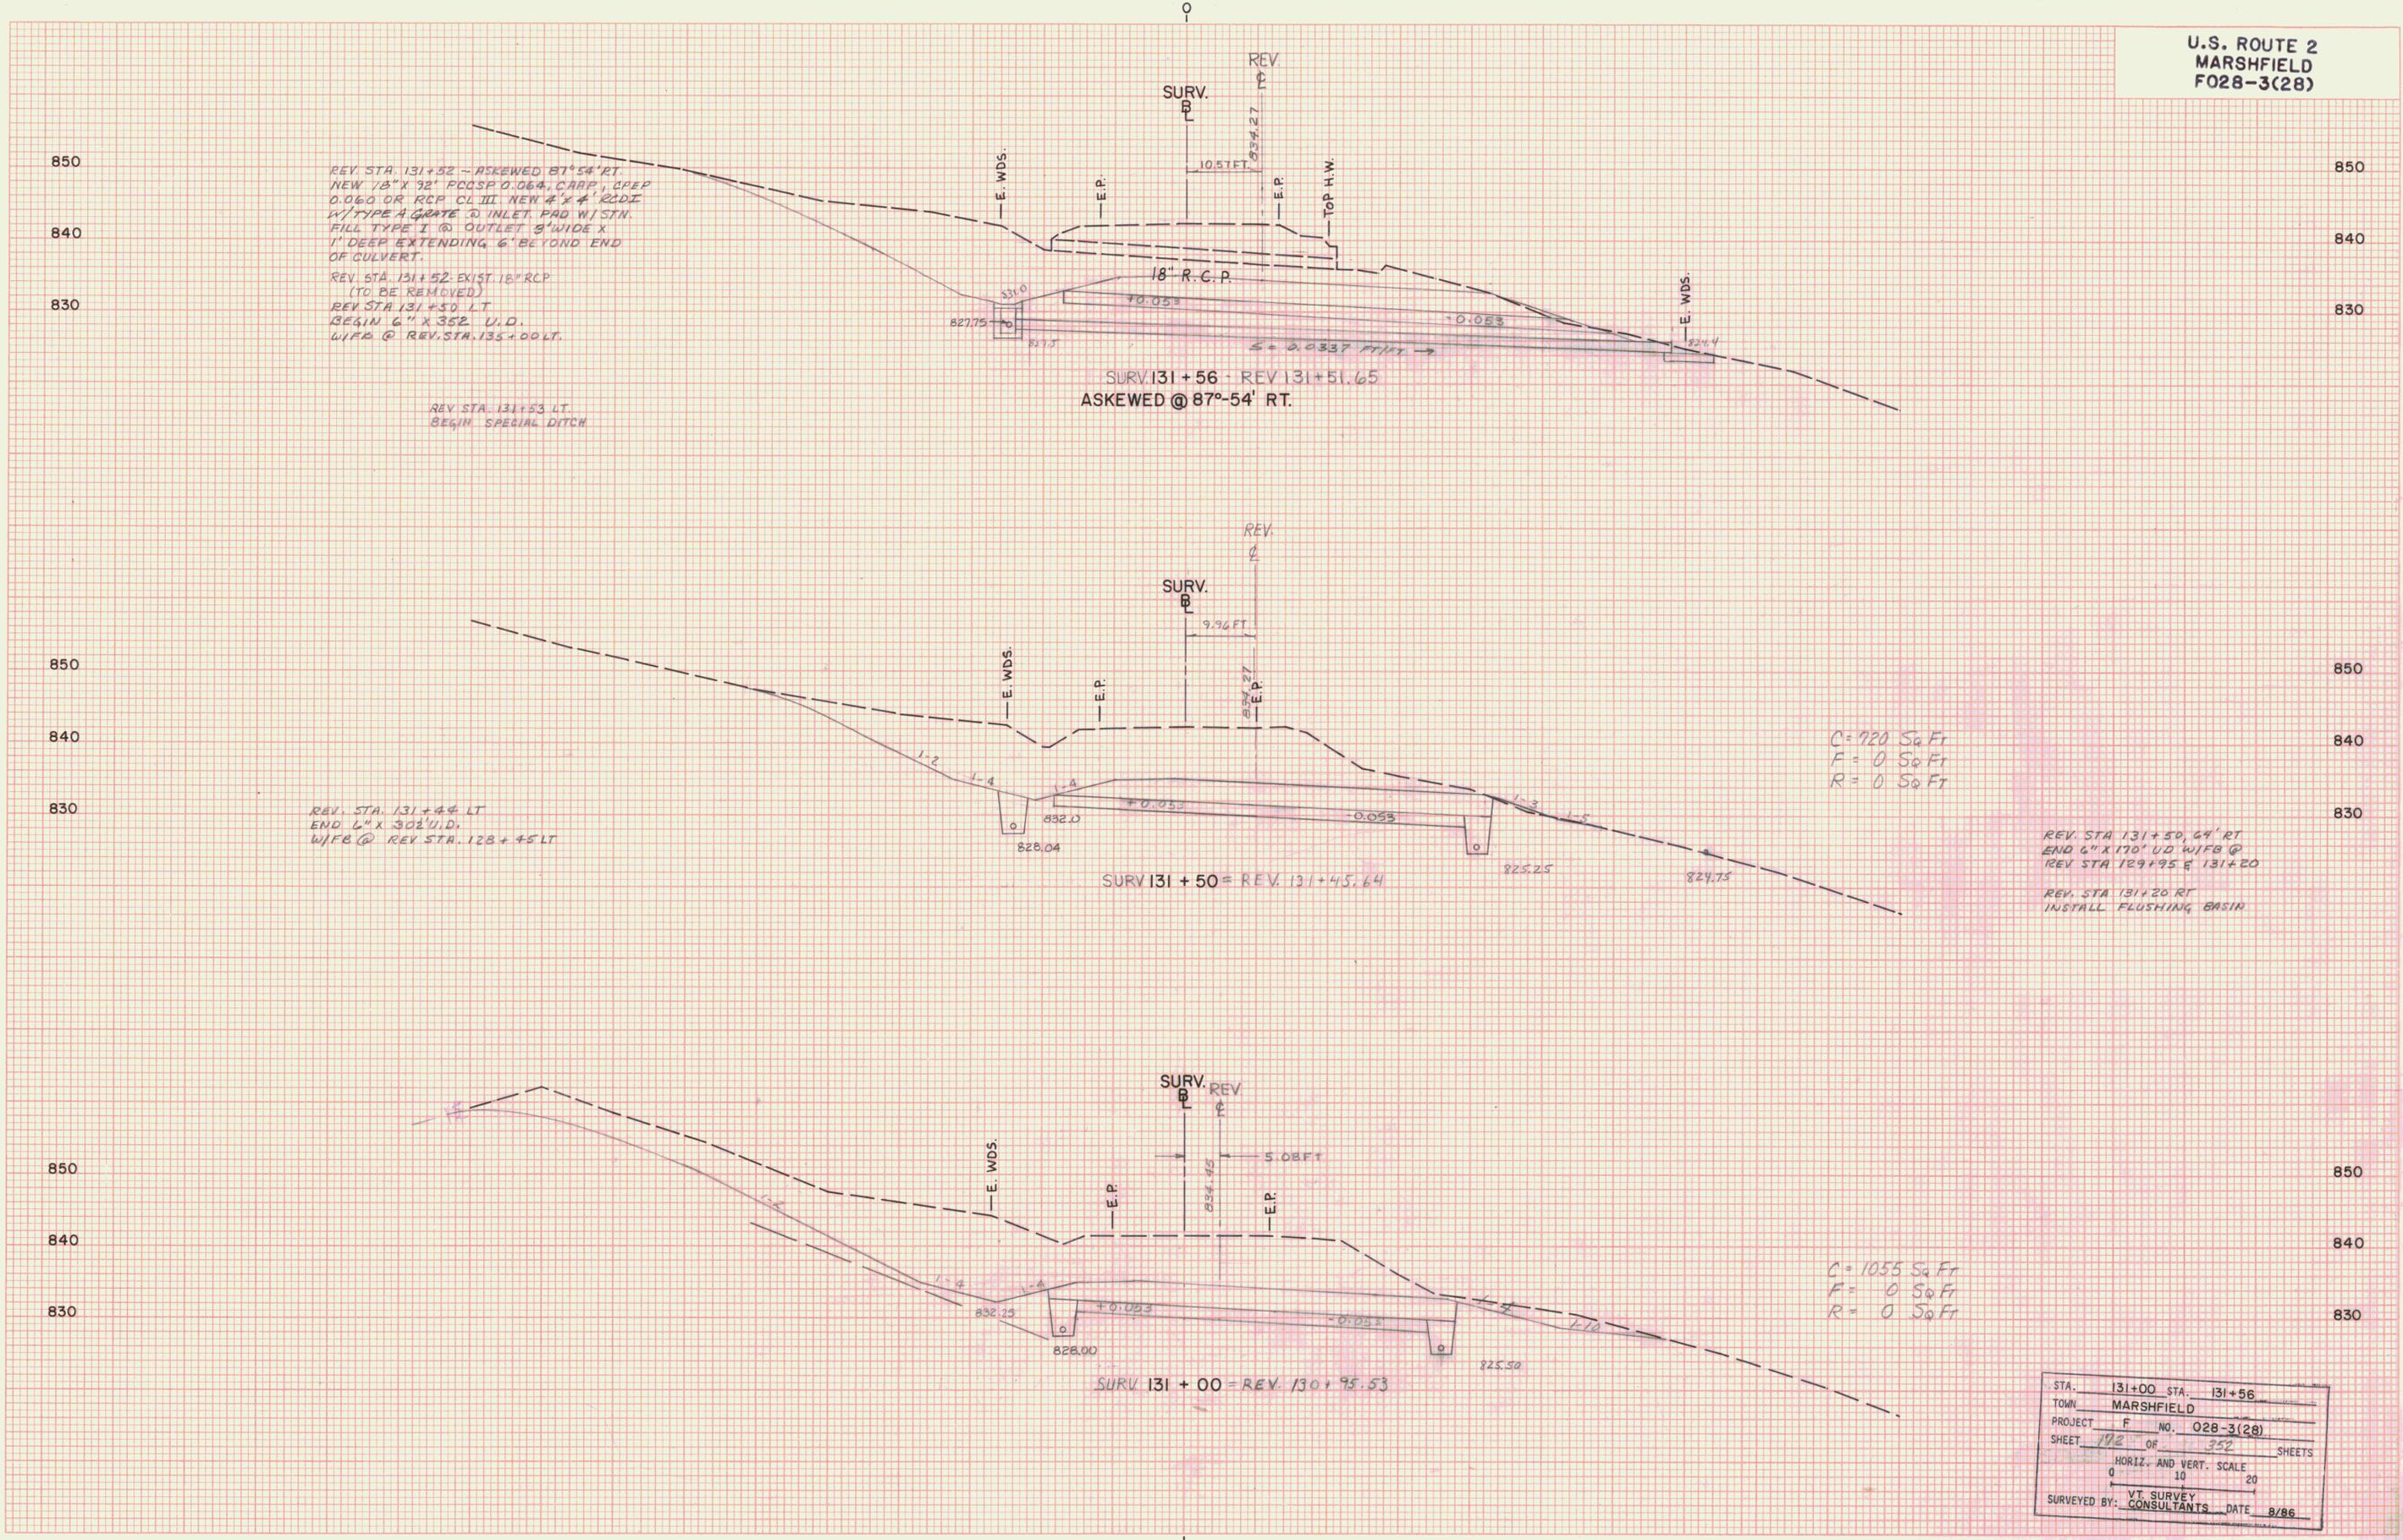

REV. STA. 131+52 - ASKEWED @ 87° 54' RT.  
NEW 18" X 92' PCOSP 0.064, CARP, CEP  
0.060 OR RCP CL III NEW 4' X 4' RCDI  
W/TYPE A GRATE @ INLET. PAD W/STN.  
FILL TYPE I @ OUTLET 3' WIDE X  
1' DEEP EXTENDING 6' BEYOND END  
OF CULVERT.  
REV. STA. 131+52 EXIST 18" RCP  
(TO BE REMOVED)  
REV. STA. 131+50 LT  
BEGIN 6" X 352 U.D.  
W/FB @ REV. STA. 135+00 LT.

REV. STA. 131+53 LT.  
BEGIN SPECIAL DITCH

SURV. 131+56 - REV. 131+51.65  
ASKEWED @ 87°-54' RT.

REV. STA. 131+44 LT  
END 6" X 302 U.D.  
W/FB @ REV. STA. 128+45 LT

SURV 131+50 = REV. 131+45.64

C = 920 Sq Ft  
F = 0 Sq Ft  
R = 0 Sq Ft

REV. STA. 131+50, 64' RT  
END 6" X 170' UD W/FB @  
REV. STA. 129+95 @ 131+20

REV. STA. 131+20 RT  
INSTALL FLUSHING BASIN

C = 1035 Sq Ft  
F = 0 Sq Ft  
R = 0 Sq Ft

SURV 131+00 = REV. 130+75.53

STA.	131+00	STA.	131+56
TOWN	MARSHFIELD		
PROJECT	F	NO.	028-3(28)
SHEET	192	OF	352 SHEETS
HORIZ. AND VERT. SCALE			
0		20	
10		20	
SURVEYED BY: VT SURVEY CONSULTANTS DATE 8/86			