

850
840
830
850
840
830
REV. STA 133+28 LT
BEGIN SPECIAL DITCH


17" GRAVEL MIN
1-7 1-9

133+00
A A

REV. STA 133+00 LT
CONSTRUCT DRIVE (20' WIDE)

20' VC

REV. STA 132+82 LT
END SPECIAL DITCH
END EROSION MATING

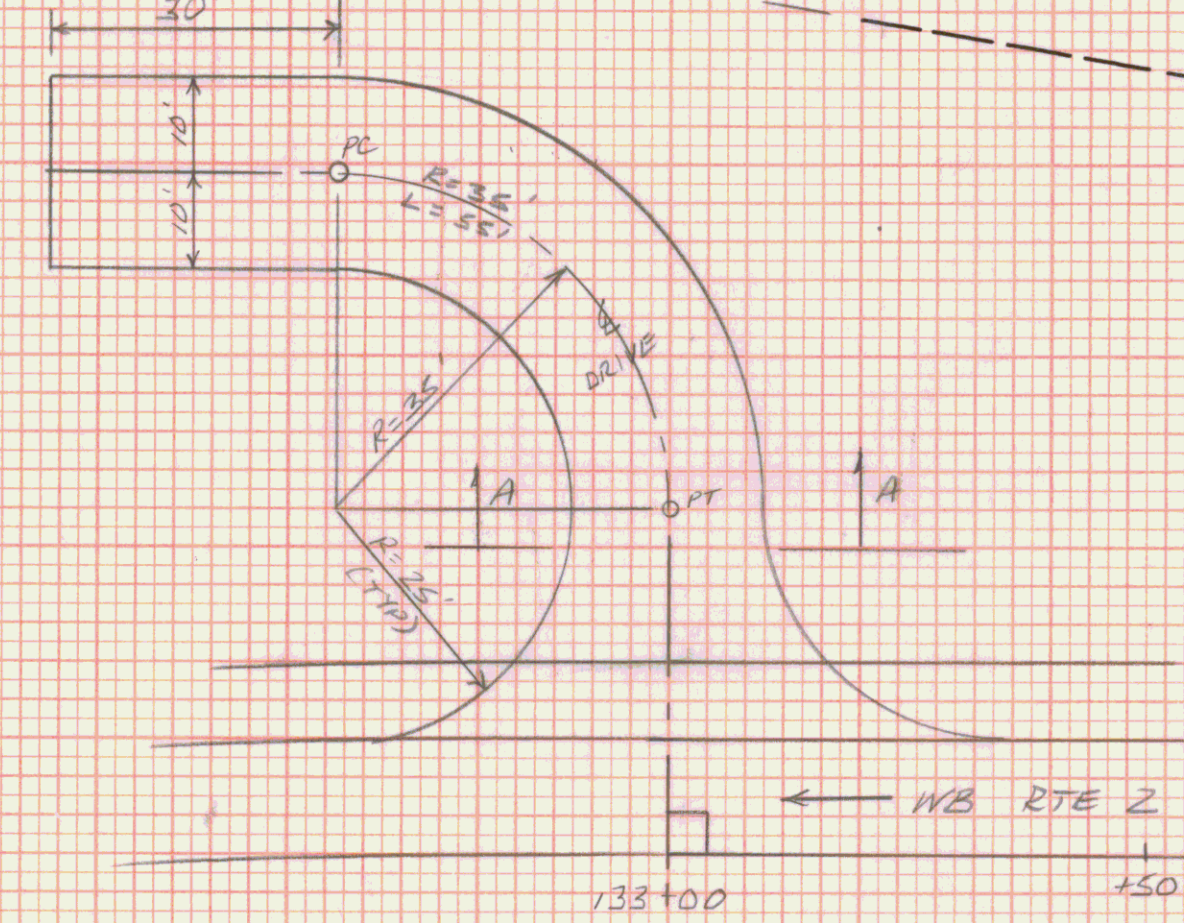

REV. STA 132+33 LT
BEGIN REMOVAL AND DISPOSAL
OF GUARDRAIL

SURV. B

REV. E

27.41 FT

832.25

828.75

834.87

SURV. 133+00 = REV. 132+95.75

27.96'

834.70

SURV. B

REV. E

21.12 FT

832.0

828.50

834.48

SURV. 132+50 = REV. 132+45.75

SURV. B

REV. E

15.30 FT

831.5

828.25

834.28

SURV. 132+00 = REV. 131+95.72

C = 516 Sq Ft
F = 14 Sq Ft
R = 0 Sq Ft

C = 670 Sq Ft
F = 5 Sq Ft
R = 0 Sq Ft

C = 889 Sq Ft
F = 0 Sq Ft
R = 0 Sq Ft

STA.	132+00	STA.	133+00
TOWN	MARSHFIELD		
PROJECT	F	NO.	028-3(28)
SHEET	178	OF	252
HORIZ. AND VERT. SCALE			
0 10 20			
SURVEYED BY: VT. SURVEY CONSULTANTS			
DATE 8/86			