


VT. SURVEY CONSULTANTS  
BRYANT ASSOC. 10/86 10/86

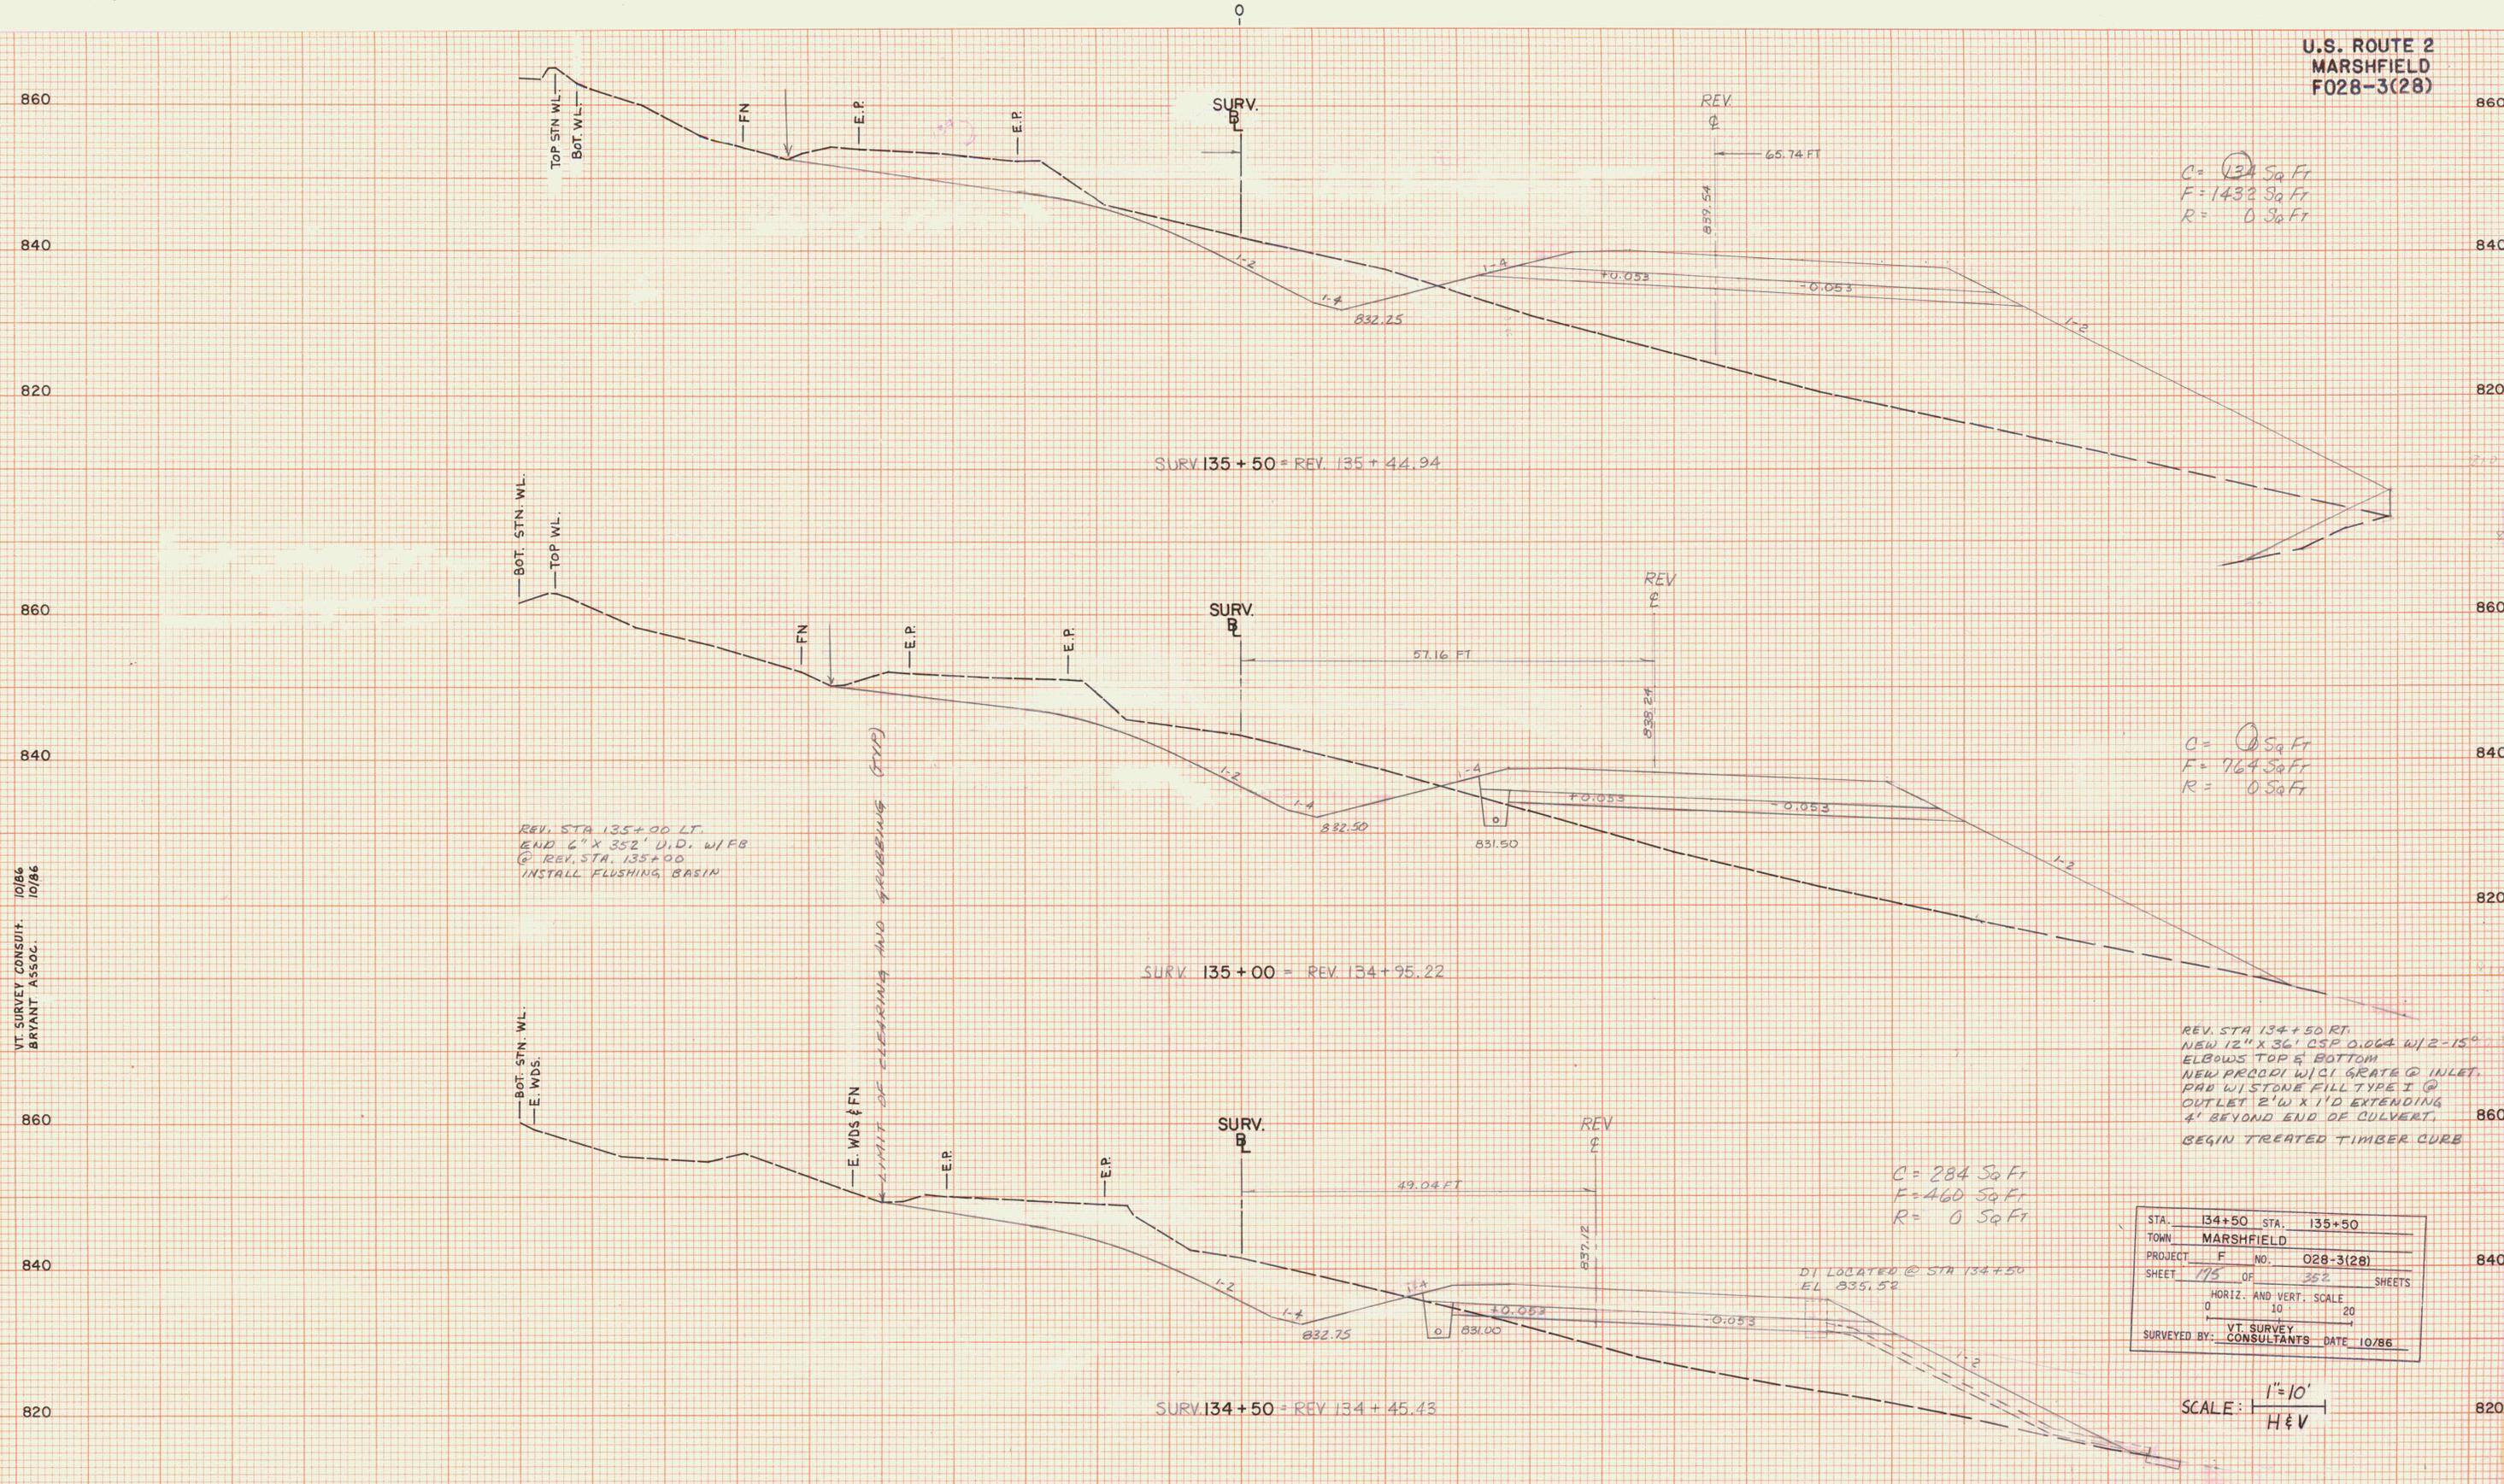

C = 137 Sq Ft  
F = 1432 Sq Ft  
R = 0 Sq Ft

C = 0 Sq Ft  
F = 764 Sq Ft  
R = 0 Sq Ft

C = 284 Sq Ft  
F = 460 Sq Ft  
R = 0 Sq Ft

REV. STA. 135+00 LT.  
END 6" X 352' U.D. W/ FB  
@ REV. STA. 135+00  
INSTALL FLUSHING BASIN

LIMIT OF CLEARING AND GRUBBING (LFG)

REV. STA. 134+50 RT.  
NEW 12" X 36' CSP 0.064 W/ 2-15°  
ELBOWS TOP & BOTTOM  
NEW PROODI W/ CI GRATE @ INLET.  
PAD W/ STONE FILL TYPE I @  
OUTLET 2' W X 1' D EXTENDING  
4' BEYOND END OF CULVERT.  
BEGIN TREATED TIMBER CURB

STA.	134+50	STA.	135+50
TOWN	MARSHFIELD		
PROJECT	F	NO.	028-3(28)
SHEET	175	OF	352 SHEETS
HORIZ. AND VERT. SCALE			
0 10 20			
SURVEYED BY: VT SURVEY CONSULTANTS DATE 10/86			

SCALE: 1" = 10'  
H & V