


DATE _____
BY _____
SURVEYED _____
PLOTTED _____
FINAL SURVEY NOTE BOOK NO. _____
AREAS CHECKED _____

DATE _____
BY _____
SURVEYED _____
PLOTTED _____
ORIGINAL SURVEY NOTE BOOK NO. _____
AREAS CHECKED _____

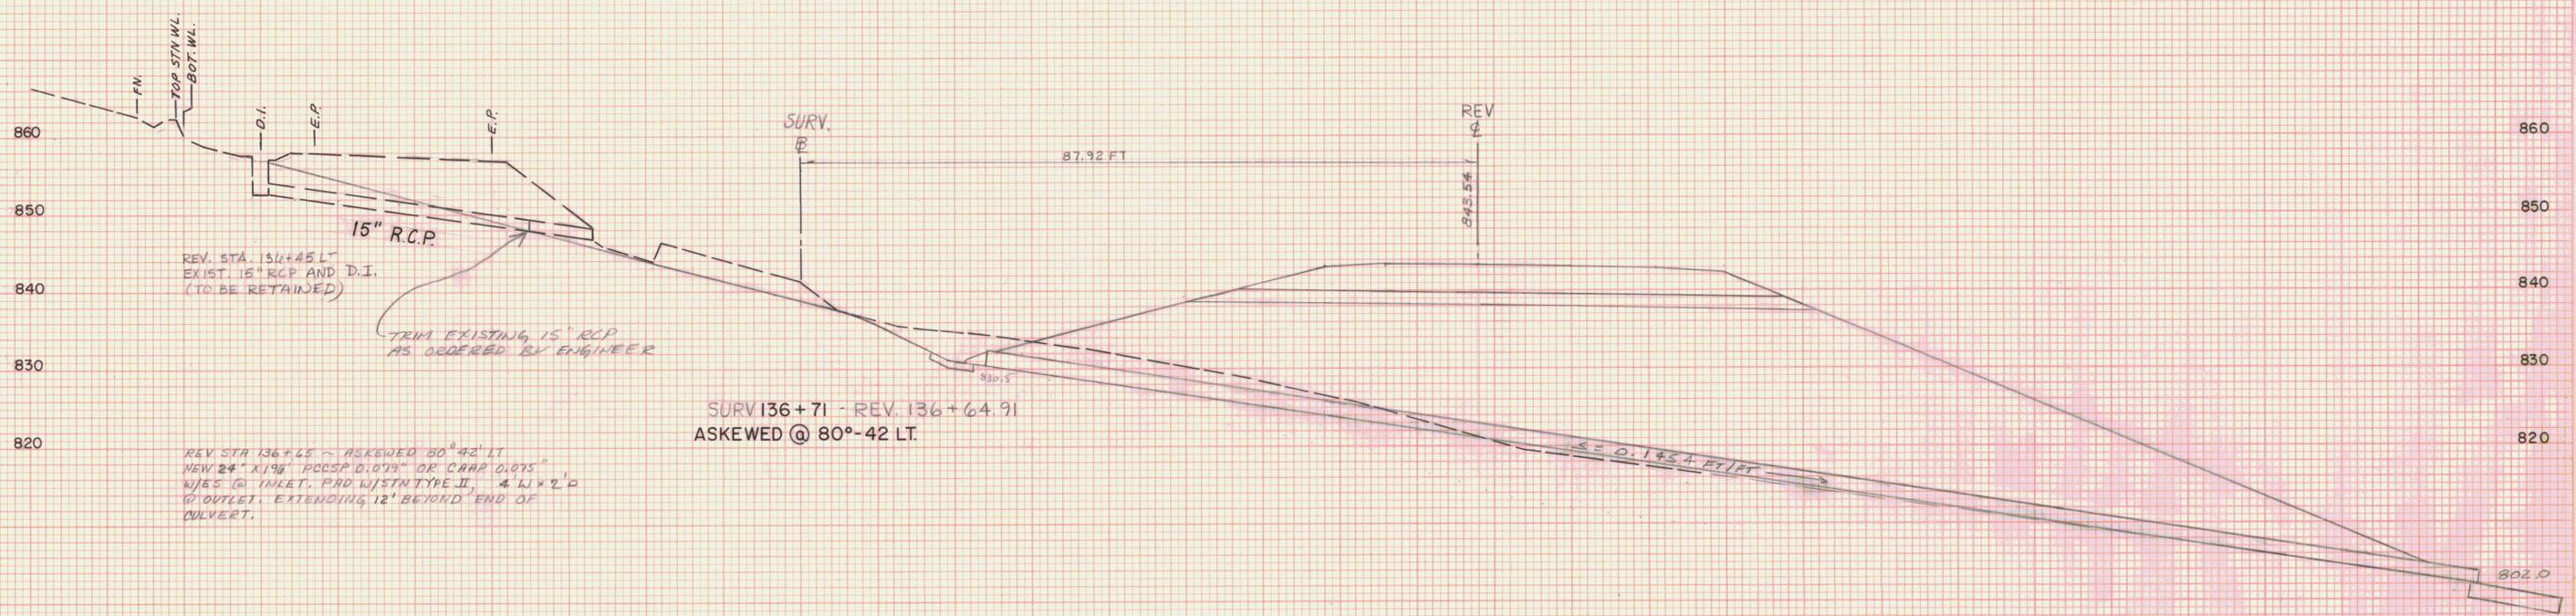

REV. STA 134+45 L'
EXIST. 15" R.C.P. AND D.I.
(TO BE RETAINED)

TRIM EXISTING 15" R.C.P.
AS ORDERED BY ENGINEER

SURV 136+71 - REV. 136+64.91
ASKEWED @ 80°-42' LT.

REV STA 136+65 ~ ASKEWED 80° 42' LT
NEW 24" X 19" PCCSP 0.079" OR CORR 0.075"
W/ES @ INLET, PRO W/STN TYP E II, 4' W X 2' D
@ OUTLET, EXTENDING 12' BEYOND END OF
CULVERT.

SE 0.1454 FT/FT

STA. 136+71 STA. _____
TOWN MARSHFIELD
PROJECT F NO. 028-3(28)
SHEET 177 OF 182 SHEETS
HORIZ. AND VERT. SCALE
0 10 20
VT SURVEY
SURVEYED BY: CONSULTANTS DATE 10/86