


DATE _____ BY _____
 SURVEYED _____
 TEMPLATE _____
 AREA _____
 FINAL SURVEY NOTE BOOK NO. _____

DATE _____ BY _____
 SURVEYED _____
 TEMPLATE _____
 AREA _____
 ORIGINAL SURVEY NOTE BOOK NO. _____

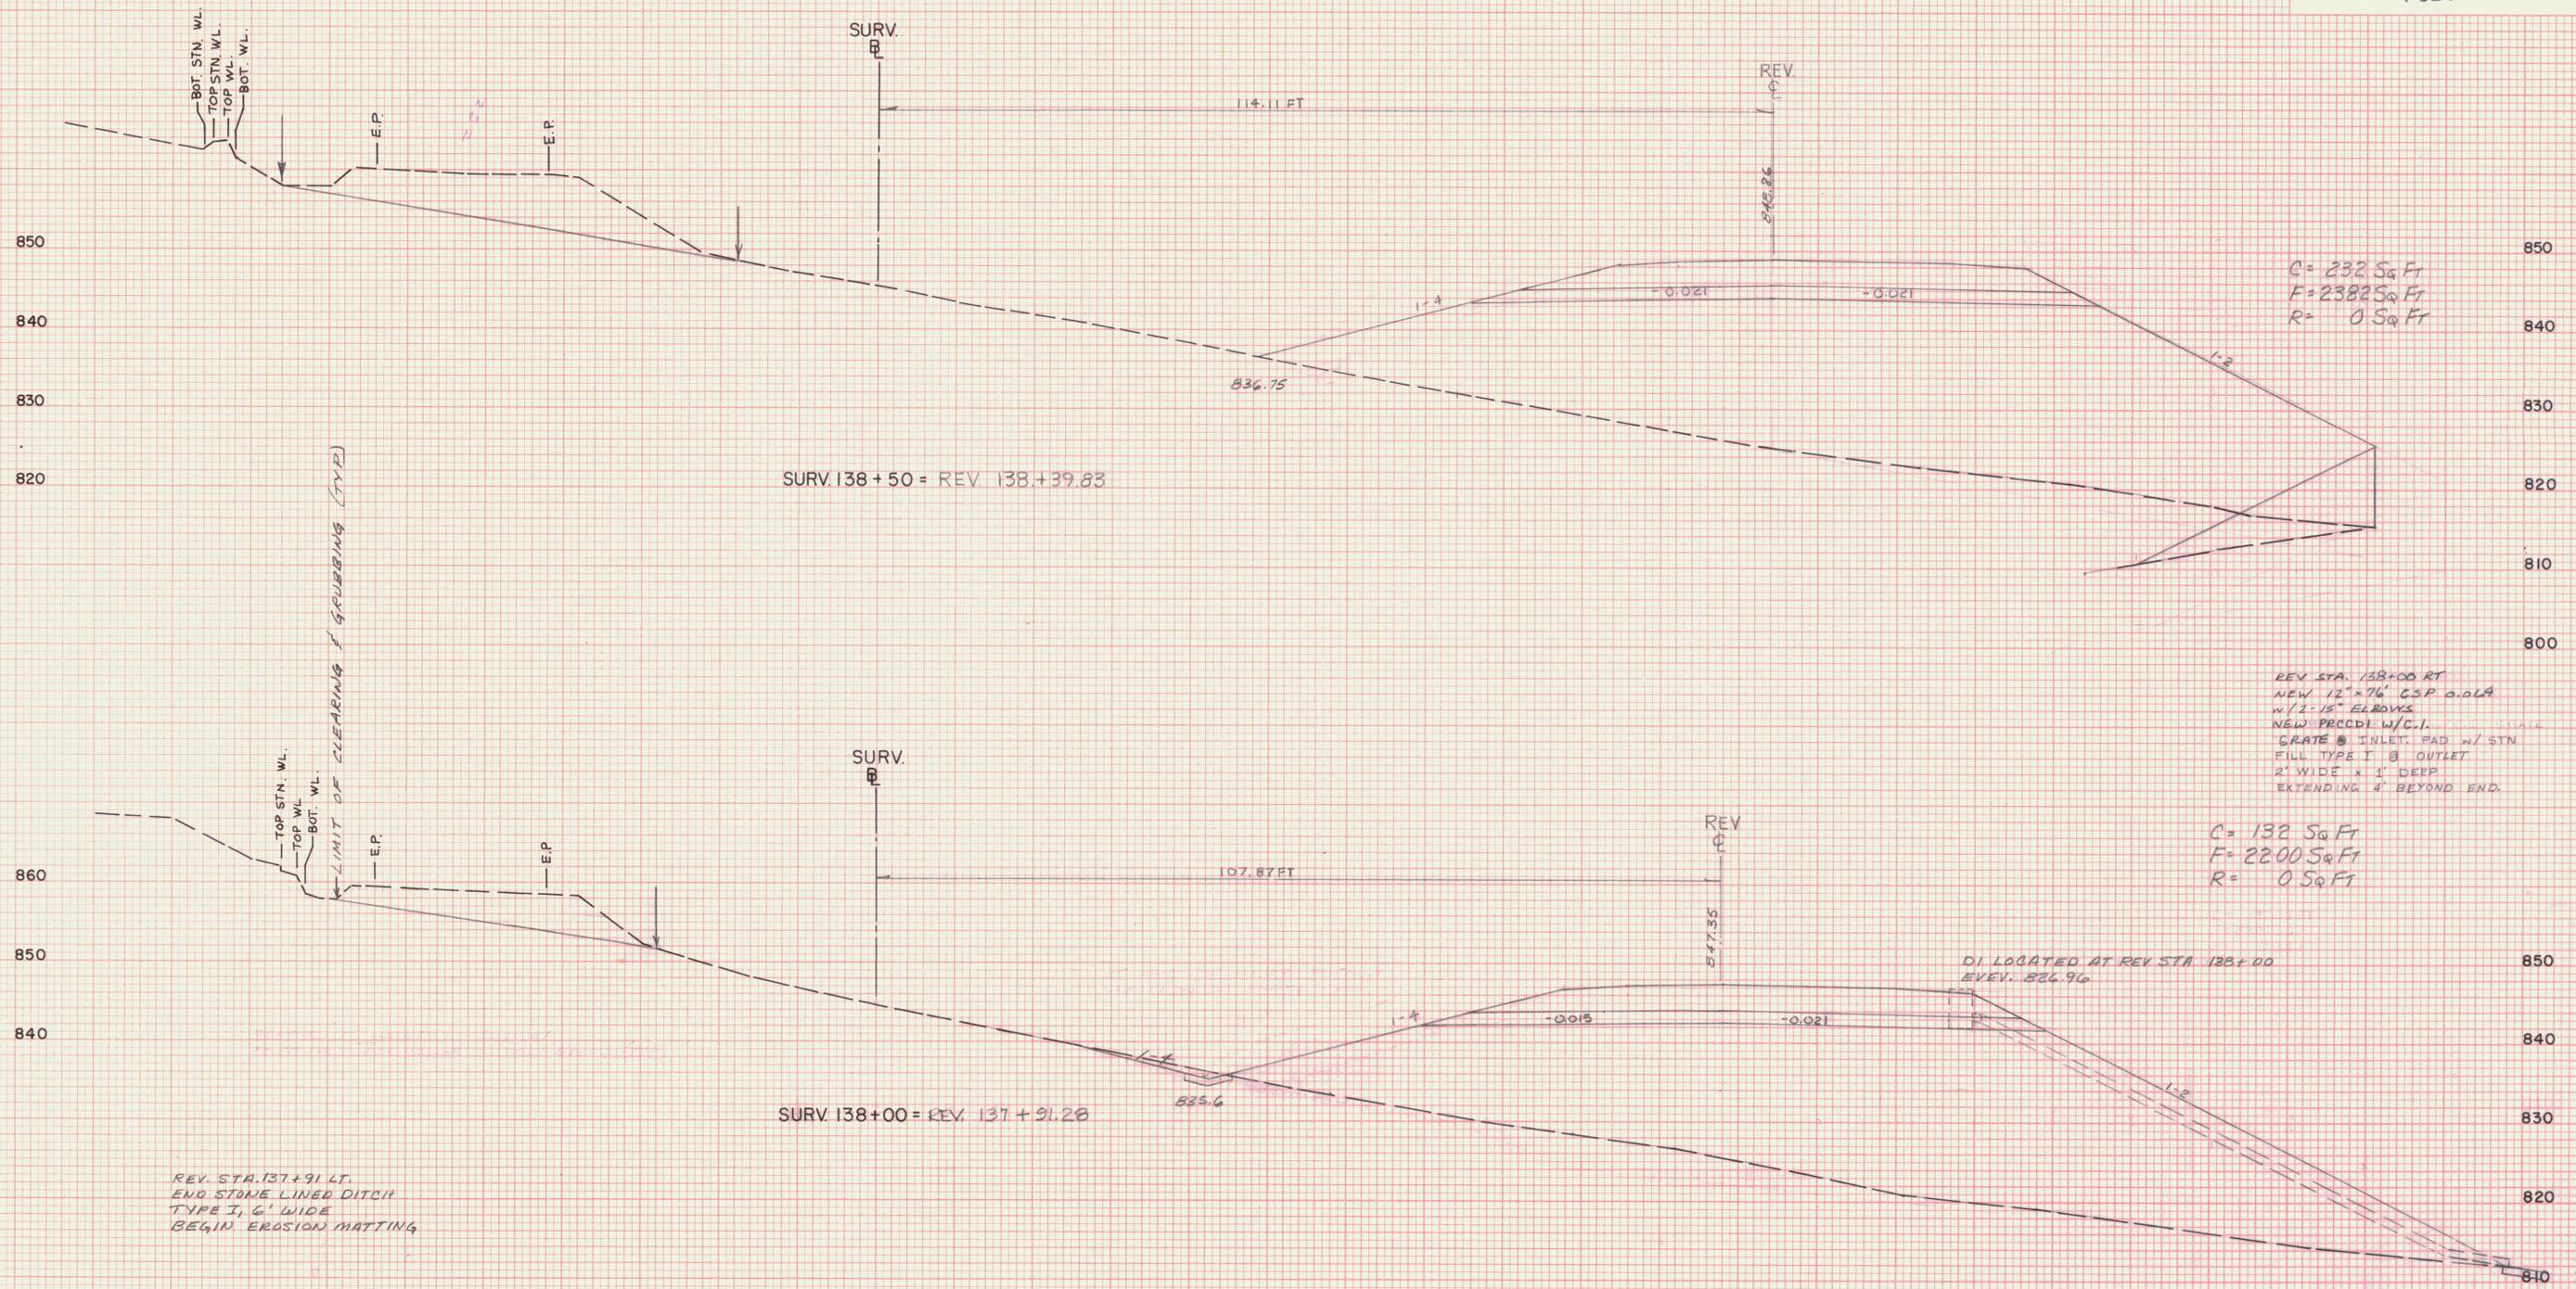

C = 232 Sq Ft
 F = 2382 Sq Ft
 R = 0 Sq Ft

REV STA. 138+00 RT
 NEW 12" x 76" CSP 0.014
 w/ 12-15" ELBOWS
 NEW PECCDI w/C.I.
 GRATE @ INLET, PAD w/ STN
 FILL TYPE T @ OUTLET
 2' WIDE x 4' DEEP
 EXTENDING 4' BEYOND END.

C = 132 Sq Ft
 F = 2200 Sq Ft
 R = 0 Sq Ft

REV. STA. 137+91 LT.
 END STONE LINED DITCH
 TYPE I, 6' WIDE
 BEGIN EROSION MATTING

STA. 138+00	STA. 138+50
TOWN MARSHFIELD	
PROJECT F	NO. 028-3(28)
SHEET 129	OF 132 SHEETS
HORIZ. AND VERT. SCALE	
0	10 20
VT SURVEY	
SURVEYED BY: CONSULTANTS	DATE 10/86