

FINAL SURVEY NOTE BOOK NO. _____

SURVEYED BY _____ DATE _____

TEMPERATURE _____


AREA CHECKED _____

ORIGINAL SURVEY NOTE BOOK NO. _____

SURVEYED BY _____ DATE _____

TEMPERATURE _____

AREA CHECKED _____

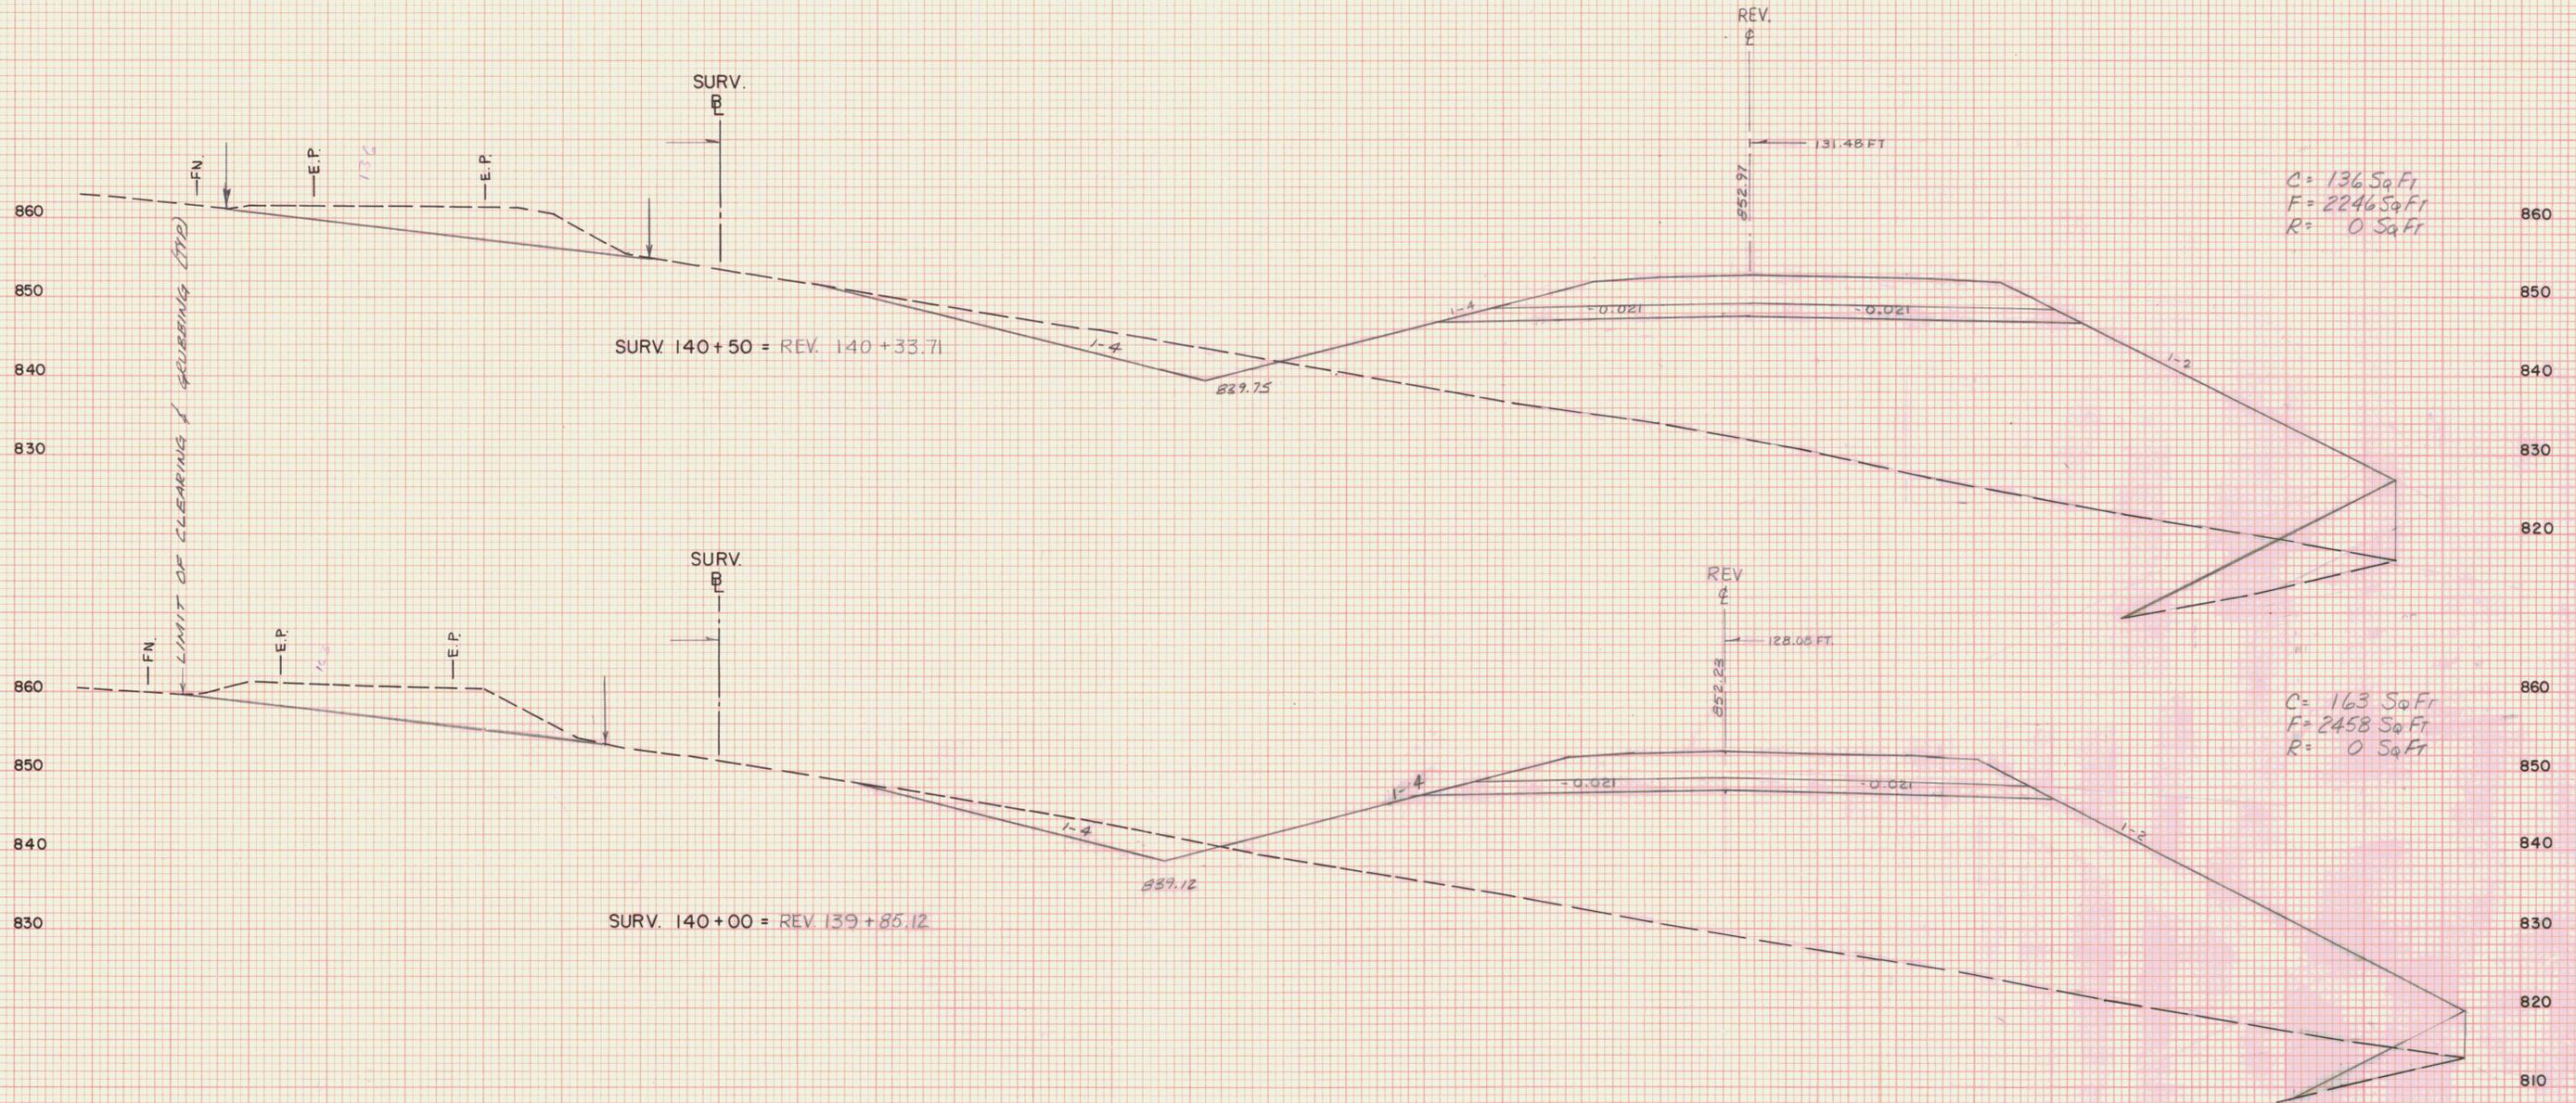

C = 136 Sq Ft
F = 2246 Sq Ft
R = 0 Sq Ft

C = 163 Sq Ft
F = 2458 Sq Ft
R = 0 Sq Ft

| | |
|--------------------------|---------------|
| STA. 140+00 | STA. 140+50 |
| TOWN MARSHFIELD | |
| PROJECT F | NO. 028-3(28) |
| SHEET 182 | OF 352 SHEETS |
| HORIZ. AND VERT. SCALE | |
| 0 10 20 | |
| VT. SURVEY | |
| SURVEYED BY: CONSULTANTS | DATE 10/86 |