


FINAL SURVEY	SURVEYED	DATE
	NOTED	BY
	NO.	
	AREA CHECKED	

ORIGINAL SURVEY	SURVEYED	DATE
	NOTED	BY
	NO.	
	AREA CHECKED	

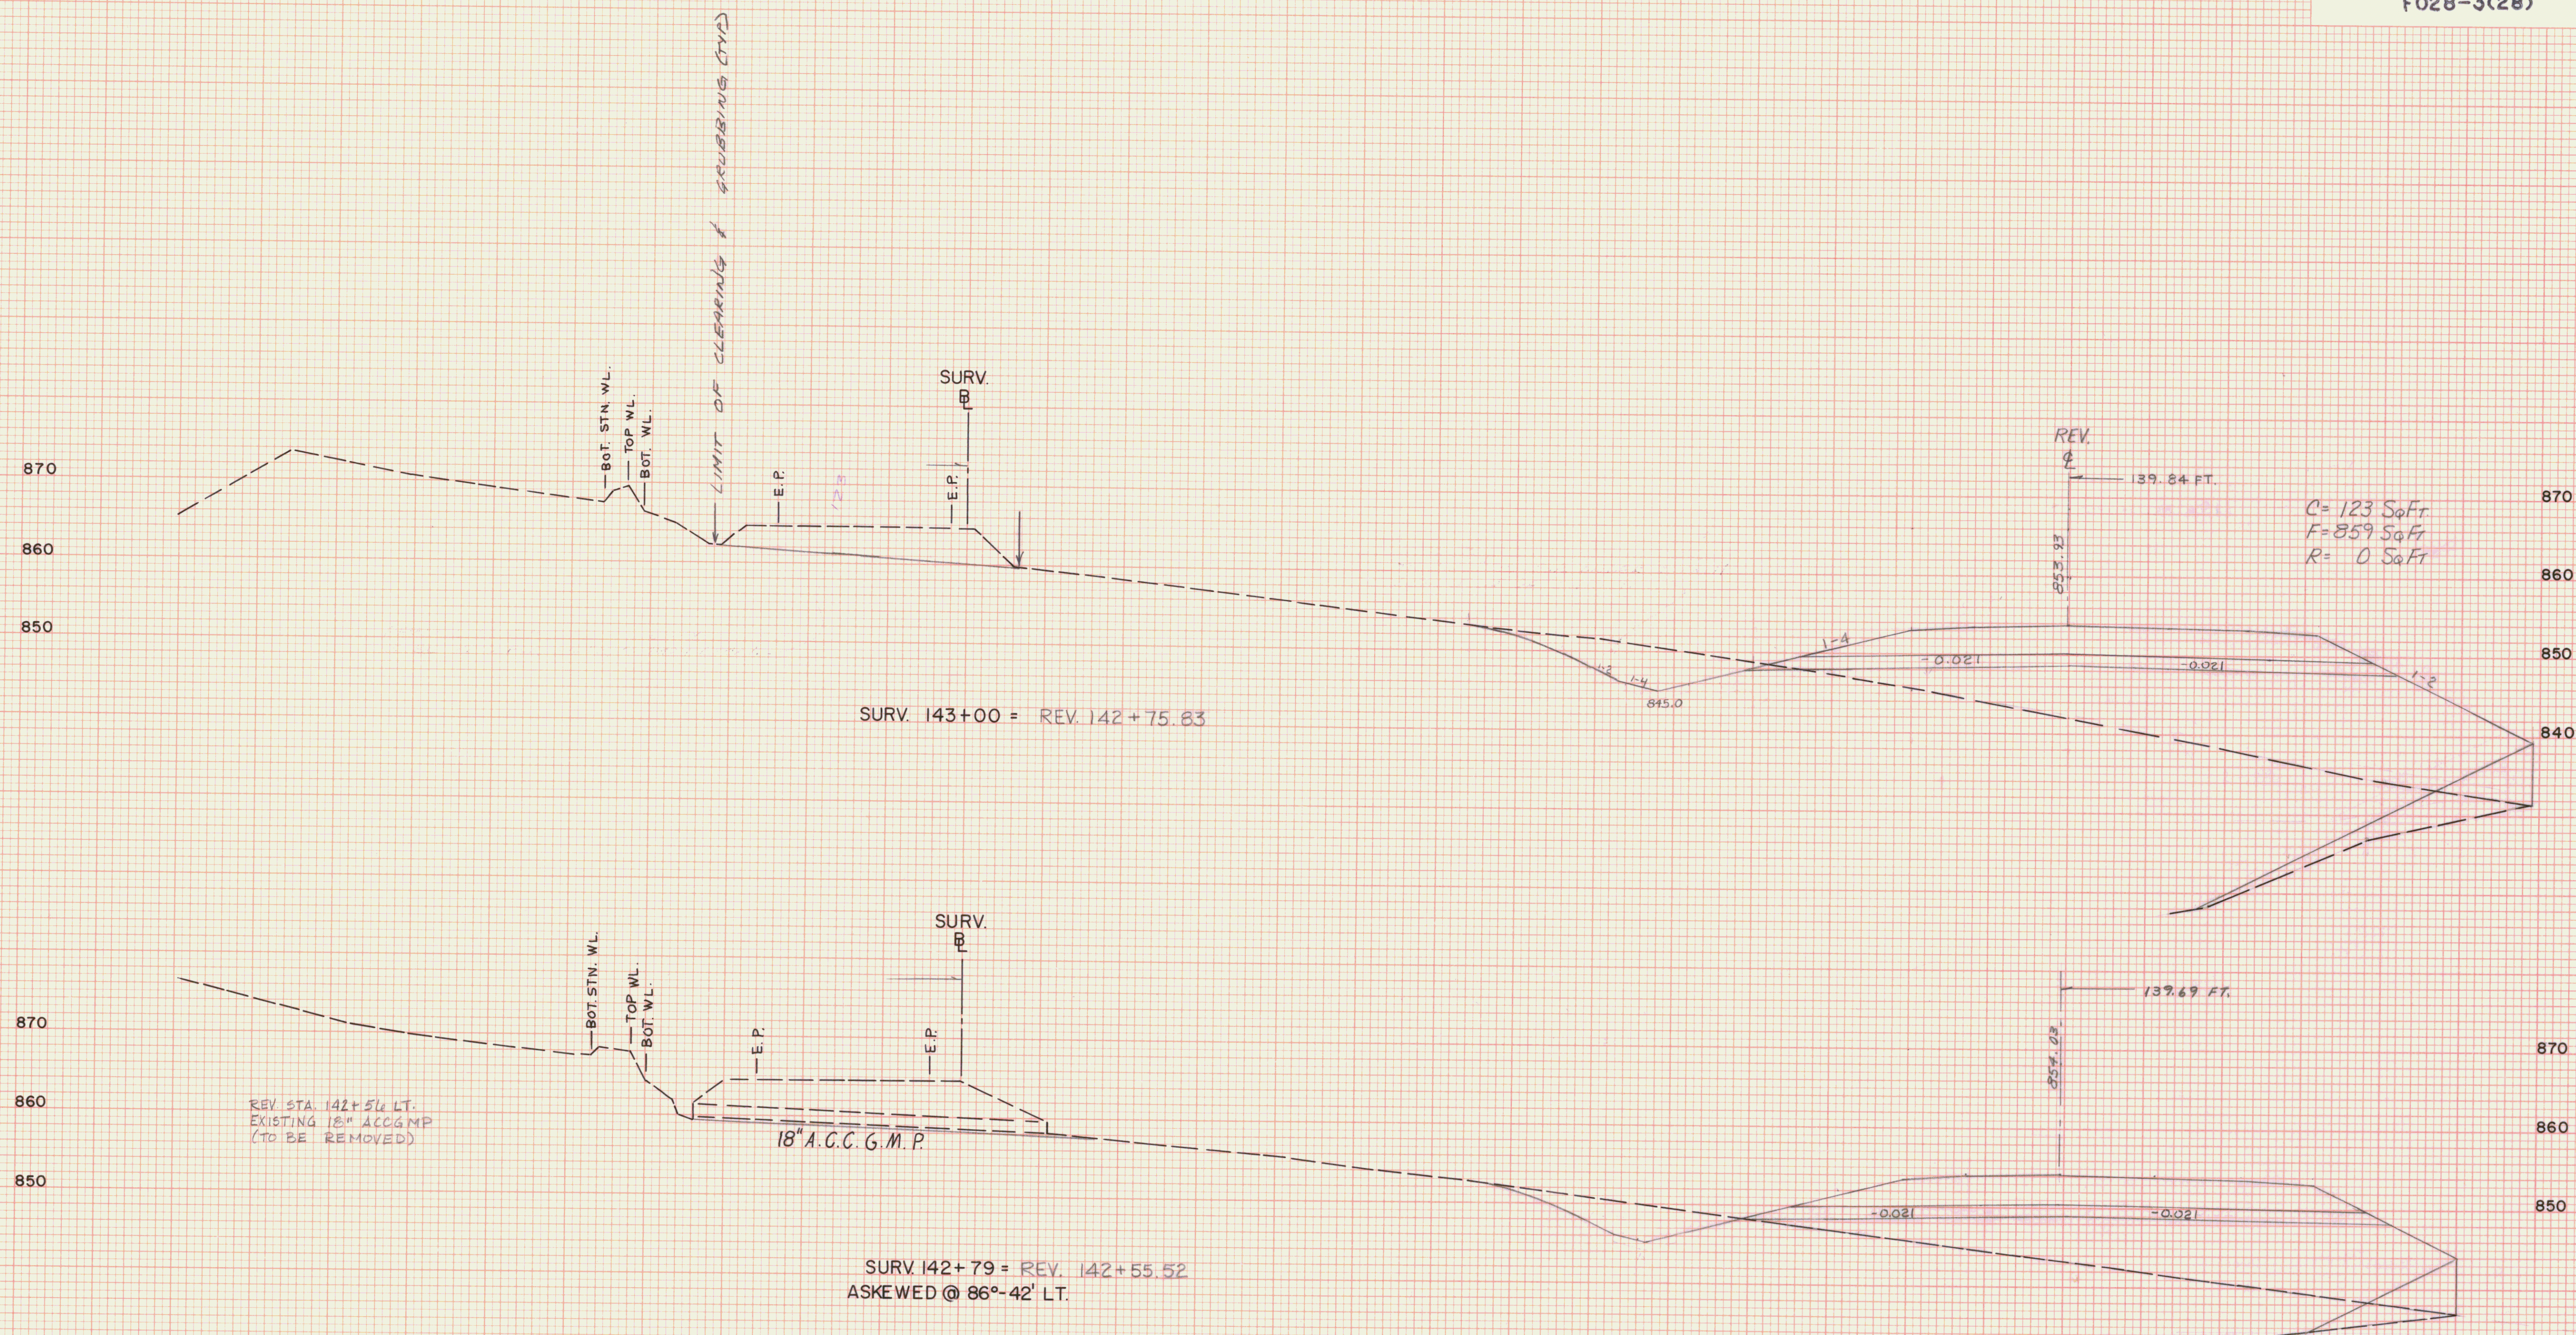

STA. 142+79	STA. 143+00
TOWN MARSHFIELD	
PROJECT F	NO. 028-3(28)
SHEET 155	OF 352 SHEETS
HORIZ. AND VERT. SCALE	
VT. SURVEY	
SURVEYED BY: CONSULTANTS	DATE 10/86