


DATE _____ BY _____
 SURVEYED BY _____
 ORIGINAL SURVEY NO. _____
 NOTE BOOK NO. _____
 AREA CHECKED _____

DATE _____ BY _____
 SURVEYED BY _____
 ORIGINAL SURVEY NO. _____
 NOTE BOOK NO. _____
 AREA CHECKED _____

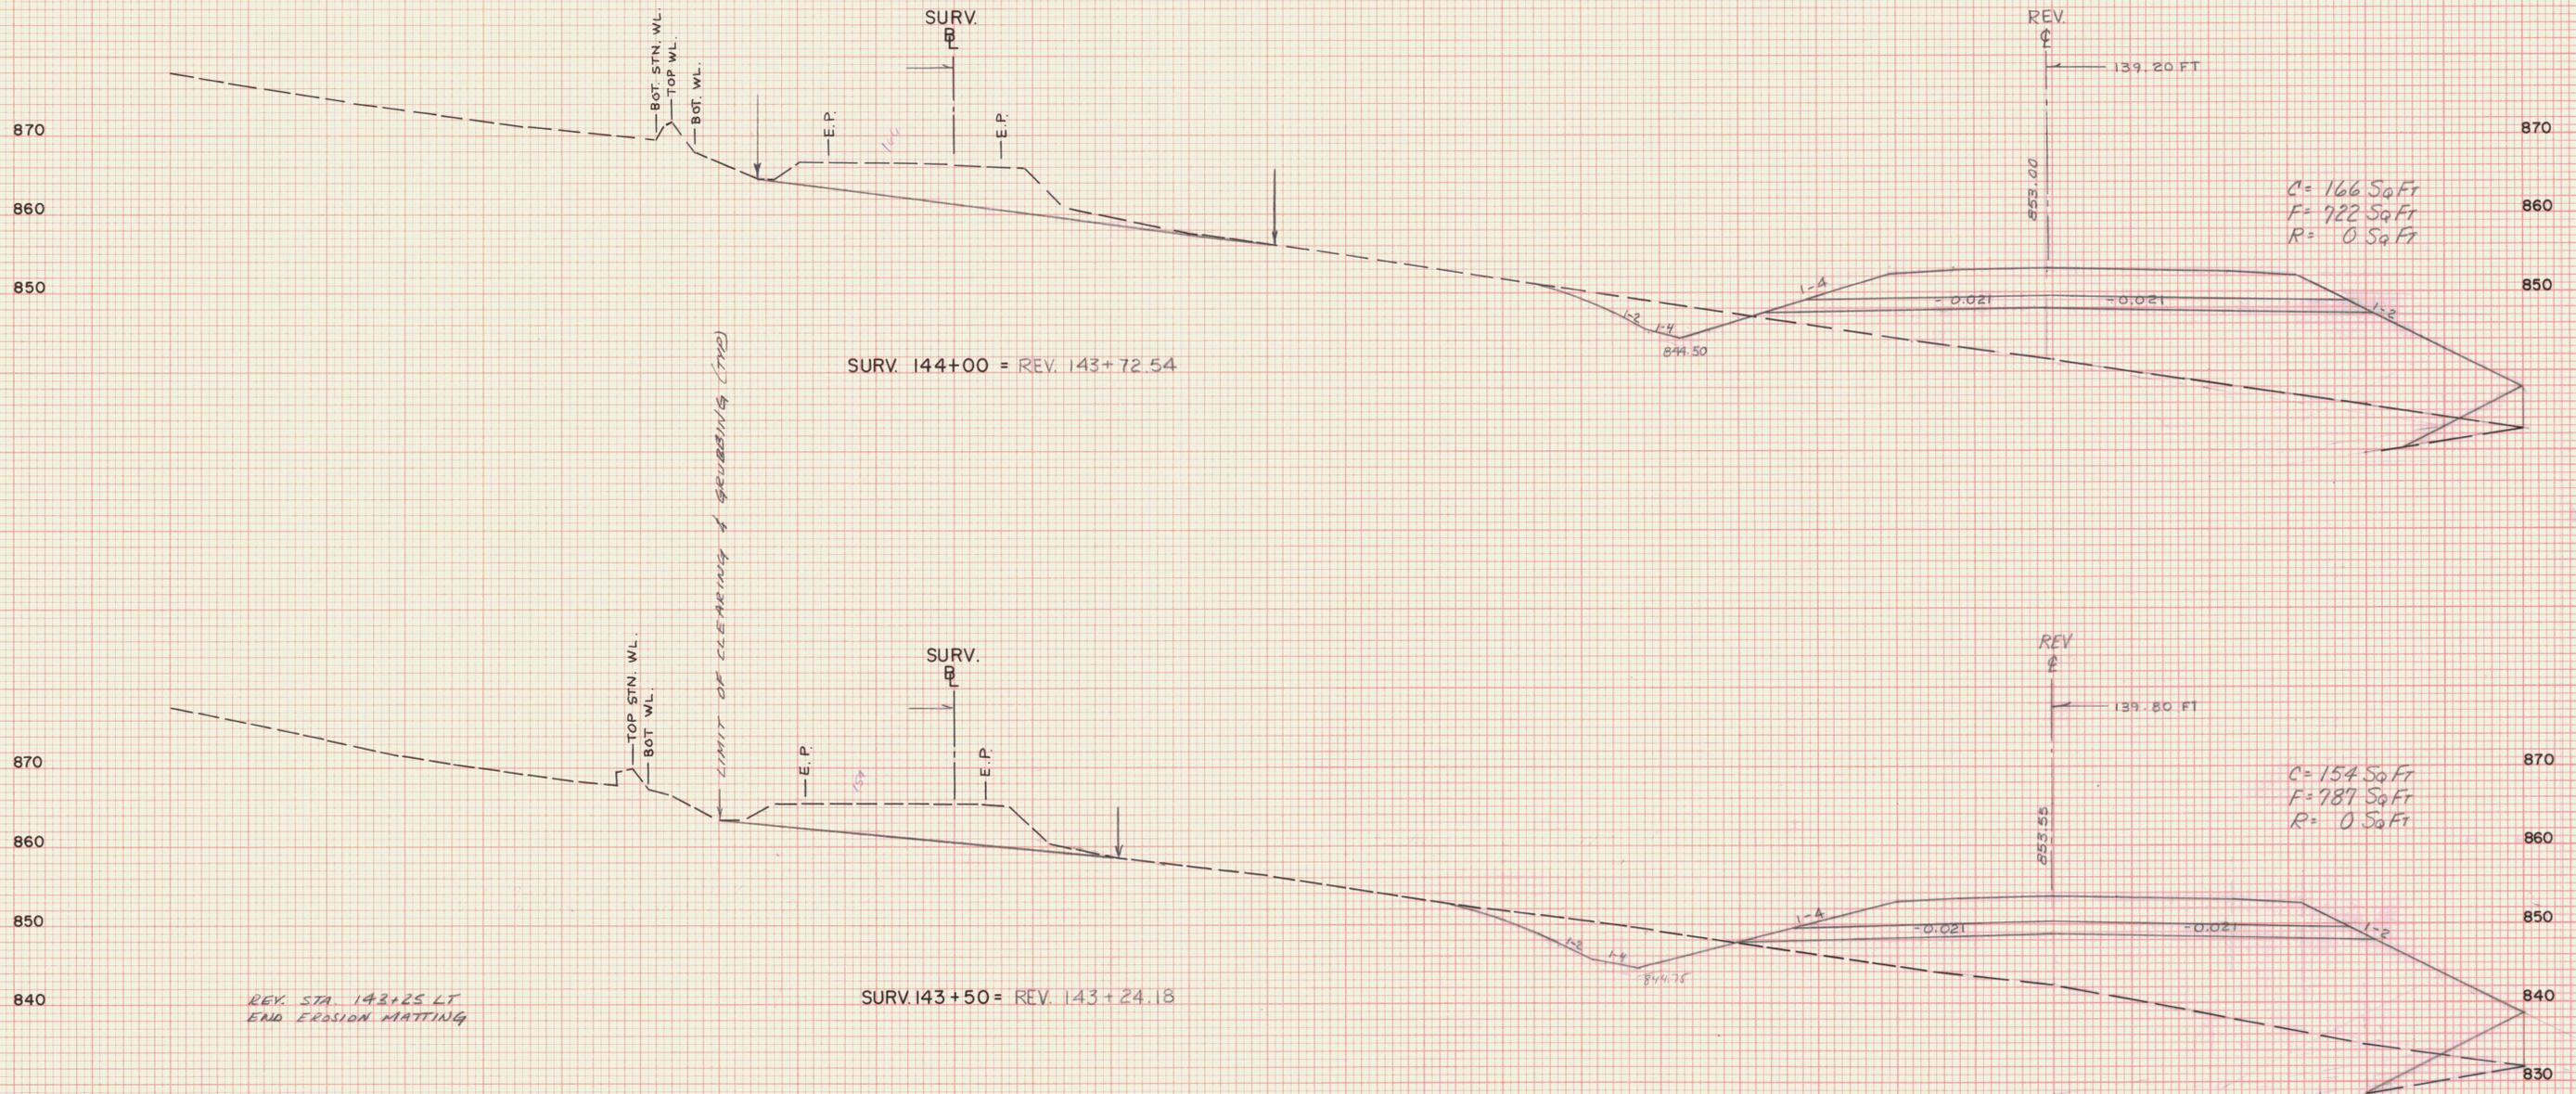

REV. STA. 142+25 LT
END EROSION MATTING

STA. 143+50	STA. 144+00
TOWN MARSHFIELD	
PROJECT F	NO. 028-3(28)
SHEET 186	OF 362 SHEETS
HORIZ. AND VERT. SCALE	
0 10 20	
VT SURVEY	
SURVEYED BY: CONSULTANTS	DATE 10/86