

FINAL SURVEY NOTE BOOK No. _____

DATE _____ BY _____

REVIEWED _____ PLOTTED _____

REVISIONS _____

AREA CHECKED _____


ORIGINAL SURVEY NOTE BOOK No. _____

DATE _____ BY _____

REVIEWED _____ PLOTTED _____

REVISIONS _____

AREA CHECKED _____

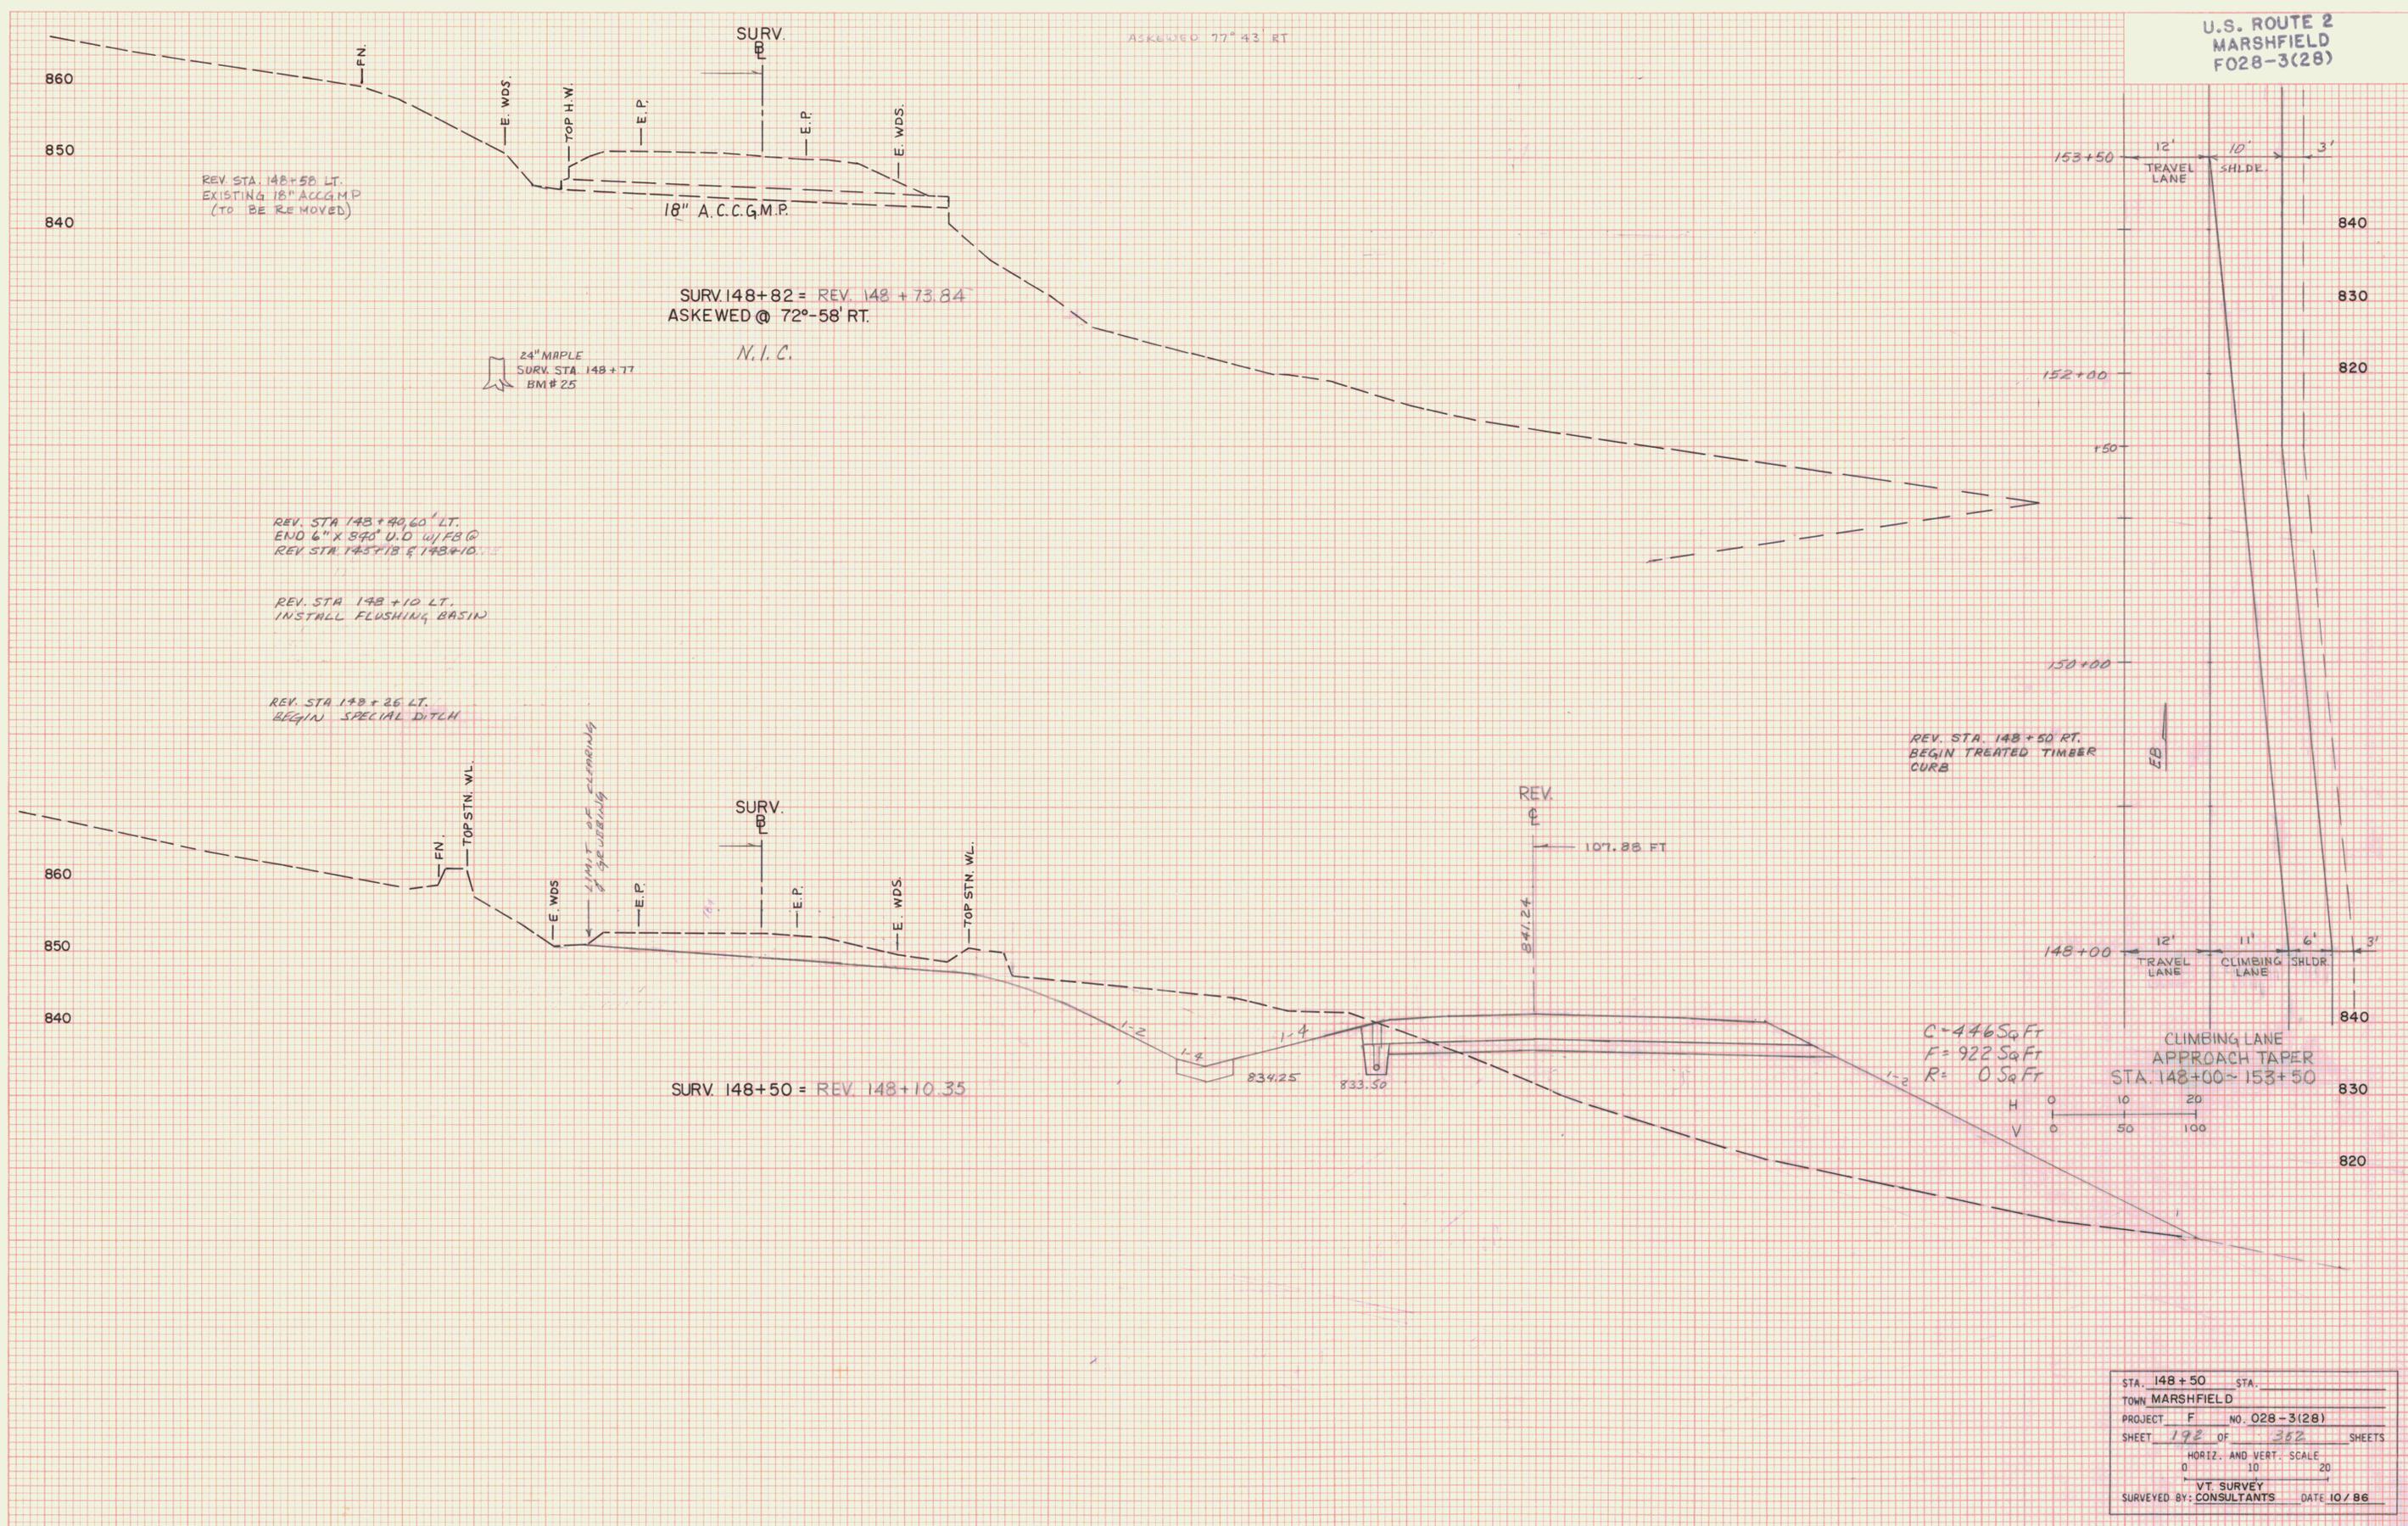

STA. 148+50	STA.
TOWN MARSHFIELD	
PROJECT F	NO. 028-3(28)
SHEET 192	OF 302 SHEETS
HORIZ. AND VERT. SCALE	
0	10 20
VT. SURVEY	
SURVEYED BY: CONSULTANTS DATE 10/86	