



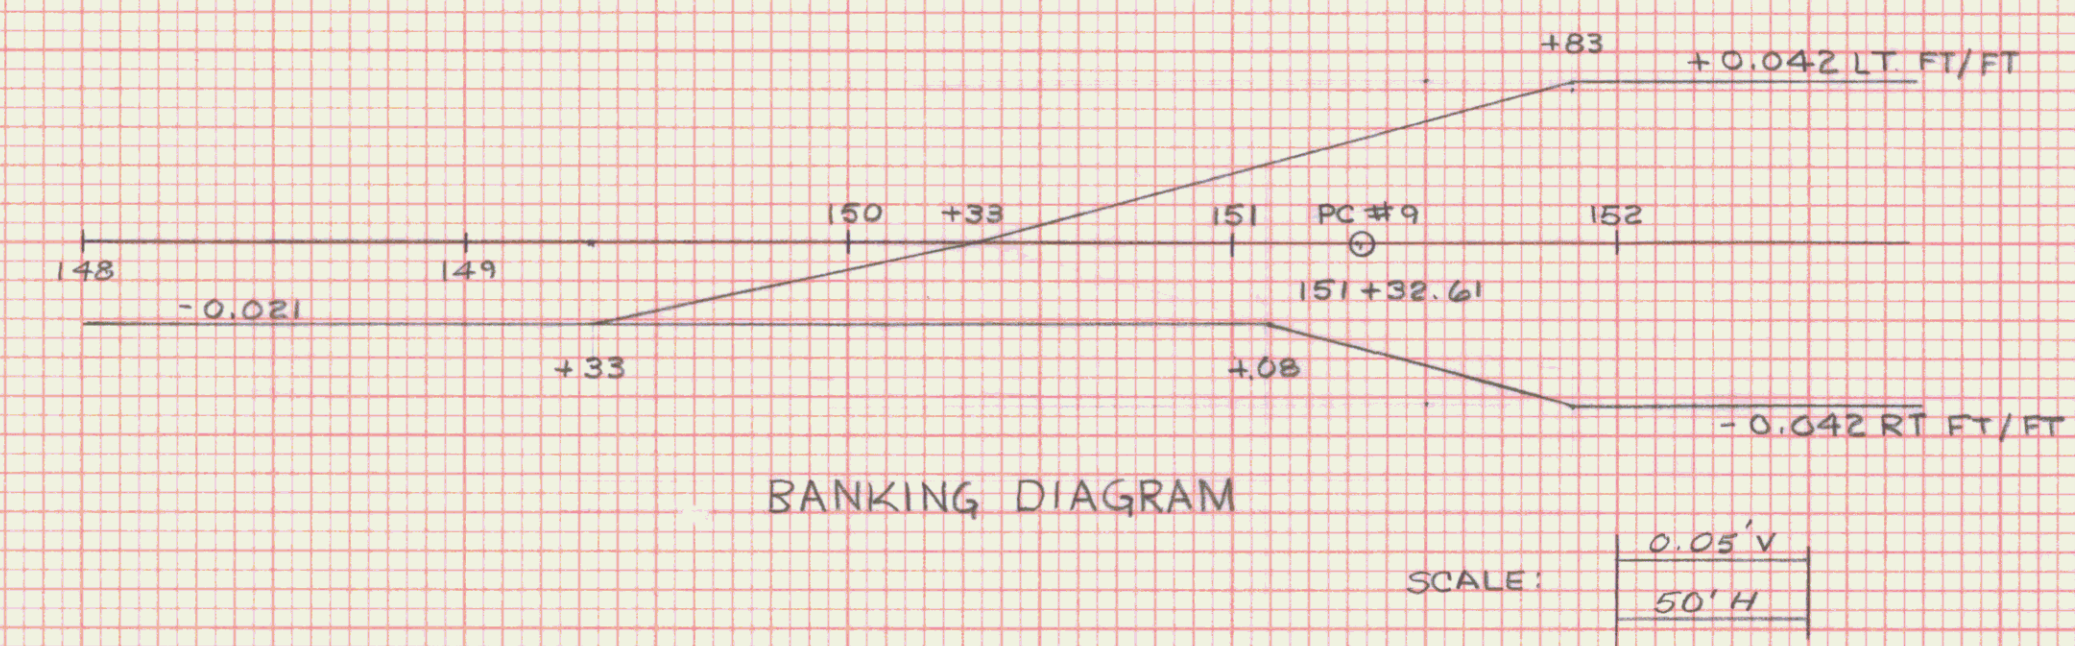

REV. STA. 148+70, LT
END STONE LINED DITCH,
TYPE II, 8' WIDE

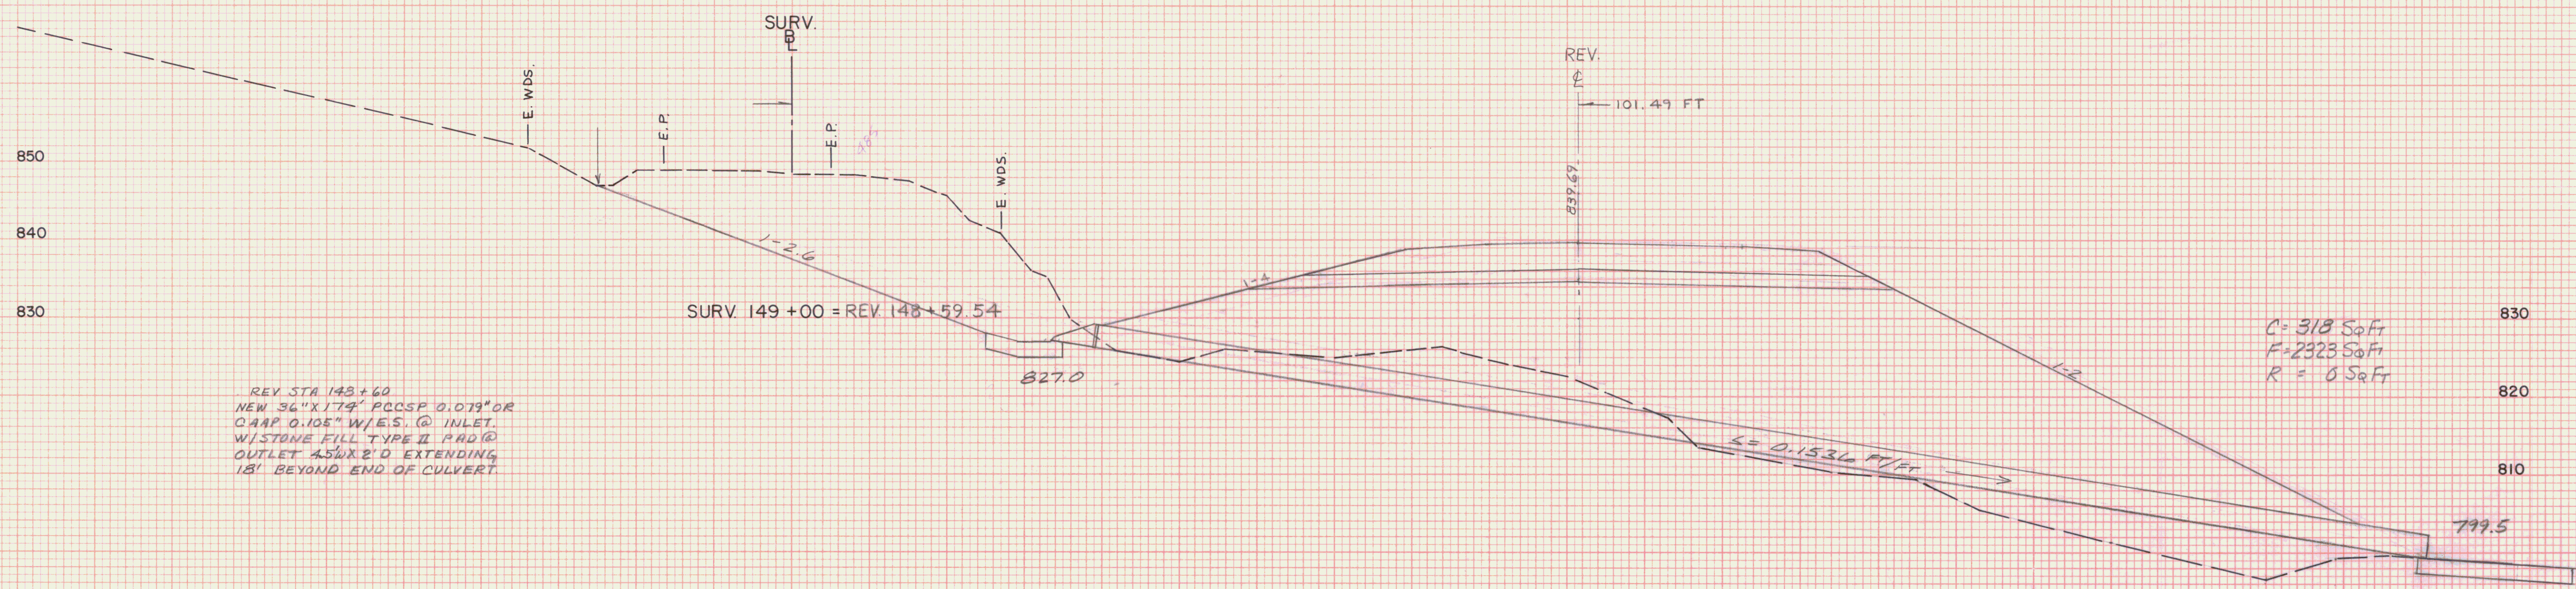

REV. STA. 143+60
NEW 36" X 17.9" PCCSP 0.079" OR
CAAP 0.105" W/E.S. @ INLET.
W/STONE FILL TYPE II PAD @
OUTLET 45" X 2' D EXTENDING
18' BEYOND END OF CULVERT.

C = 318 Sq Ft
F = 2323 Sq Ft
R = 0 Sq Ft

DATE	
BY	
SURVEYED	
PLOTTED	
NOTED	
AREAS CHECKED	
FINAL SURVEY	
NOTE BOOK	
NO.	

DATE	
BY	
SURVEYED	
PLOTTED	
NOTED	
AREAS CHECKED	
ORIGINAL SURVEY	
NOTE BOOK	
NO.	

STA. 149+00	STA.
TOWN MARSHFIELD	
PROJECT F	NO. 028-3(28)
SHEET 193	OF 243 SHEETS
HORIZ. AND VERT. SCALE	
0	10 20
VT. SURVEY	
SURVEYED BY: CONSULTANTS	DATE 10/86