



REV. STA. 152+09 LT
BEGIN REMOVAL & DISPOSAL
OF GUARD RAIL

POLE# 444
2149
15328
SURV. STA. 152+01

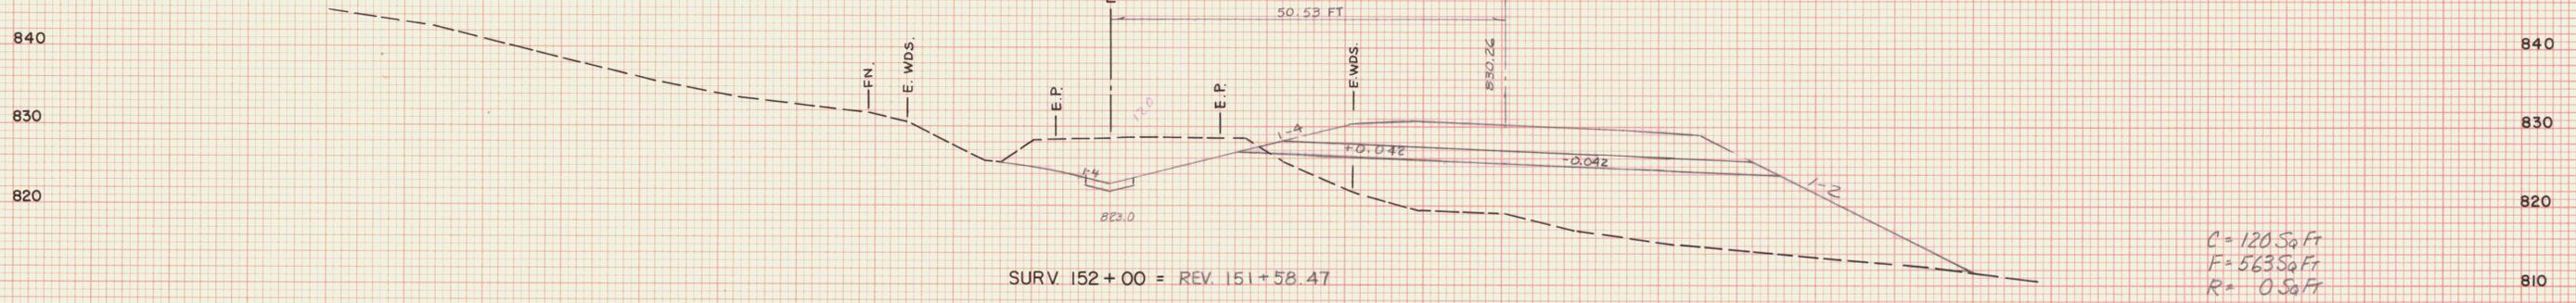

SURV. 152+00 = REV. 151+58.47

C = 120 Sq Ft
F = 563 Sq Ft
R = 0 Sq Ft

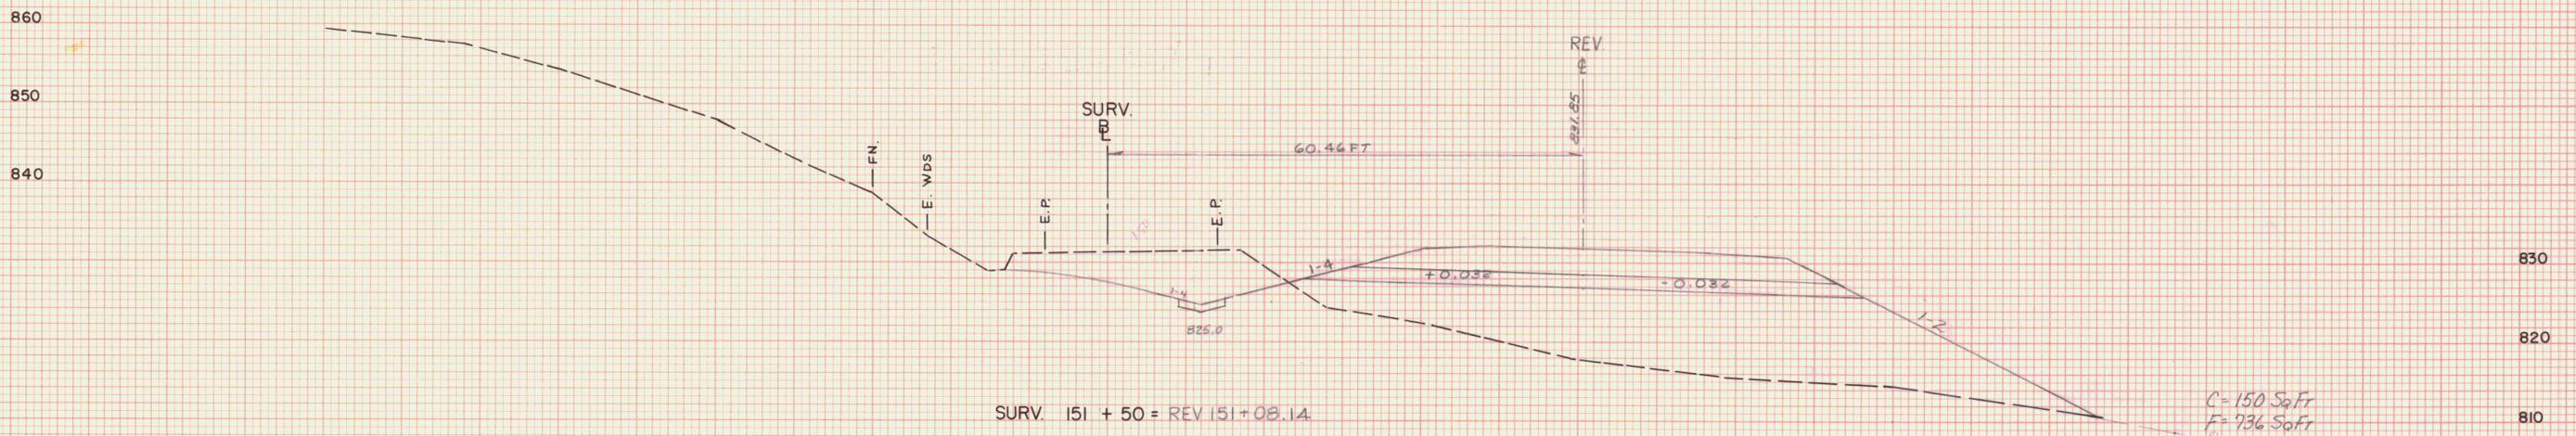

SURV. 151+50 = REV. 151+08.14

C = 150 Sq Ft
F = 736 Sq Ft
R = 0 Sq Ft

DATE _____
BY _____
NO. _____
FINAL SURVEY NOTE BOOK

DATE _____
BY _____
NO. _____
ORIGINAL SURVEY NOTE BOOK

STA. 151+50	STA. 152+00
TOWN MARSHFIELD	
PROJECT F	NO. 028-3(28)
SHEET 196	OF 302 SHEETS
HORIZ. AND VERT. SCALE	
0	10 20
VT. SURVEY	
SURVEYED BY: CONSULTANTS DATE 10/86	