


U.S. ROUTE 2
MARSHFIELD
F028-3(28)

VT. SURVEY CONSULT. 10/86
BRYANT ASSOC. 11/86

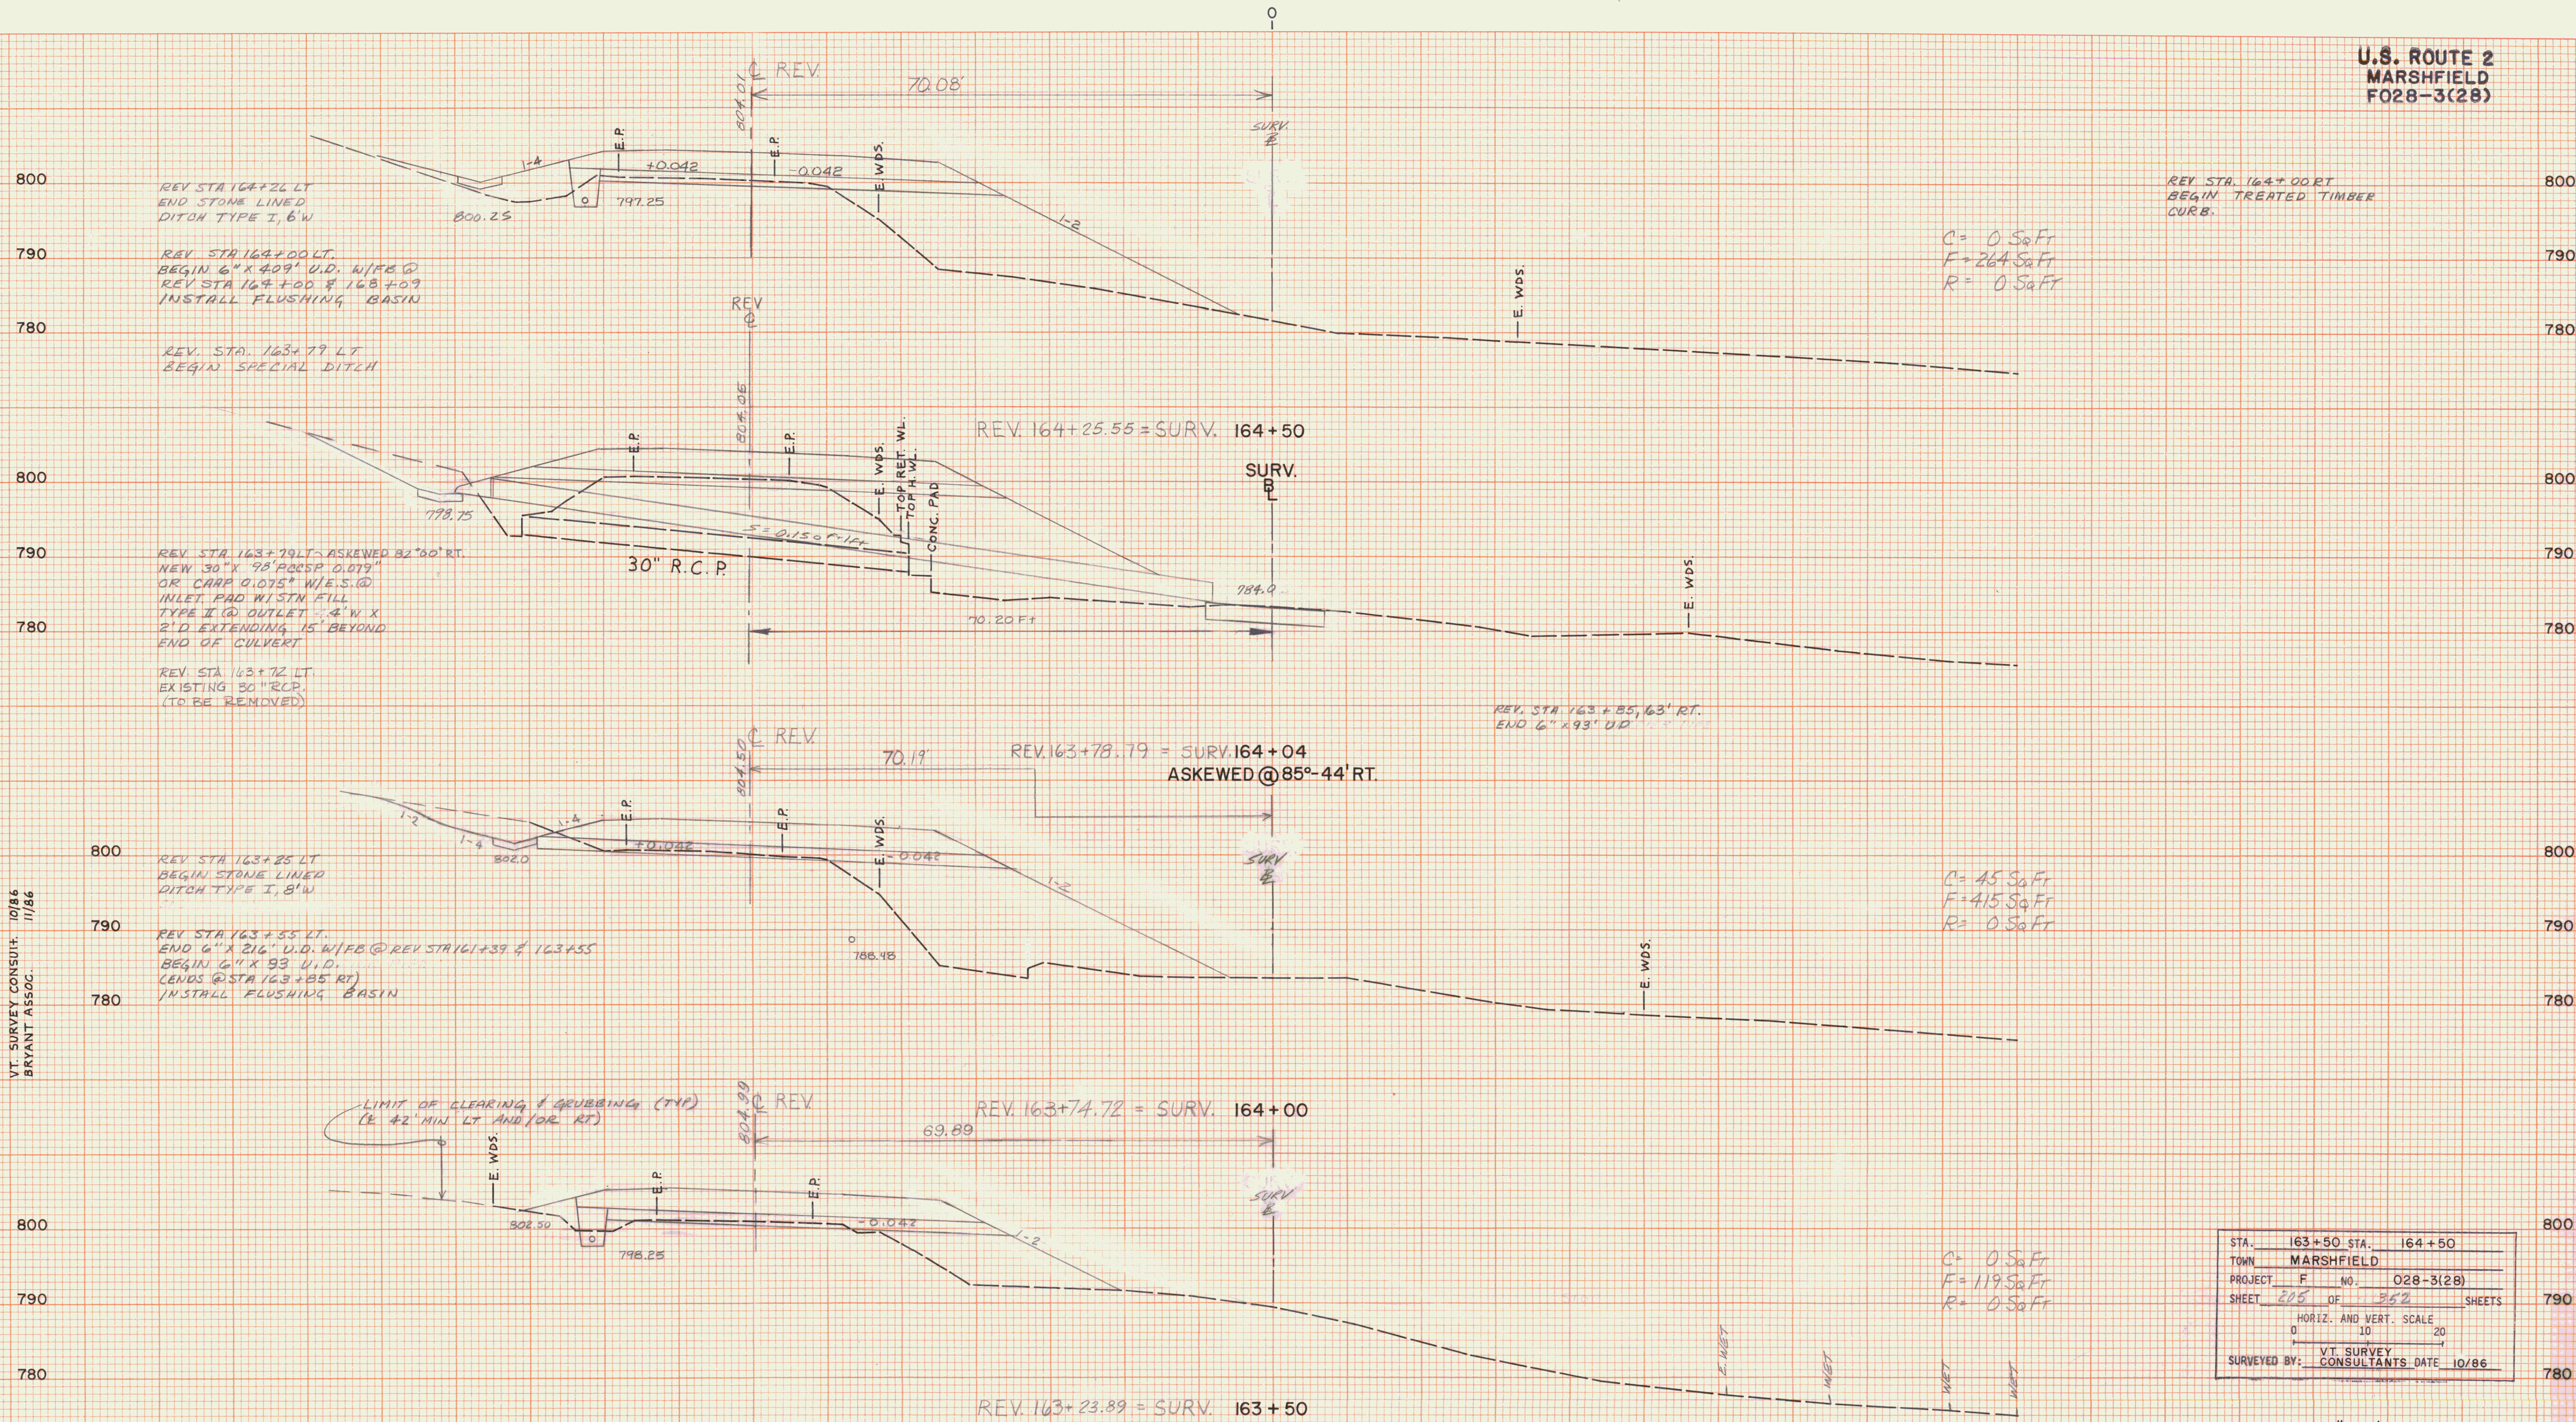

SCALE: 1"=10'
H&V

STA.	163+50	STA.	164+50
TOWN	MARSHFIELD		
PROJECT	F	NO.	028-3(28)
SHEET	205	OF	352
			SHEETS
HORIZ. AND VERT. SCALE			
0 10 20			
VT. SURVEY CONSULTANTS DATE 10/86			