


REV. STA 170+25
BEGIN SCARIFYING
EXISTING PAVEMENT

REV. STA 169+75 LT.
BEGIN STL BEAM GUARD RAIL
REV. STA 169+50 ~ 169+75 LT.
CONSTRUCT BREAKAWAY CABLE TERMINAL

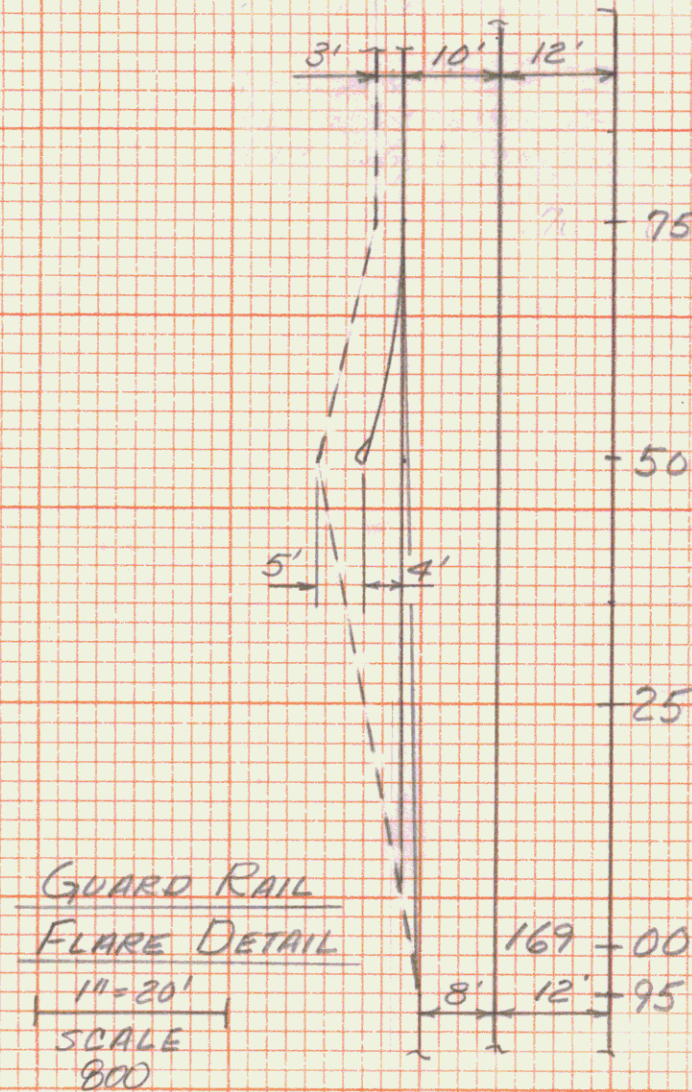

FLARE

SECTION A-A

REV. STA 168+84 LT.
CONSTRUCT DENE (14' WIDE)

REV. STA 168+30 LT.
BEGIN 6" x 24" U.D. W/F @
REV. STA 168+30 & 170+36
INSTALL FLUSHING BASIN

REV 169+85.38 = SURV. 170+00

REV 169+34.56 = SURV. 169+50

REV. 168+83.70 = SURV. 169+00

REV. 168+32.81 = SURV. 168+50

C= 36 Sq Ft
F= 598 Sq Ft
R= 0 Sq Ft

C= 93 Sq Ft
F= 356 Sq Ft
R= 0 Sq Ft

C= 346 Sq Ft
F= 0 Sq Ft
R= 0 Sq Ft

C= 266 Sq Ft
F= 205 Sq Ft
R= 0 Sq Ft

STA.	168+50	STA.	170+00
TOWN	MARSHFIELD		
PROJECT	F	NO.	028-3(28)
SHEET	203	OF	352 SHEETS
HORIZ. AND VERT. SCALE			
0 10 20			
VT SURVEY CONSULTANTS DATE 10/86			

SCALE 1"=10'
H & V