
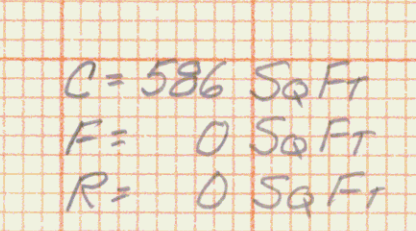
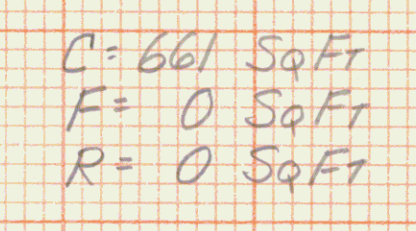
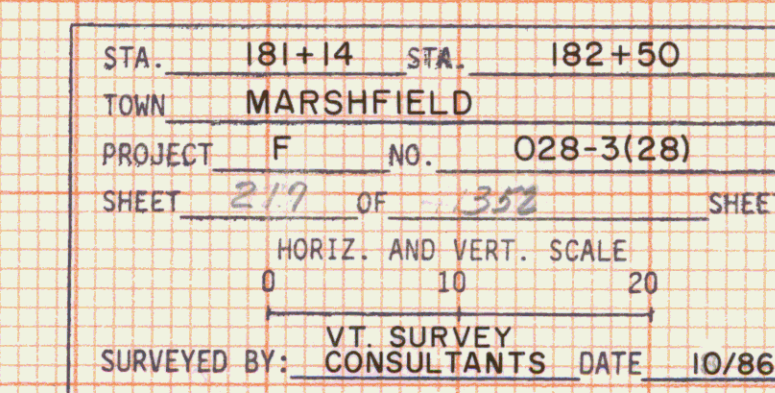


$$\begin{aligned} C &= 703 \text{ Sg Ft} \\ F &= 0 \text{ Sg Ft} \\ R &= 0 \text{ Sg Ft} \end{aligned}$$


STA 181+50 LT.
END STONE LINED DICH
TYPE I, 6' WIDE
BEGIN EROSION MATTING

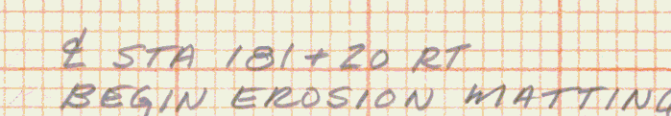

SCALE: $\frac{I' = 10}{H \& V}$