


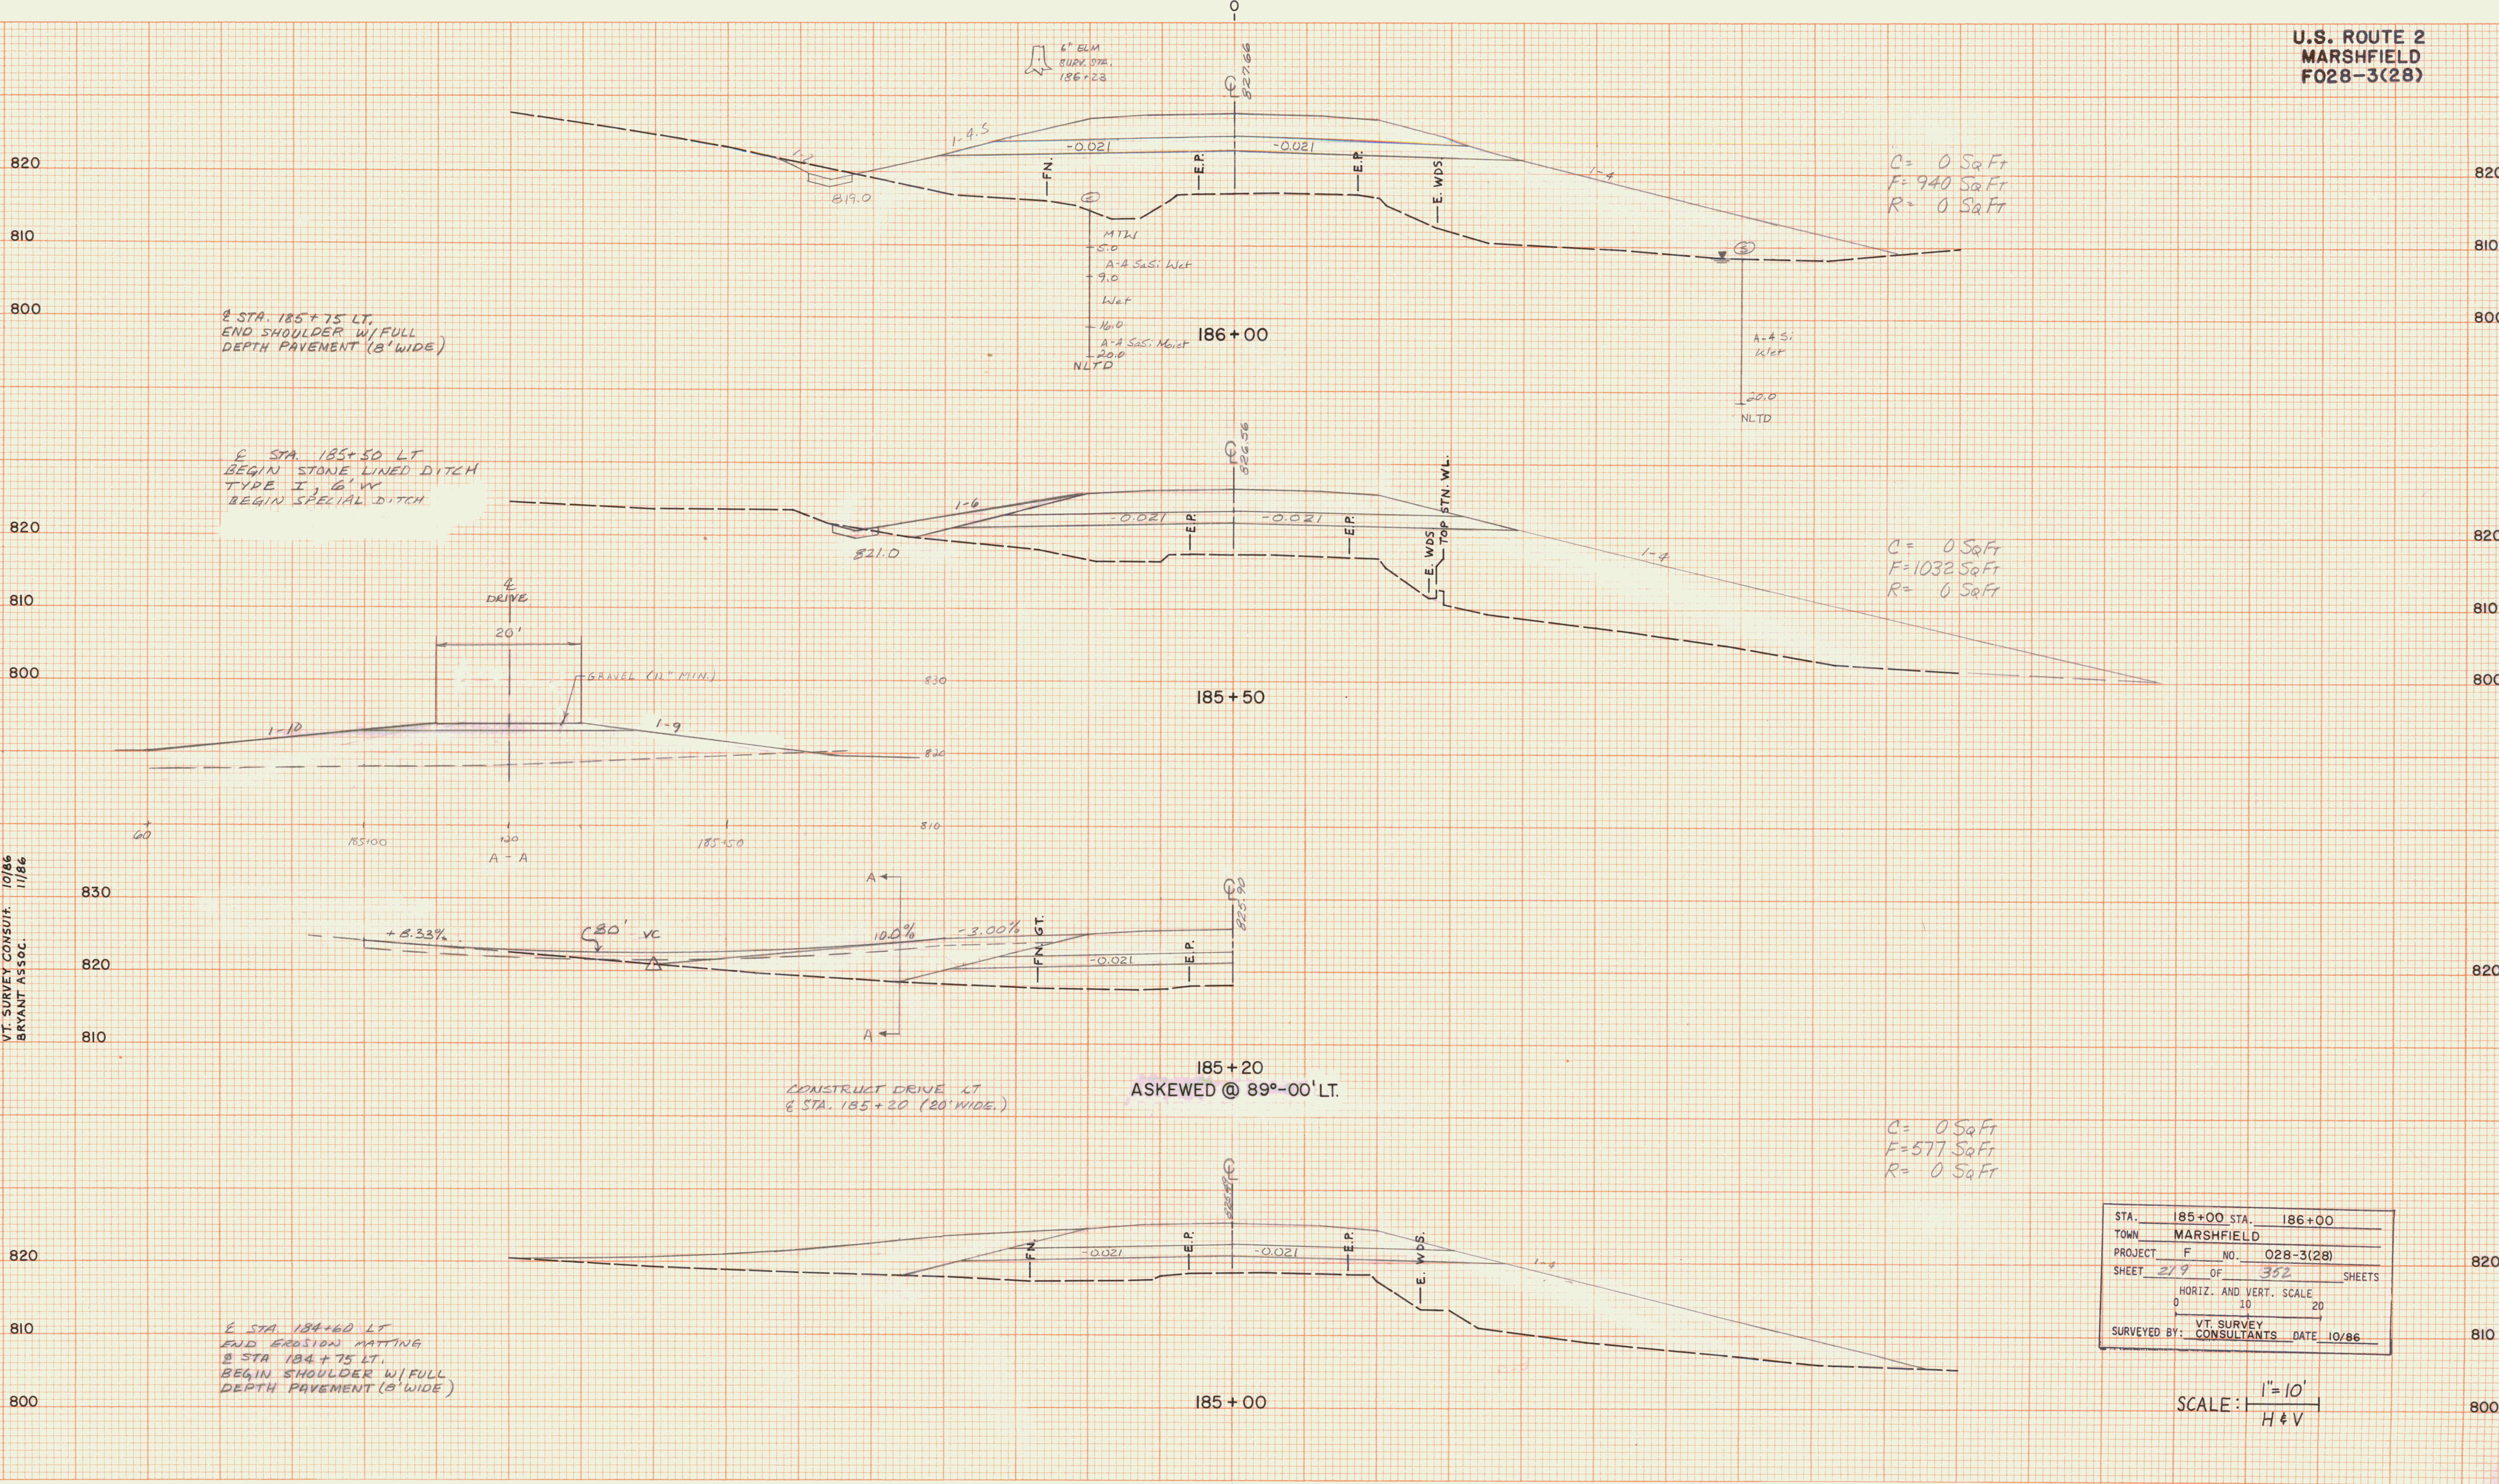

VT. SURVEY CONSULTANTS
BRYANT ASSOC.
10/86
11/86

STA.	185+00	STA.	186+00
TOWN	MARSHFIELD		
PROJECT	F	NO.	028-3(28)
SHEET	219	OF	392
SHEETS			
HORIZ. AND VERT. SCALE			
0 10 20			
VT. SURVEY CONSULTANTS			
DATE 10/86			

SCALE: 1"=10'
H & V