
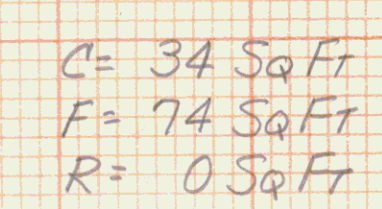
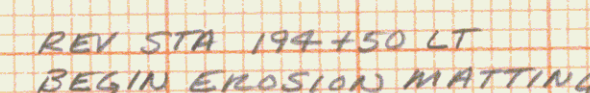
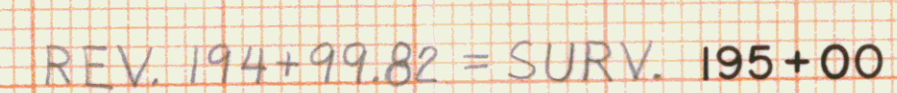
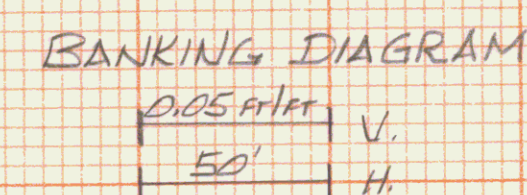


U.S. ROUTE
MARSHFIELD
F028-3(28)

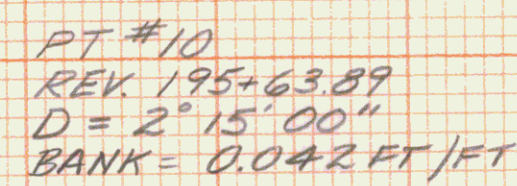

STA. 194+00 STA. 195+50
TOWN MARSHFIELD
PROJECT F NO. 028-3(28)
SHEET 225 OF 352 SHEET
HORIZ. AND VERT. SCALE
0 10 20
VT. SURVEY
SURVEYED BY: CONSULTANTS DATE 10/86

SCALE: $1'' = 10'$