

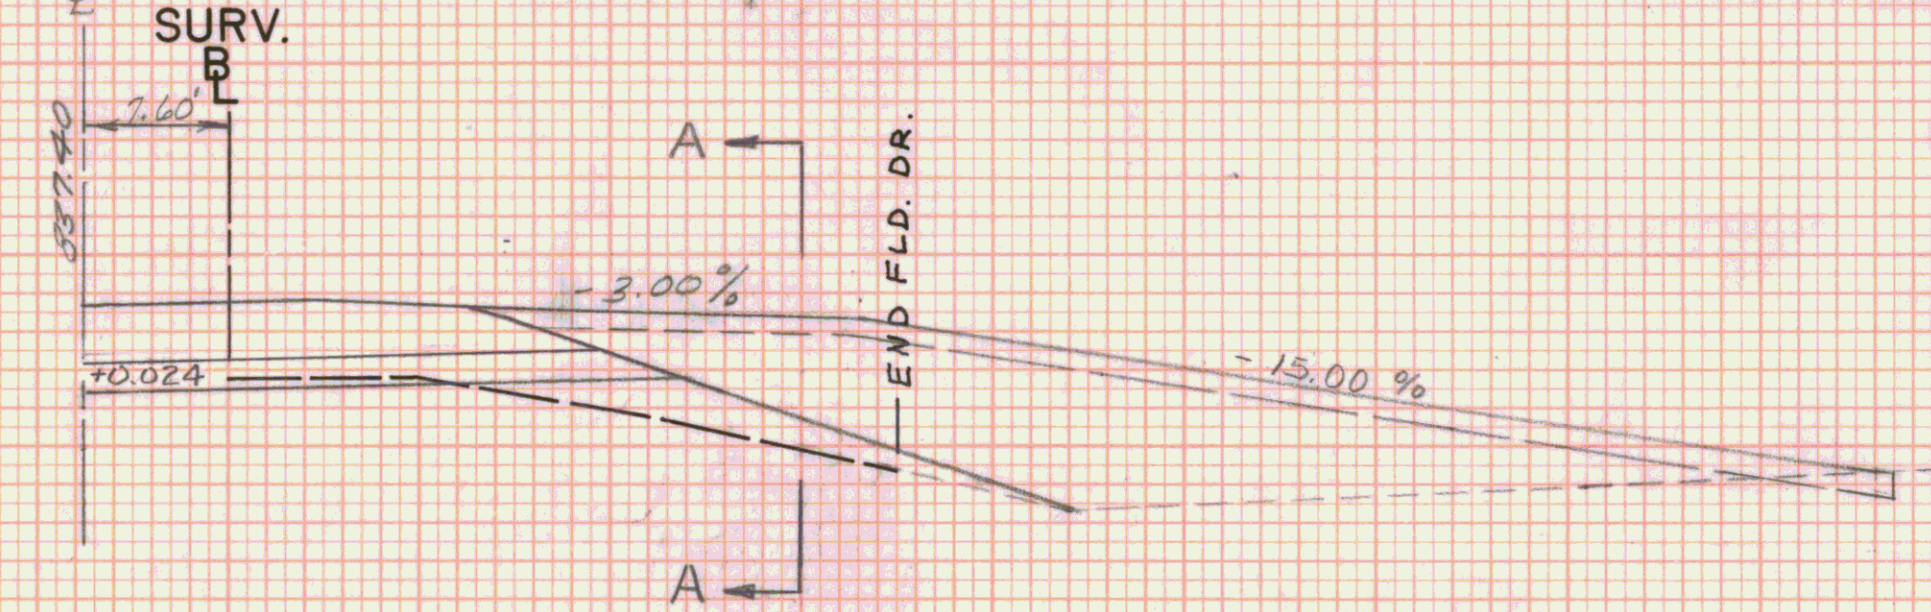


DATE	BY	SURVEYED	PLANNED	AREA	AREA CHECKED
FINAL SURVEY NOTE BOOK No.					

DATE	BY	SURVEYED	PLANNED	AREA	AREA CHECKED
4/87					
VT. SURVEY CONSULTANTS ASSOC.					
ORIGINAL SURVEY NOTE BOOK No.					

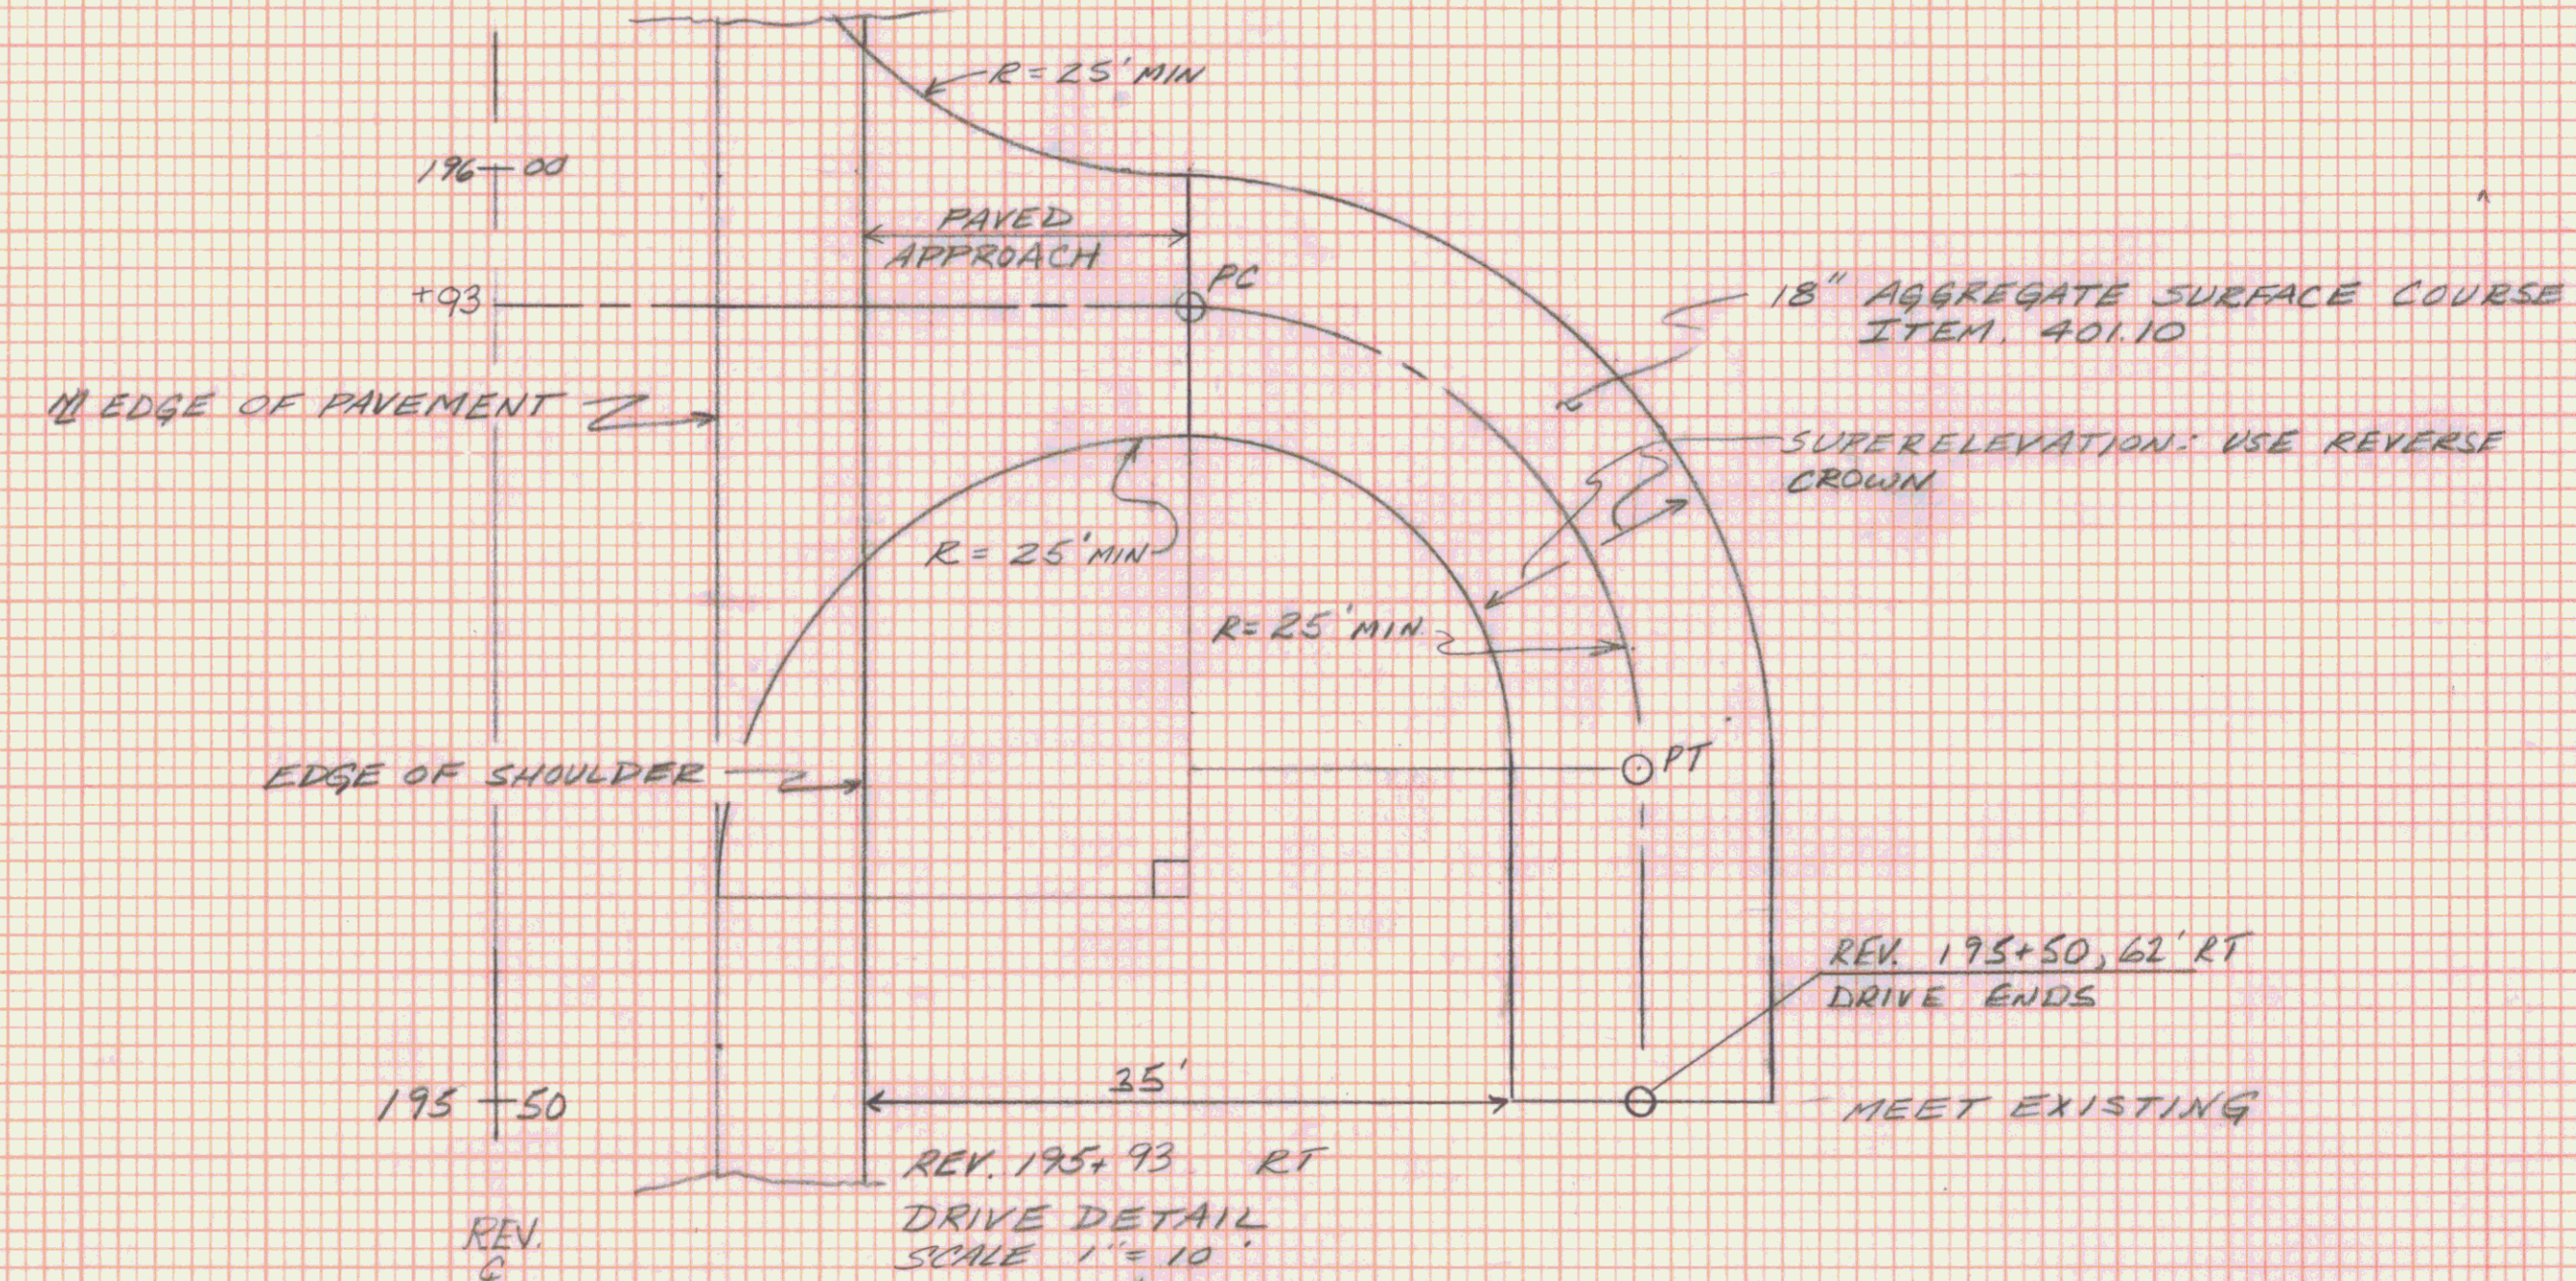

REV. 195+92.61 = SURV 195+91

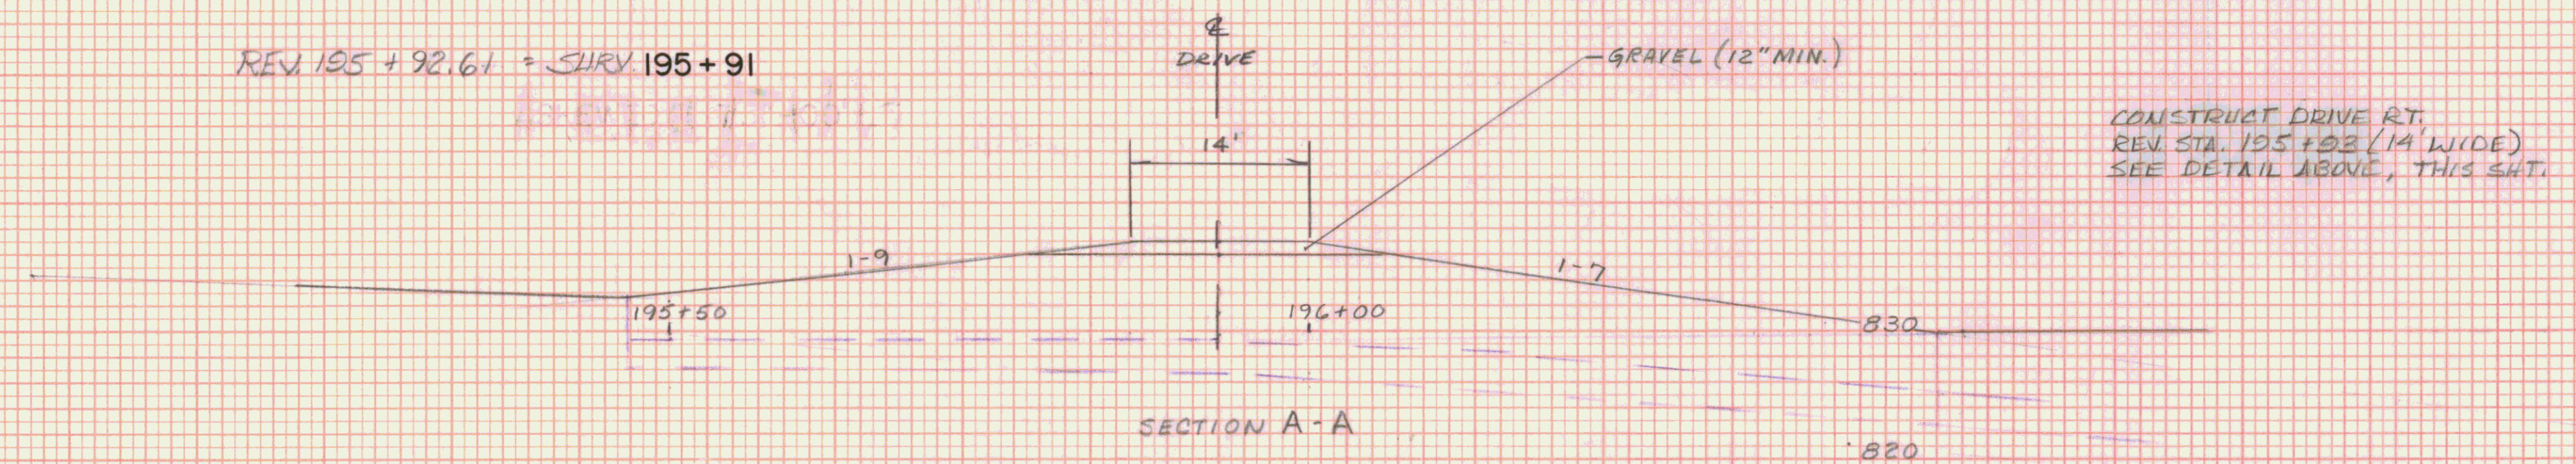

STA.	195+91	STA.	
TOWN	MARSHFIELD		
PROJECT	F	NO.	028-3(28)
SHEET	226	OF	352
SHEETS			
HORIZ. AND VERT. SCALE			
0 10 20			
VT. SURVEY CONSULTANTS			
DATE 4/87			